


SEE 17-D

PECK - WADSWORTH 2452.78

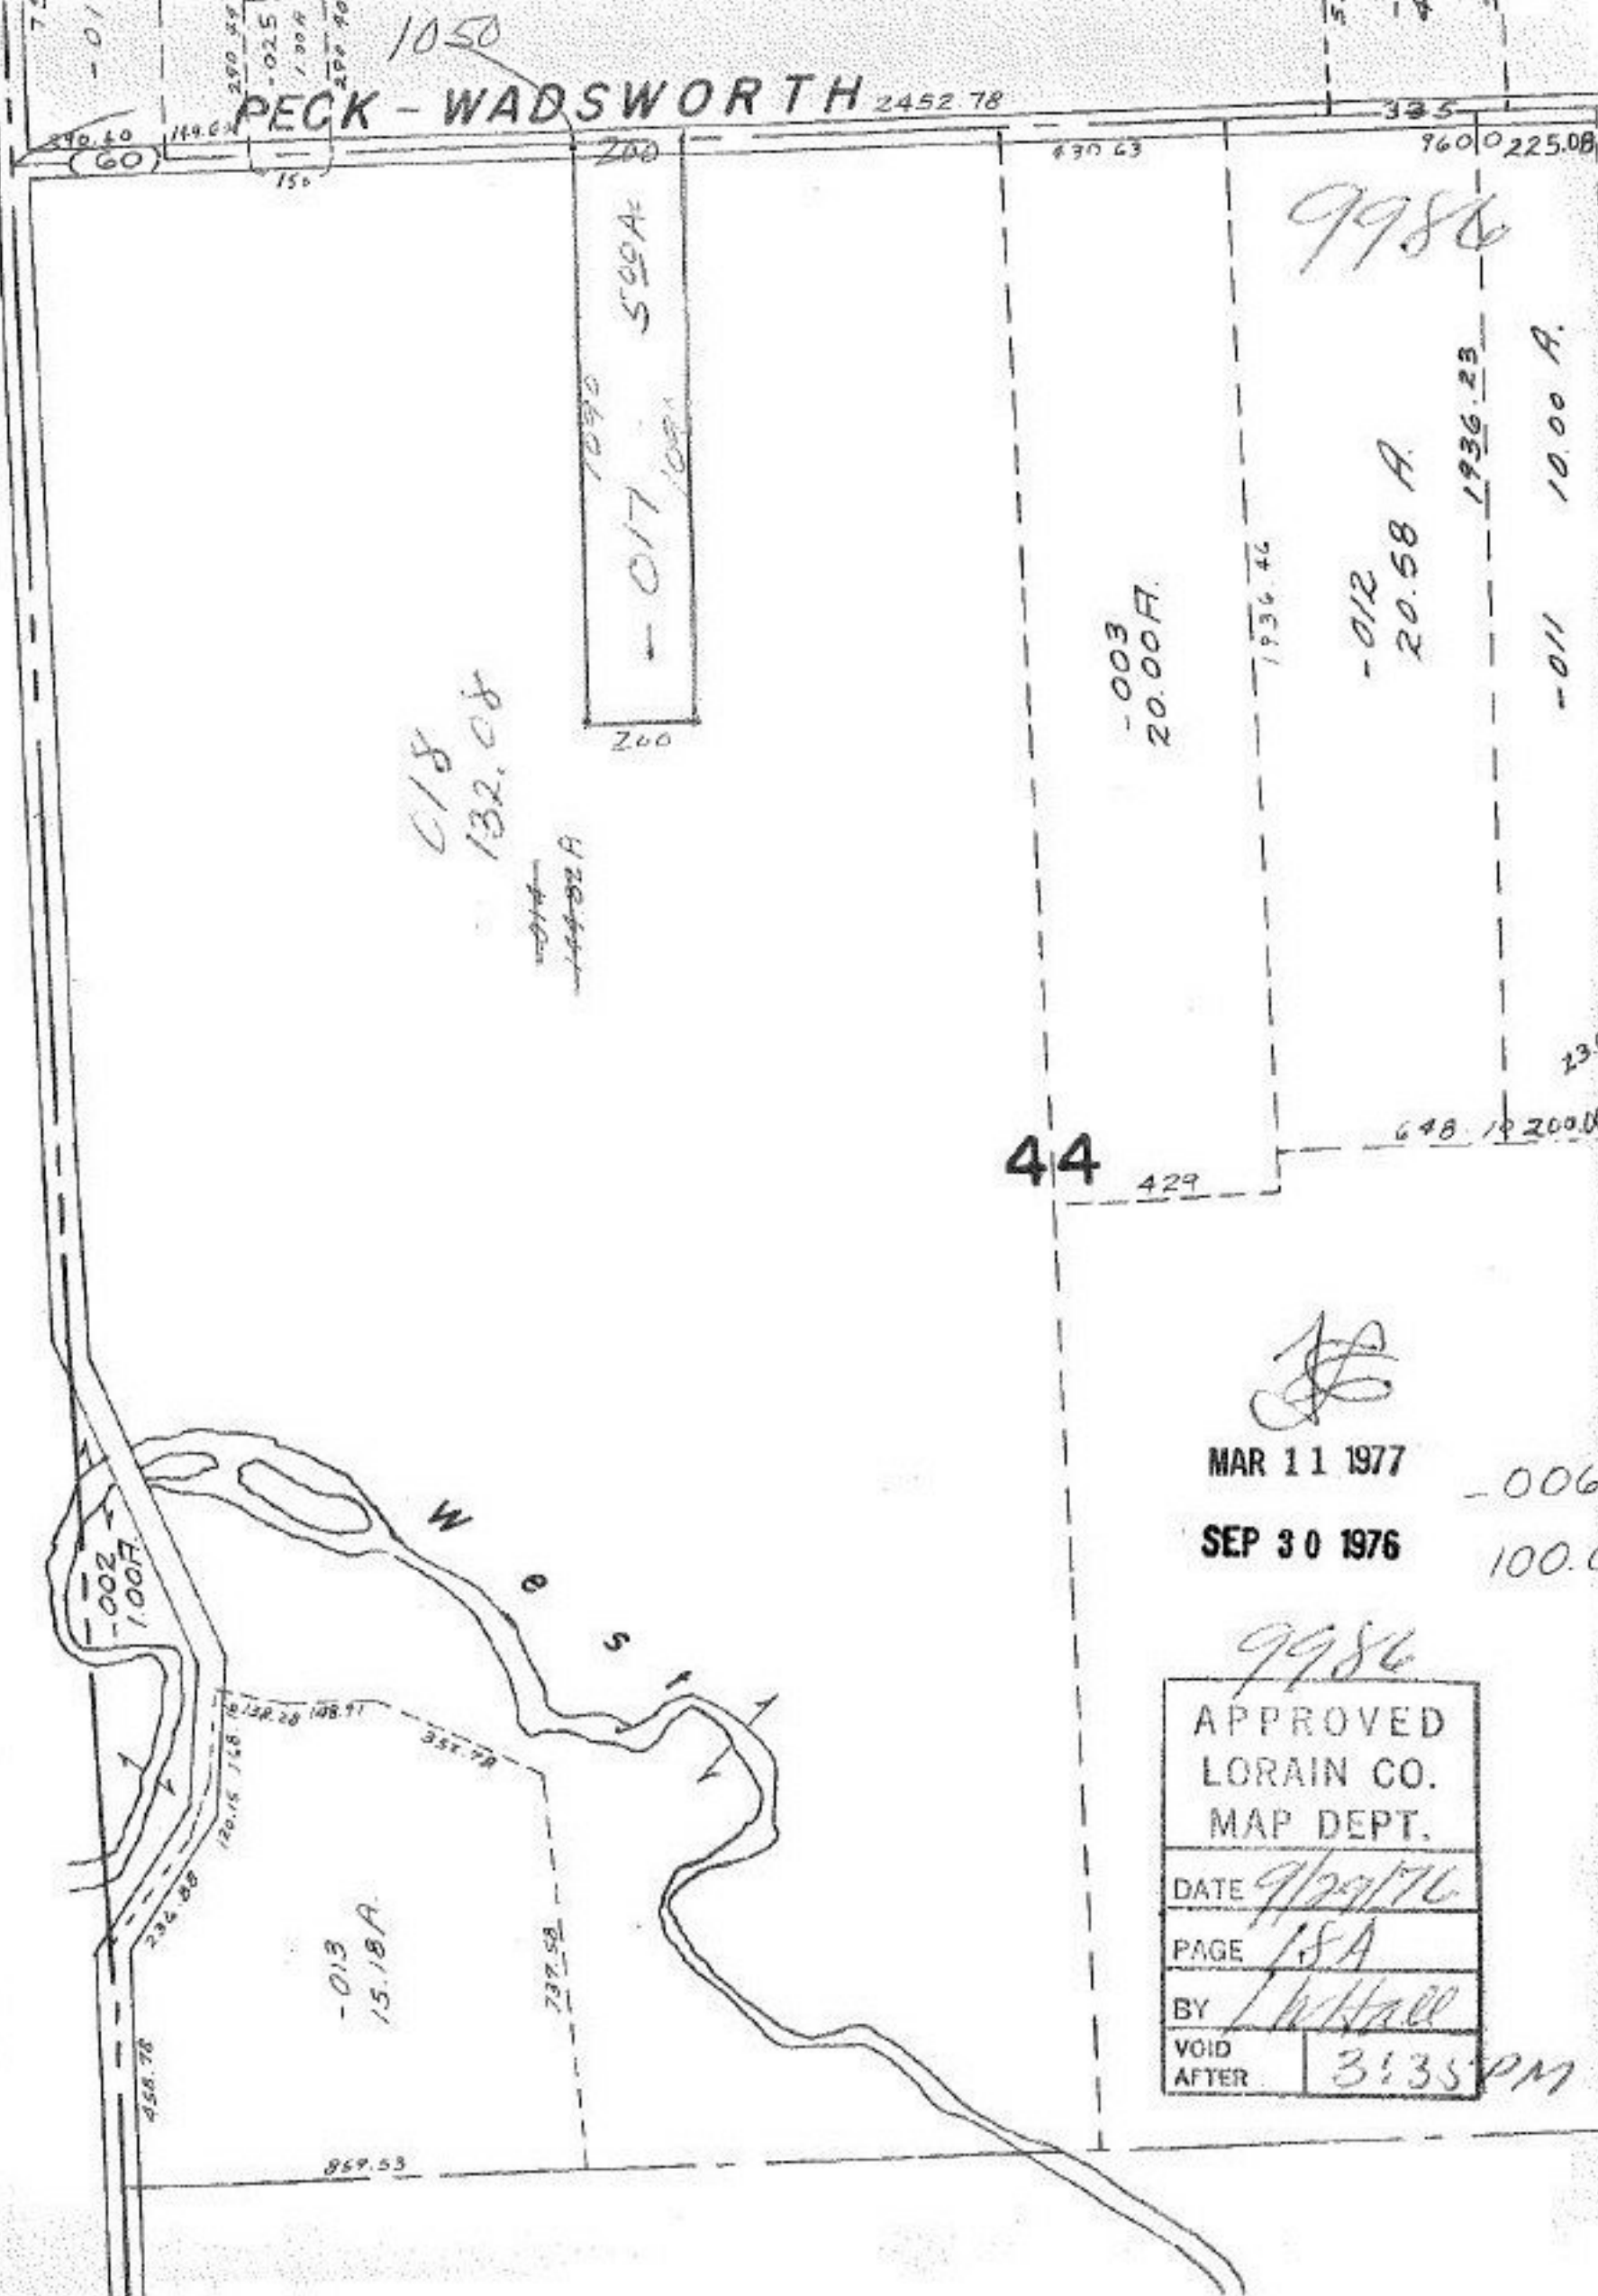

9986

018
132.08

200
-017 500 AC
1090
1080
200

-003
20.00 A.

-012
20.58 A.

-011
10.00 A.

44

MAR 11 1977

SEP 30 1976

| | |
|-------------------------------------|---------|
| APPROVED LORAIN CO. MAP DEPT. | |
| DATE | 9/29/76 |
| PAGE | 15A |
| BY | L. Hall |
| VOID AFTER | 3:35 PM |

-013
15.18 A.

-006
100.00