


See 1/2 00-041B

Voided  
12/1/76

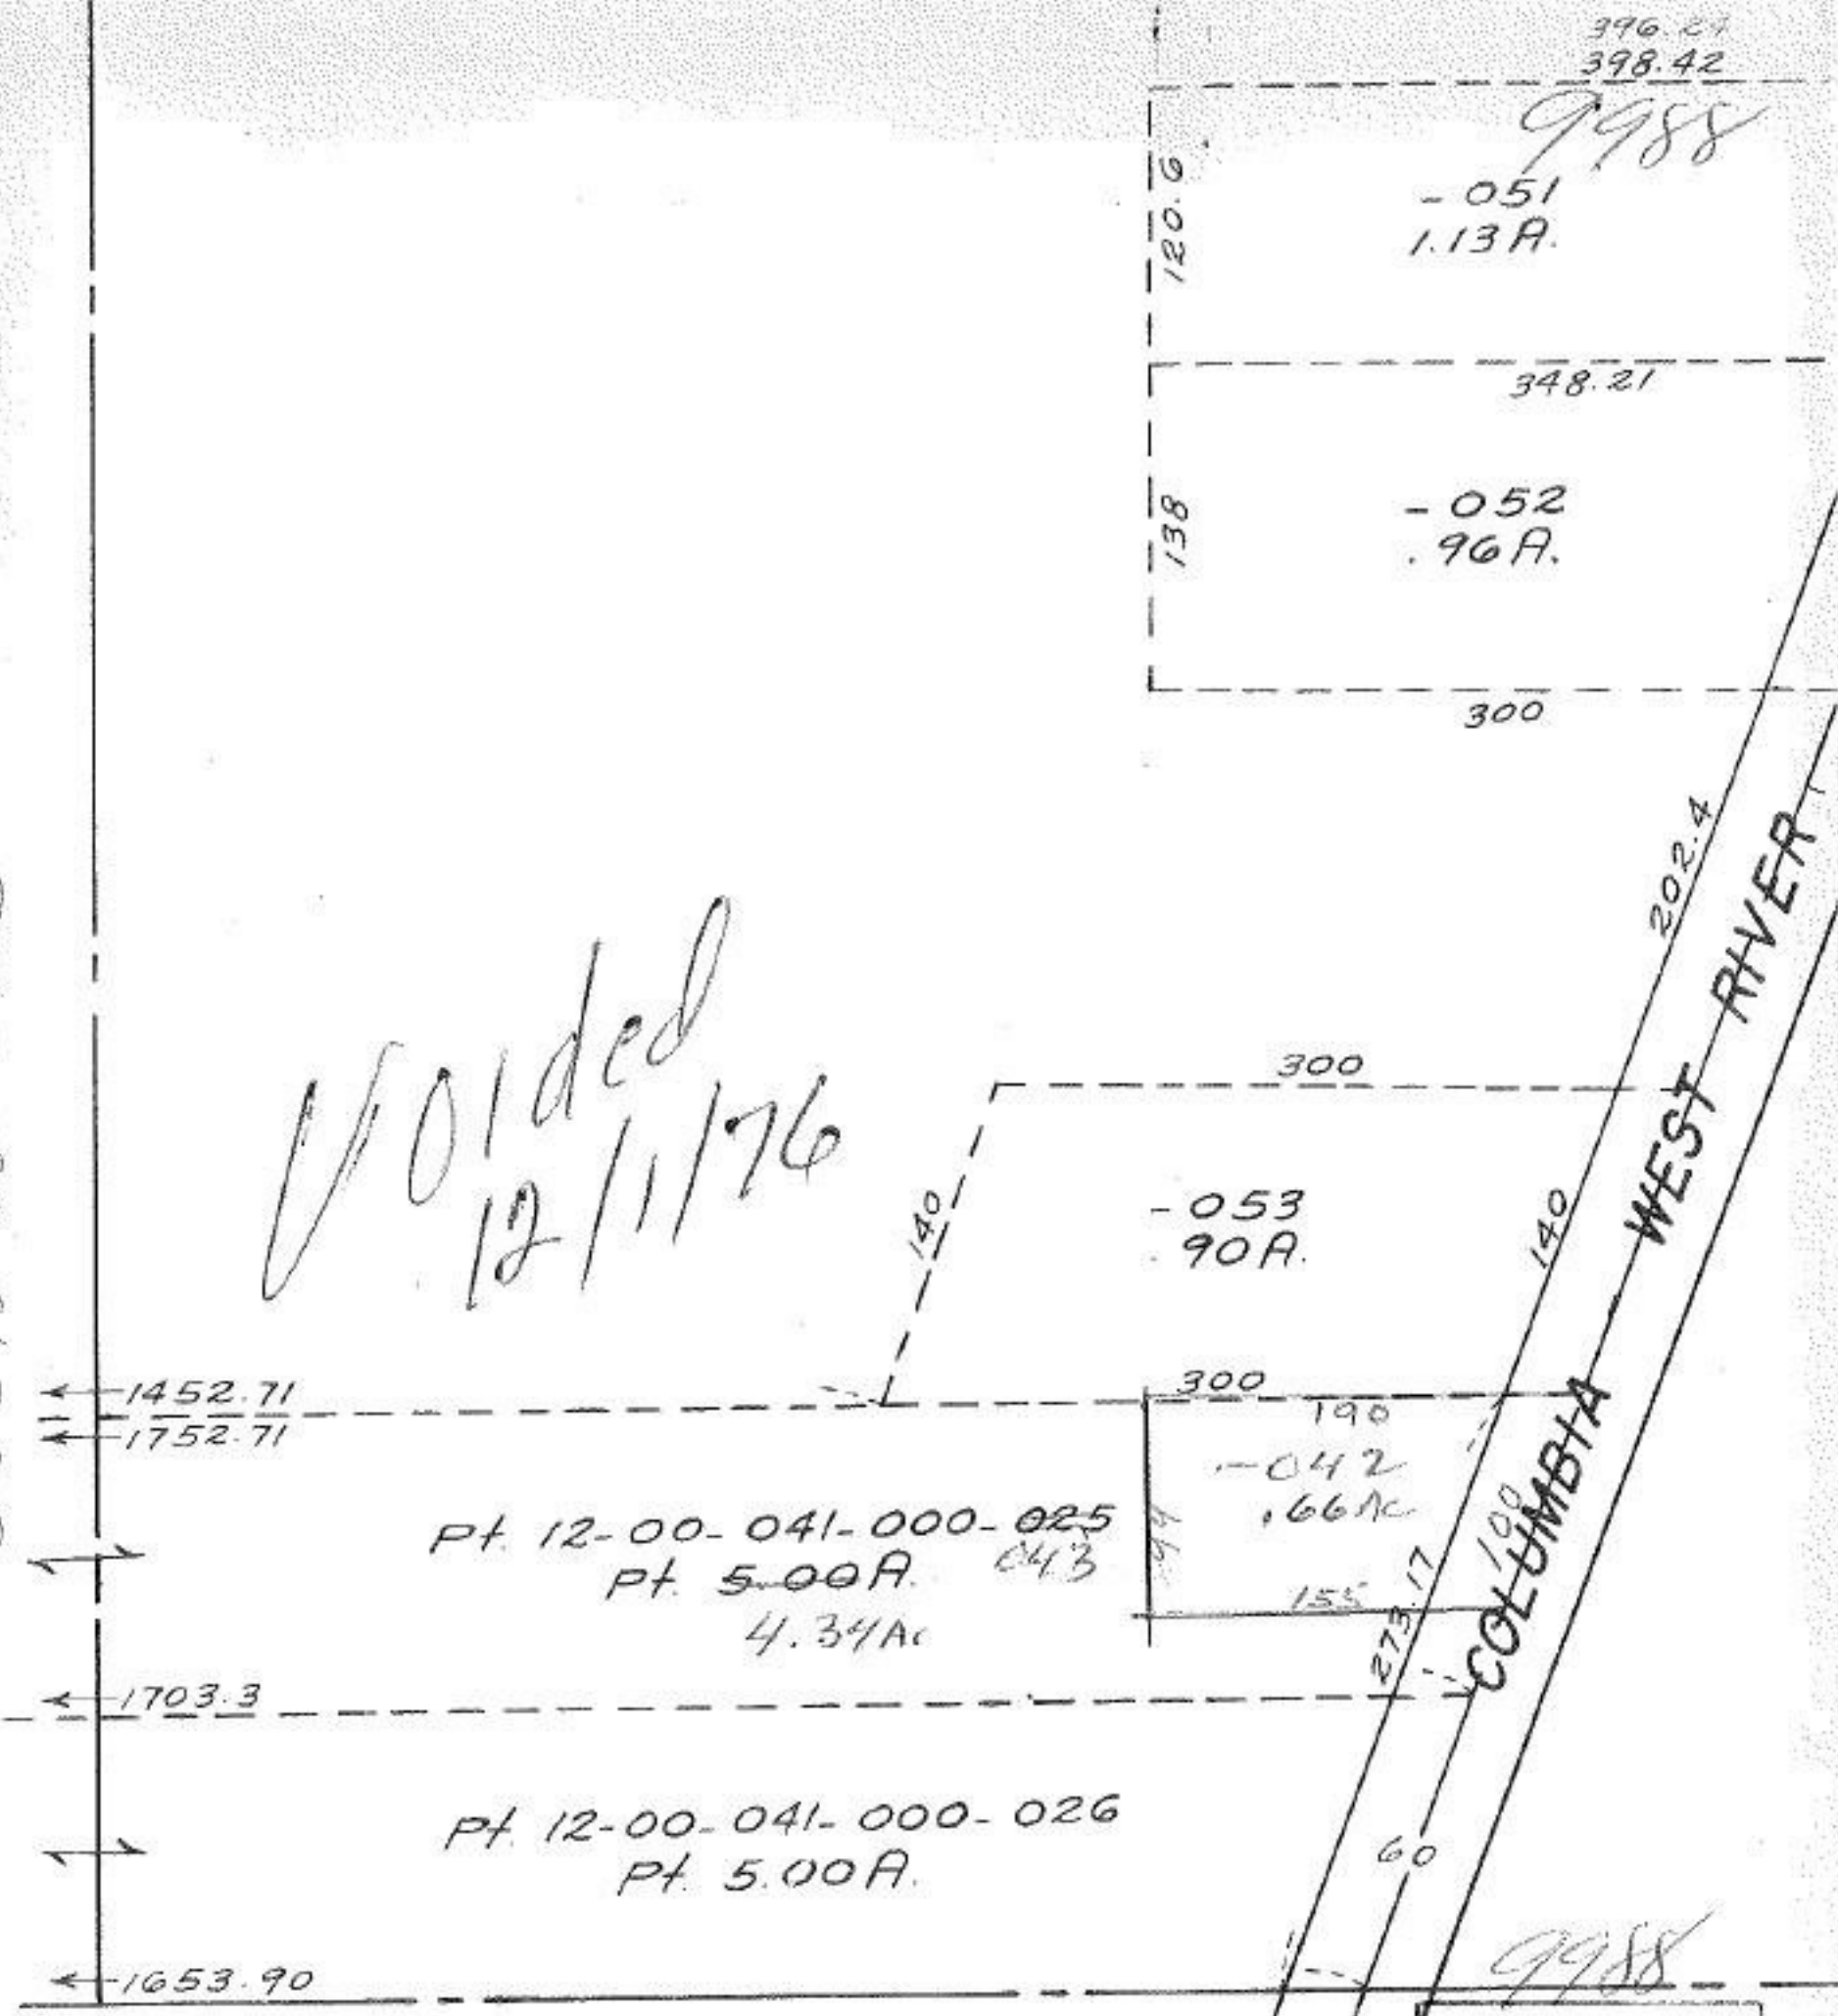

# COLUMBIA TWP.

SCALE: 1" = 100'

APPROVED LORAIN CO. MAP DEPT.	
DATE	9/30/76
PAGE	1200-0401
BY	L. Hoffel
VOID AFTER	4:30

SEE