
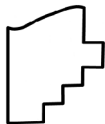
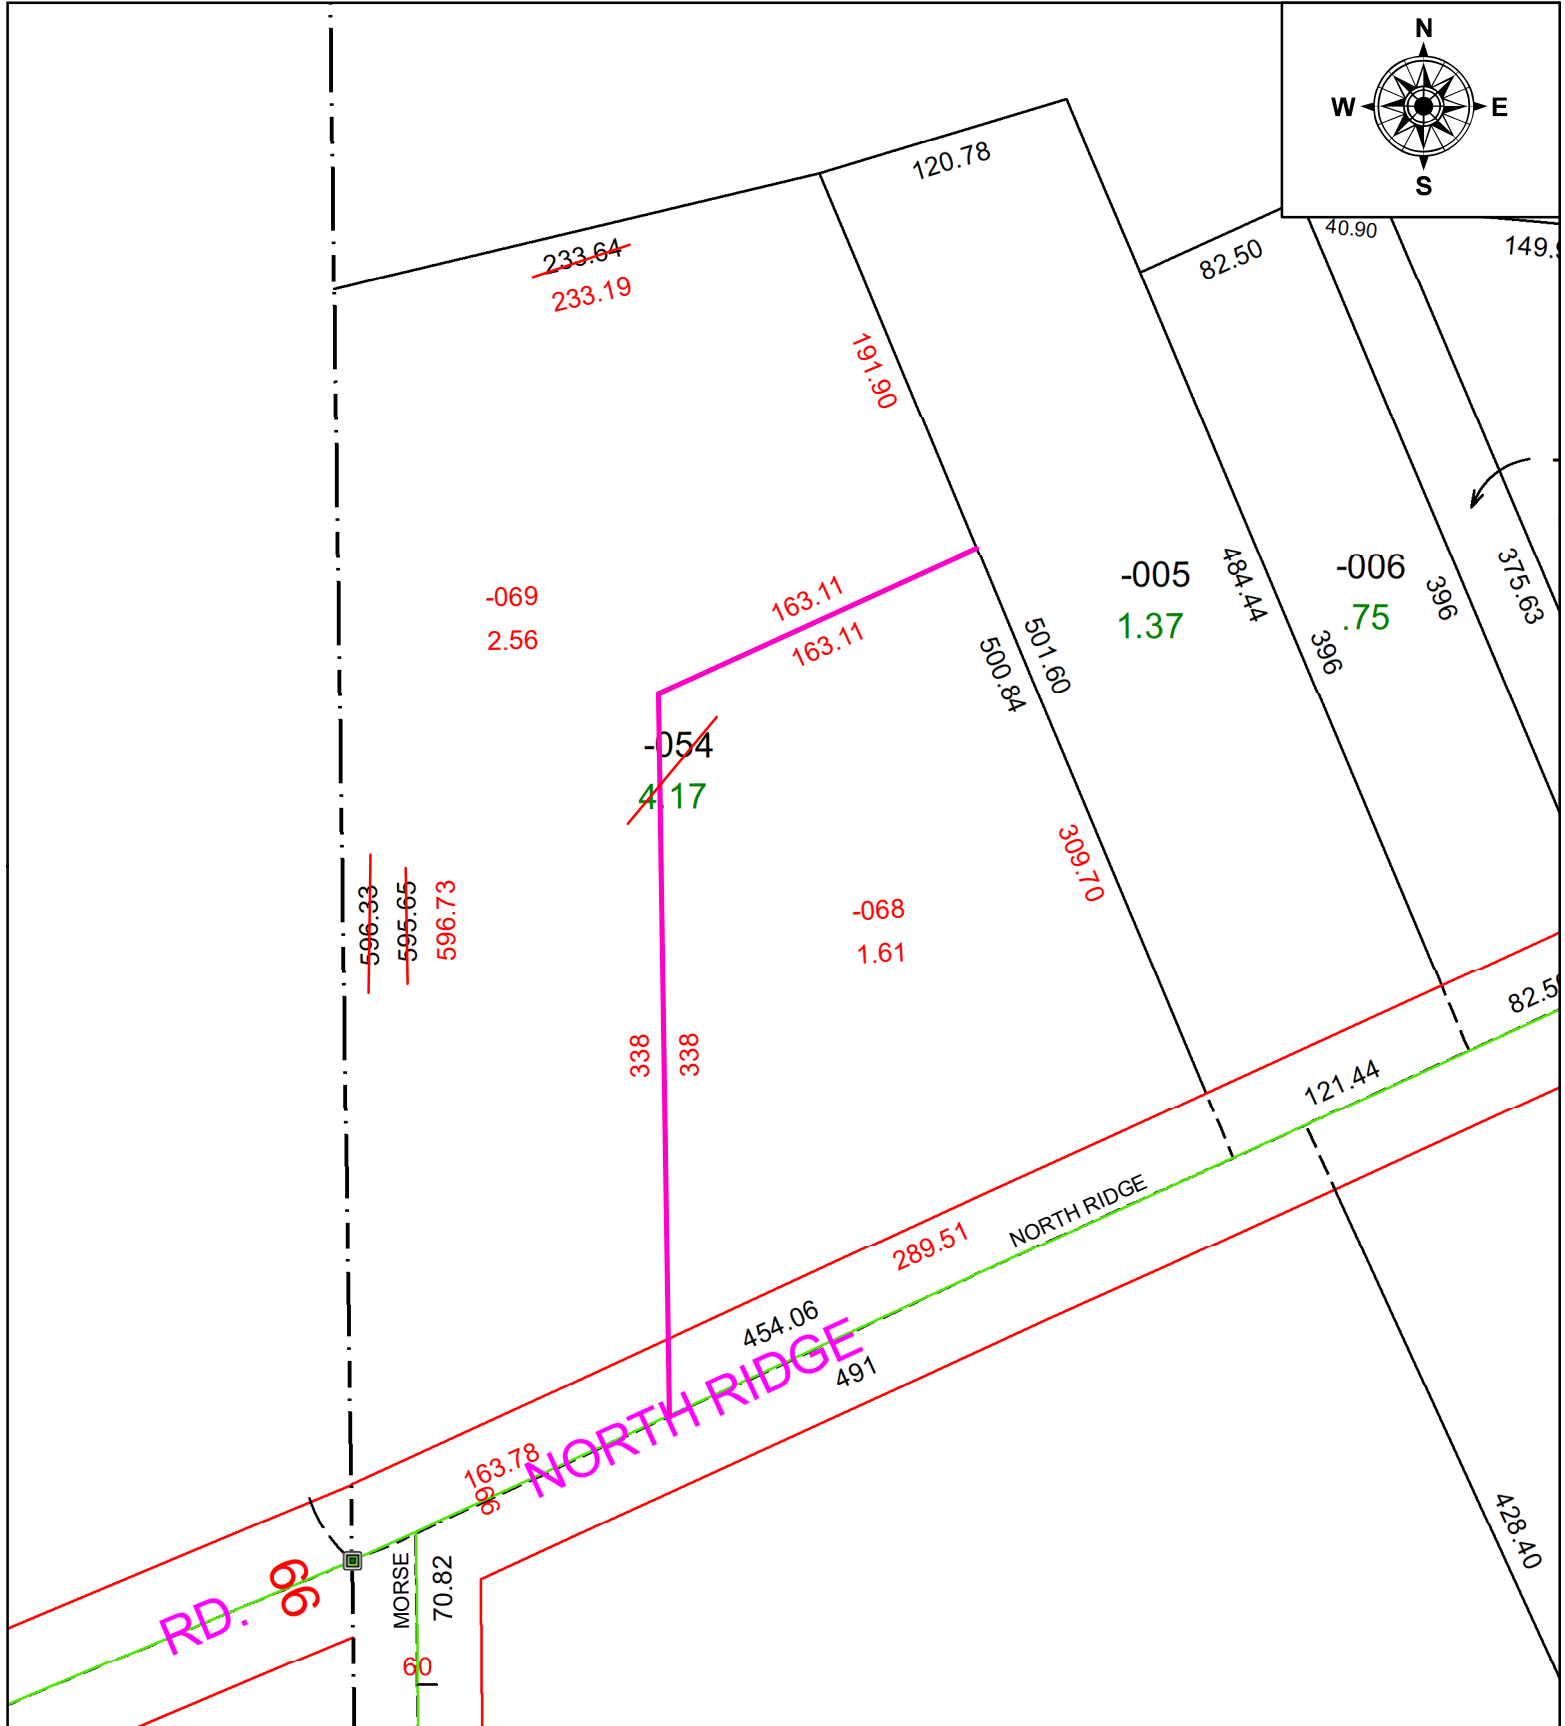


PARENT PARCEL: 01-00-051-000-054

CHILD PARCEL: 01-00-051-000-068 & -069

25-04962

STARTING POINT: INTERSECTION NORTH RIDGE RD AND WESTERLY LINE OF ORIGINAL LOT 51

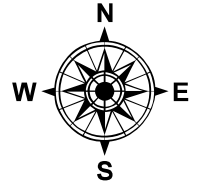

SPLITS/DEEDS PROCESSED
 LORAIN COUNTY TAX MAP DEPARTMENT
 226 MIDDLE AVE. ELYRIA, OH

SURVEYED BY: JOHN A. DECHANT JR **SURVEY #:** 51373
CLOSURE: 1: 179212
MAP PAGE(S): 01-00-051
APPROVED BY: BB **DATE:** 1/21/2025
SCALE: 1" = 90' **PRIOR INSTRUMENT:** #20240020172