
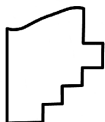


PARENT PARCEL: 09-00-097-000-048 & -092

CHILD PARCEL: 09-00-097-000-097, -098, & -099

STARTING POINT: C/L OF OBERLIN AND PARSONS RD

25-04963

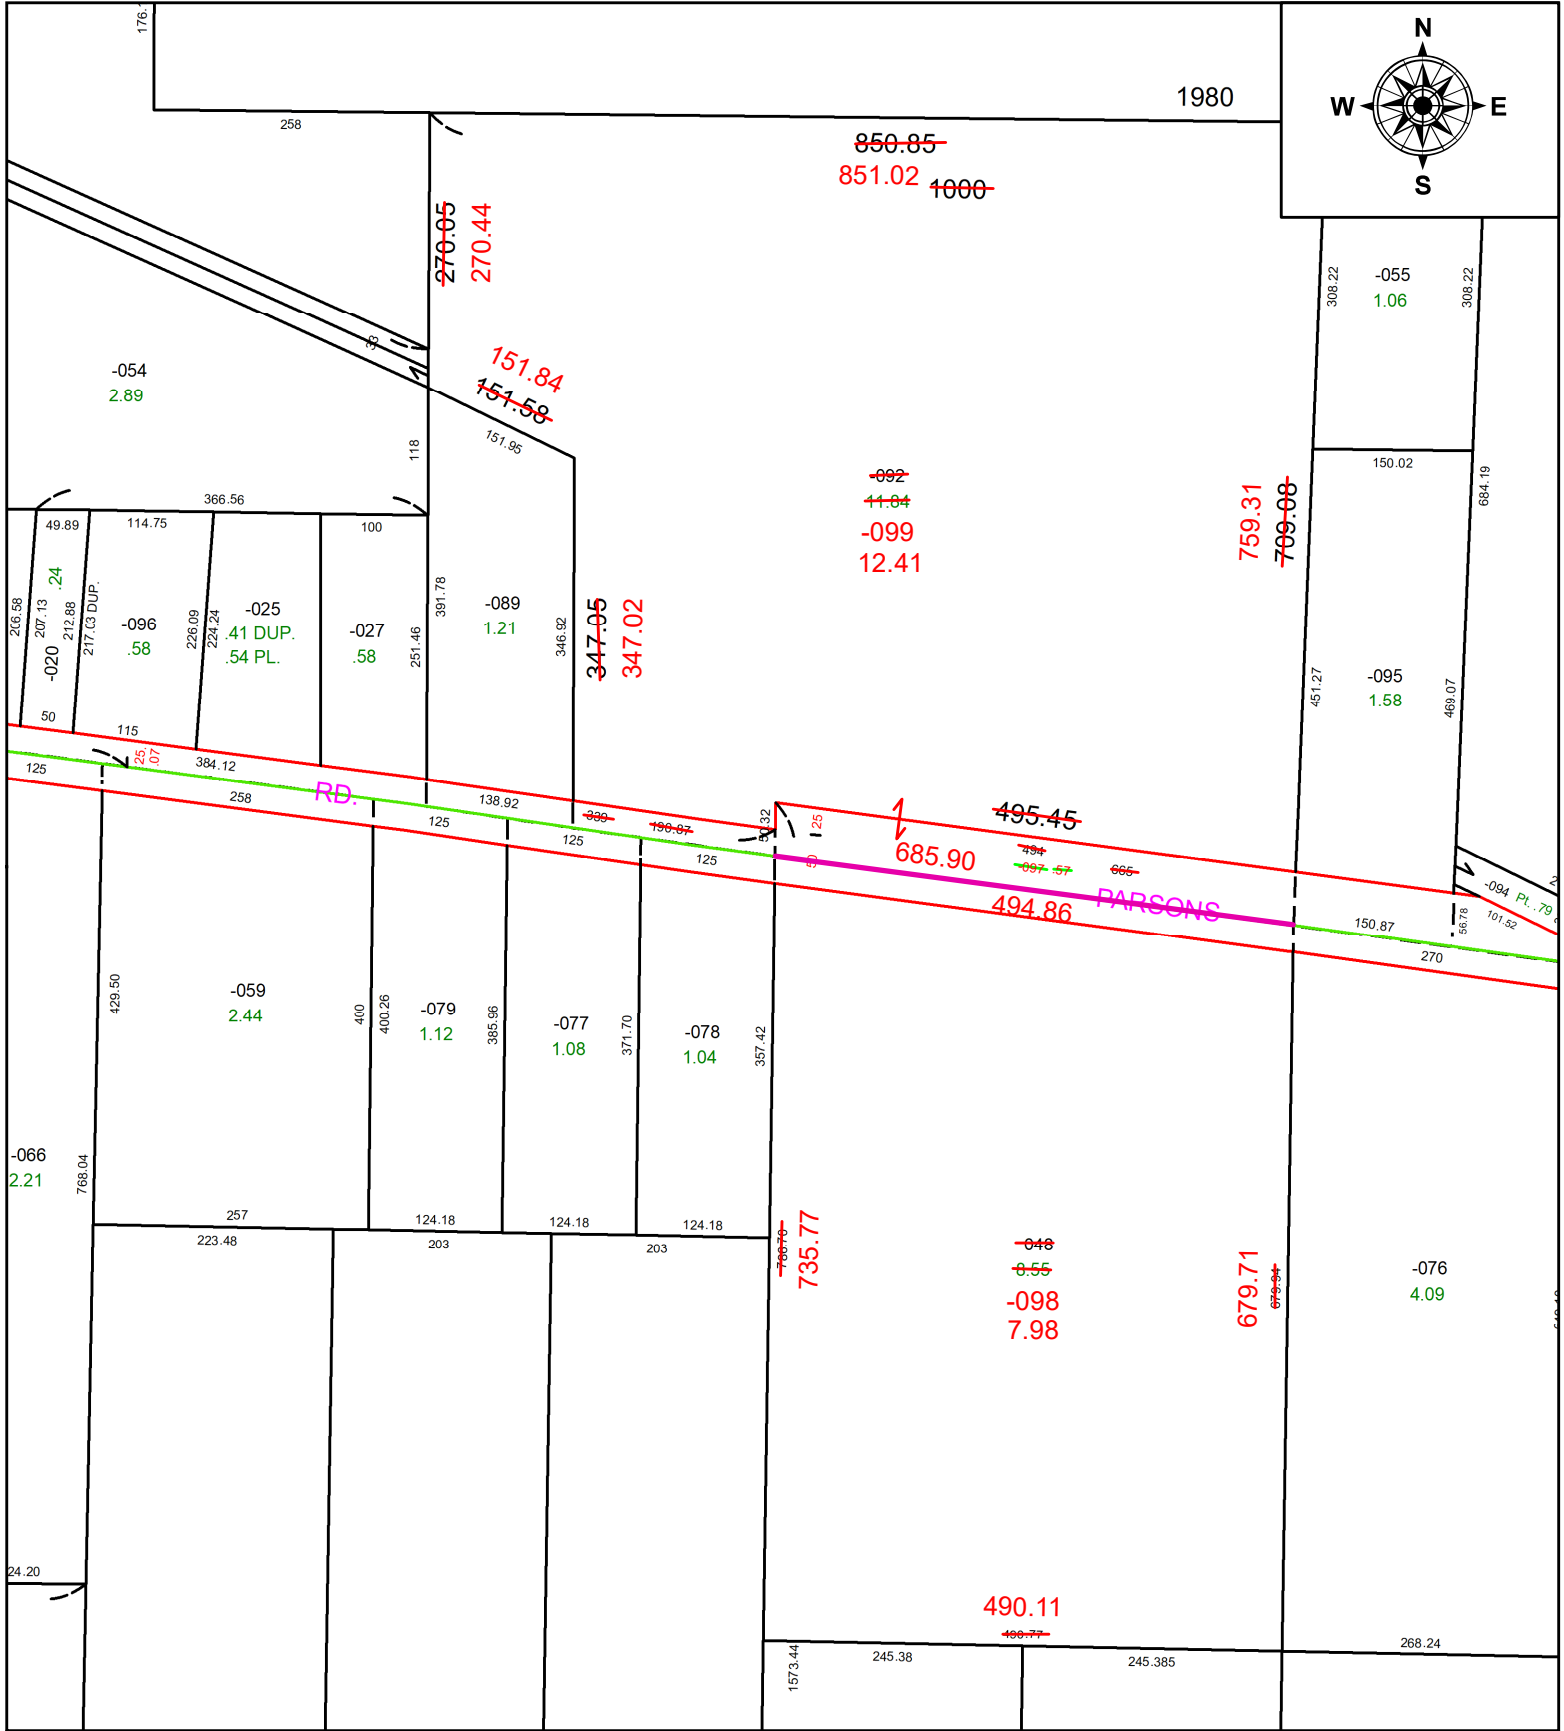

SPLITS/DEEDS PROCESSED
 LORAIN COUNTY TAX MAP DEPARTMENT
 226 MIDDLE AVE. ELYRIA, OH

SURVEYED BY: WILFREDO BARBOSA **SURV # 51375**
CLOSURE: 1: 237281
MAP PAGE(S): 09-00-097
APPROVED BY: AC **DATE:** January 21, 2025
SCALE: 1 in = 180 ft **PRIOR INSTRUMENT:** 1985- 0180462