
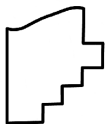
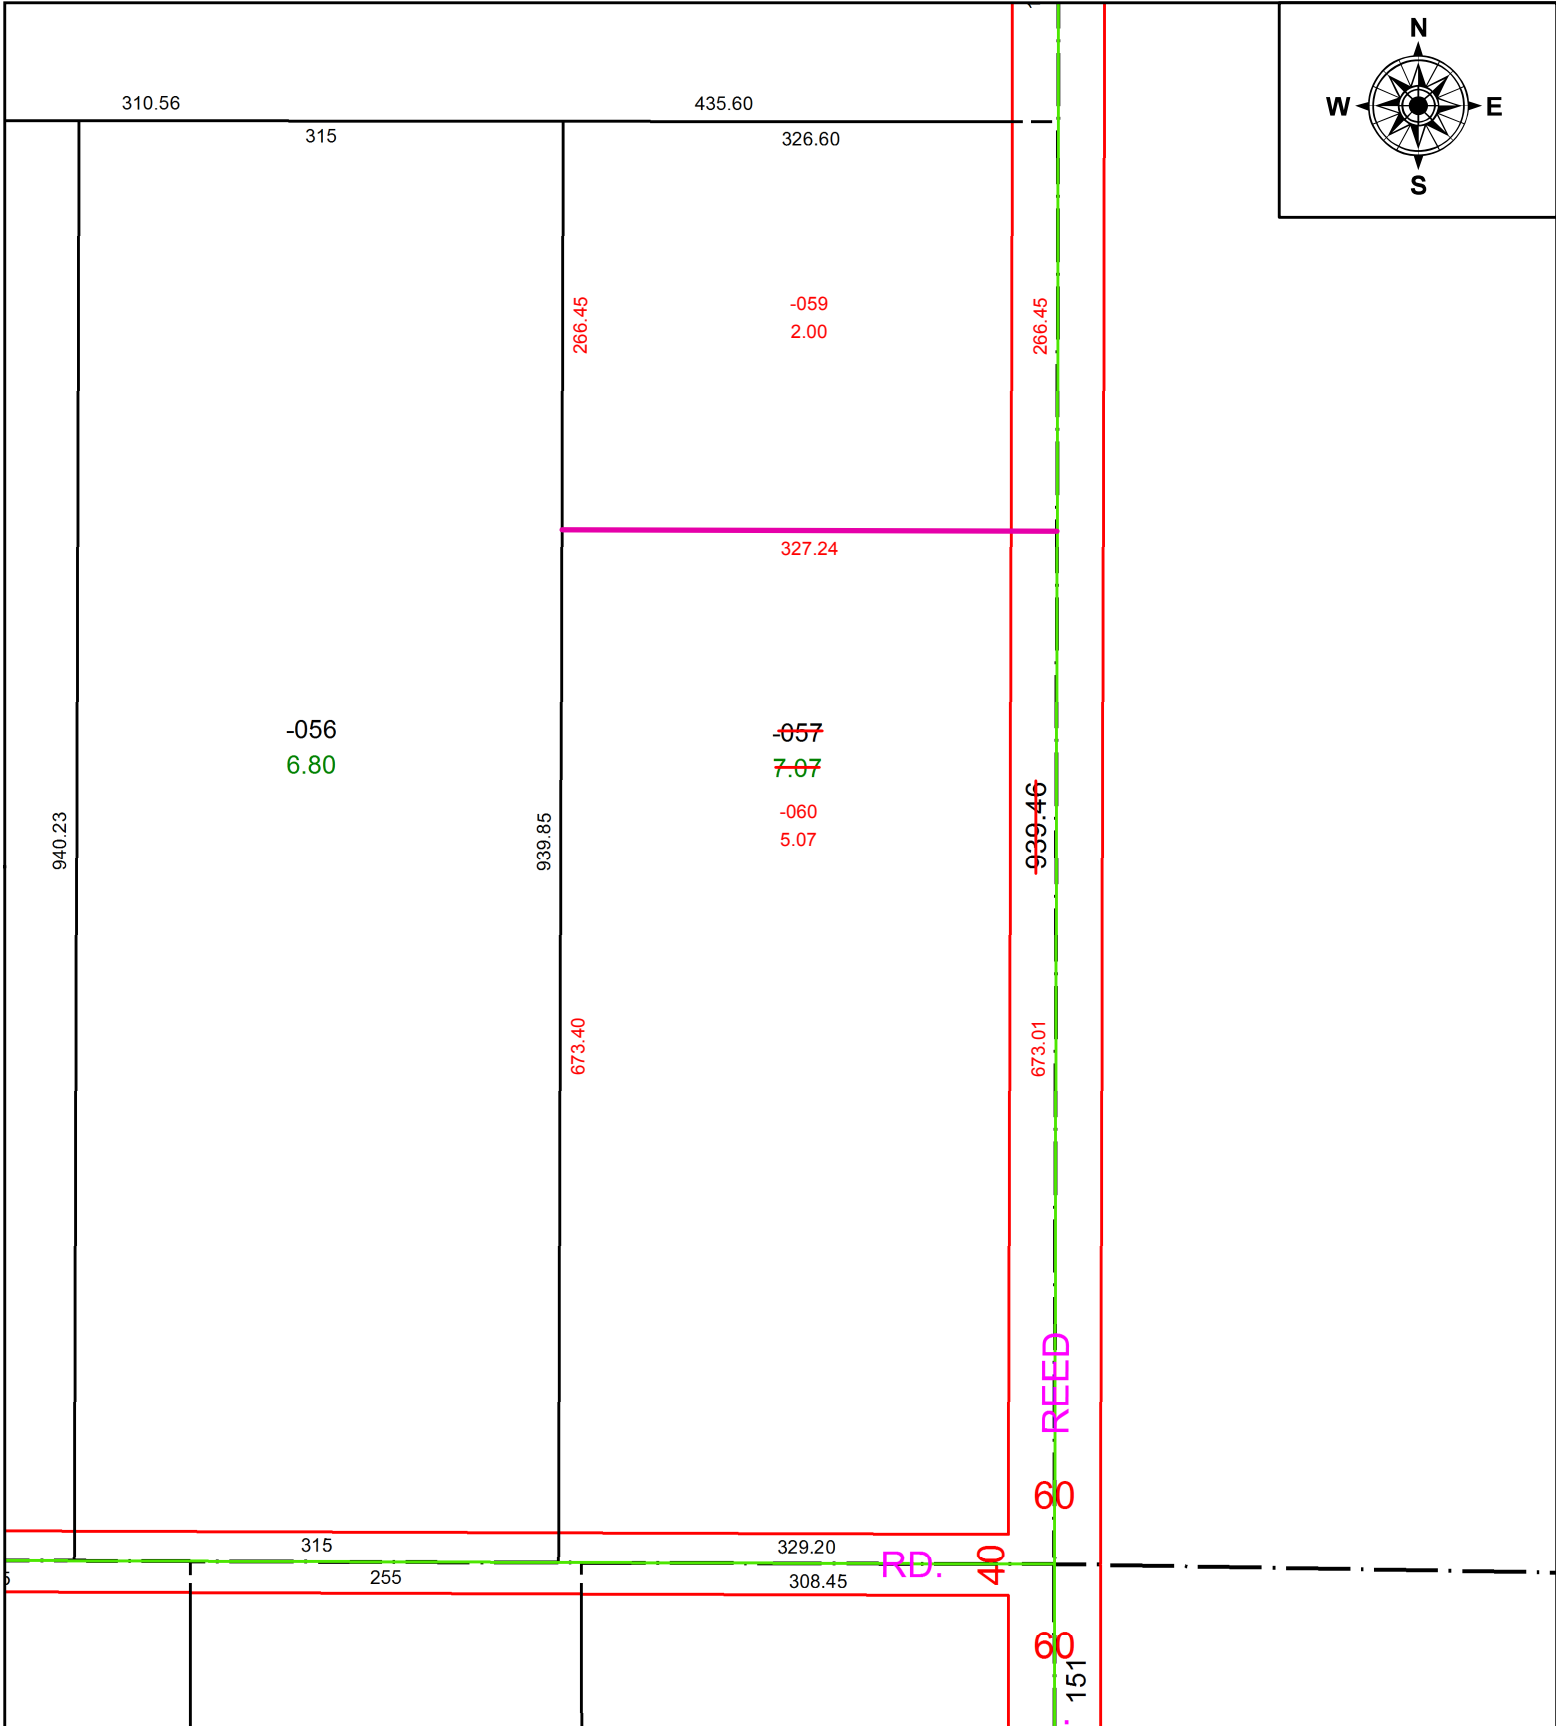


PARENT PARCEL: 11-00-029-000-057

CHILD PARCEL: 11-00-029-000-059, -060

STARTING POINT: C/L OF REED AND DYE RD

22-04438

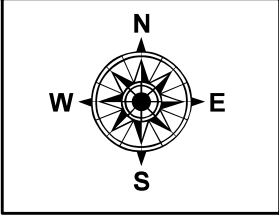

**SPLITS/DEEDS PROCESSED**  
 LORAIN COUNTY TAX MAP DEPARTMENT  
 226 MIDDLE AVE. ELYRIA, OH

**SURVEYED BY:** SEAN A. BOLAND  
**CLOSURE:** 1: 12827  
**MAP PAGE(S):** 11-00-029  
**APPROVED BY:** AC **DATE:** 2/2/2022  
**SCALE:** 1" = 50 **PRIOR INSTRUMENT:** 2021- 0848404