

MICHAEL G. HURA

REGISTERED SURVEYOR

#12706 - R.D. 2 MASON RD. - VERMILION, OHIO 44089 - PHONE 965-4040

136
01-00-003-

BURGE, INC.
3409 Liberty, Vermilion

COMING
ATTRACTION

BARRY-


Description, extension of Lot 43 in Lane Park.

I have discovered miscalculation in Lot 43 as recorded, so the dimensions won't fit what is recorded (43 actually grows a little bit) but this addition will absorb the error.

0.083 acre;

Situated in the City of Vermilion, County of Lorain and State of Ohio. Being known as a part of Original Brownhelm Township Lot 3, bounded and described as follows;

Beginning at the southeast corner of subplot 43 of Lane Park Subdivision No.1 as recorded in Volume 23, Page 50 of Plat Records, said corner being in the northerly line of Elizabeth Drive. Thence South $88^{\circ}24'20''$ East in the projection easterly of Elizabeth Drive, a distance of 32.16 feet to a point. Thence North $1^{\circ}35'40''$ East, a distance of 113.05 feet to a point. Thence North $89^{\circ}52'40''$ West in the projection easterly of the northerly line of subplot 43, a distance of 32.15 feet to the northeast corner of subplot 43. Thence South $1^{\circ}35'40''$ West along the easterly line of subplot 43, a distance of 112.22 feet to the place of beginning, embracing 0.083 acre of land, but being subject to all legal highways.

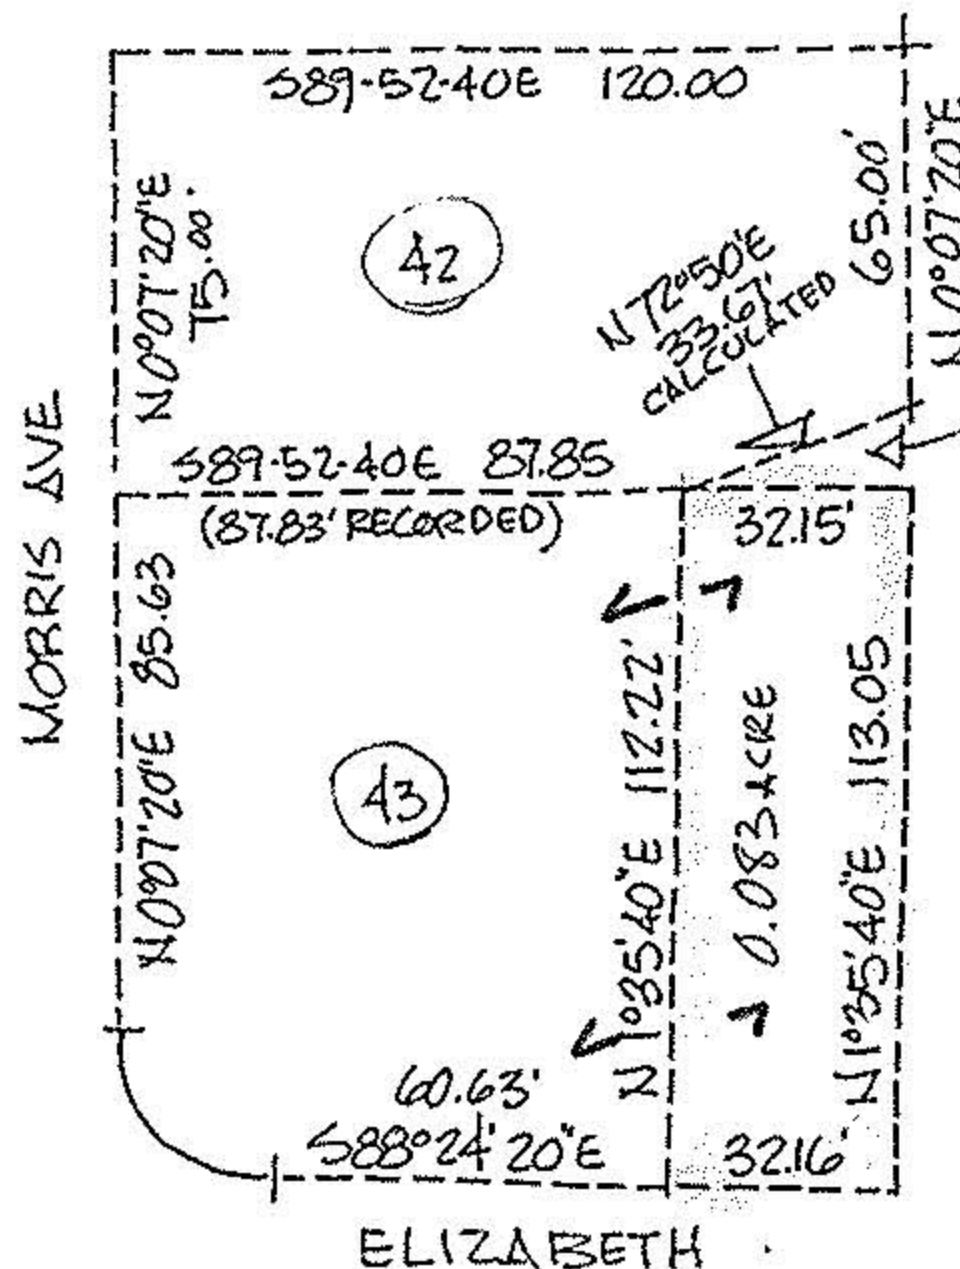

WHY DON'T YOU HAVE THIS WEDGE TRANSFERRED TO 42?

1-00-003-D

P.P.N 01-00-003 136-

042
043