

1-00-001-B

Map of part of sublots 256, 260, 261 Elberta Beach Allot
Vermilion City Lorain Co. Ohio Scale 1" 20' Nov. 19, 1979
By Arnold P. Koepp Reg. Surveyor No. 4306

1-00-001

01-00-001-106

#13317


APPROVED
LORAIN CO.
MAP DEPT.

DATE 12-31-79

PAGE 1-00-001-B


BY *A. Koepp*

VOID AFTER 13317

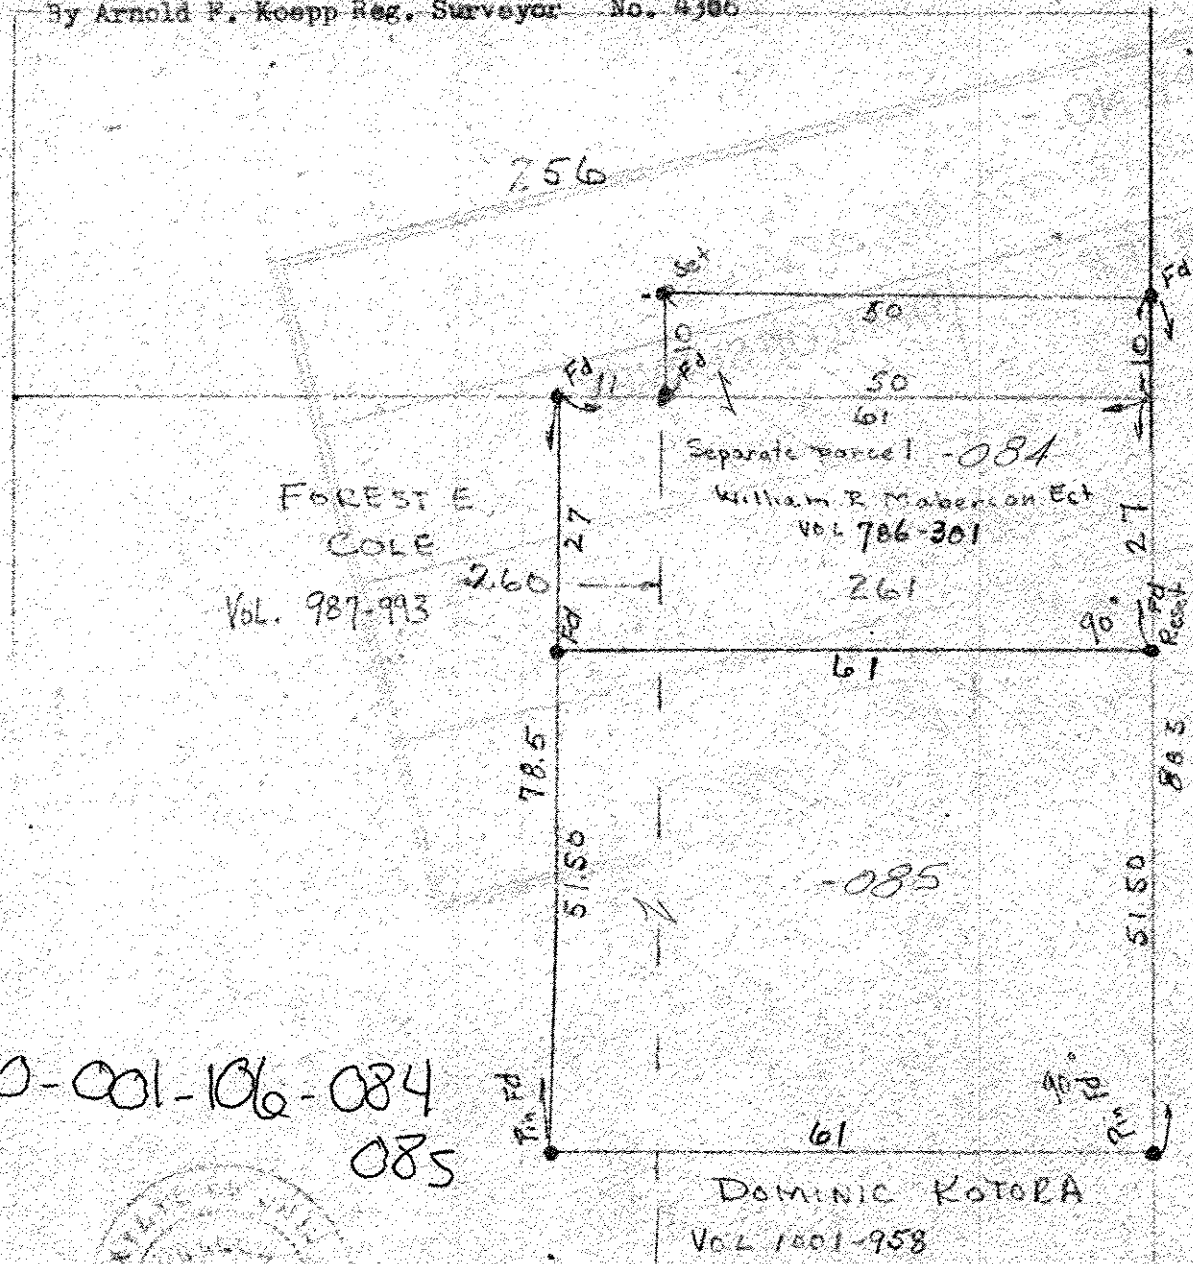

01-00-001-106-084

085

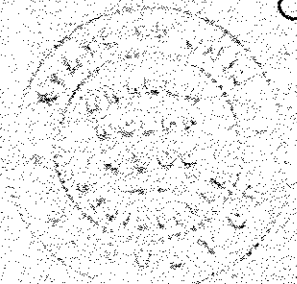

#13317

NIAGARA ROAD