


STORY

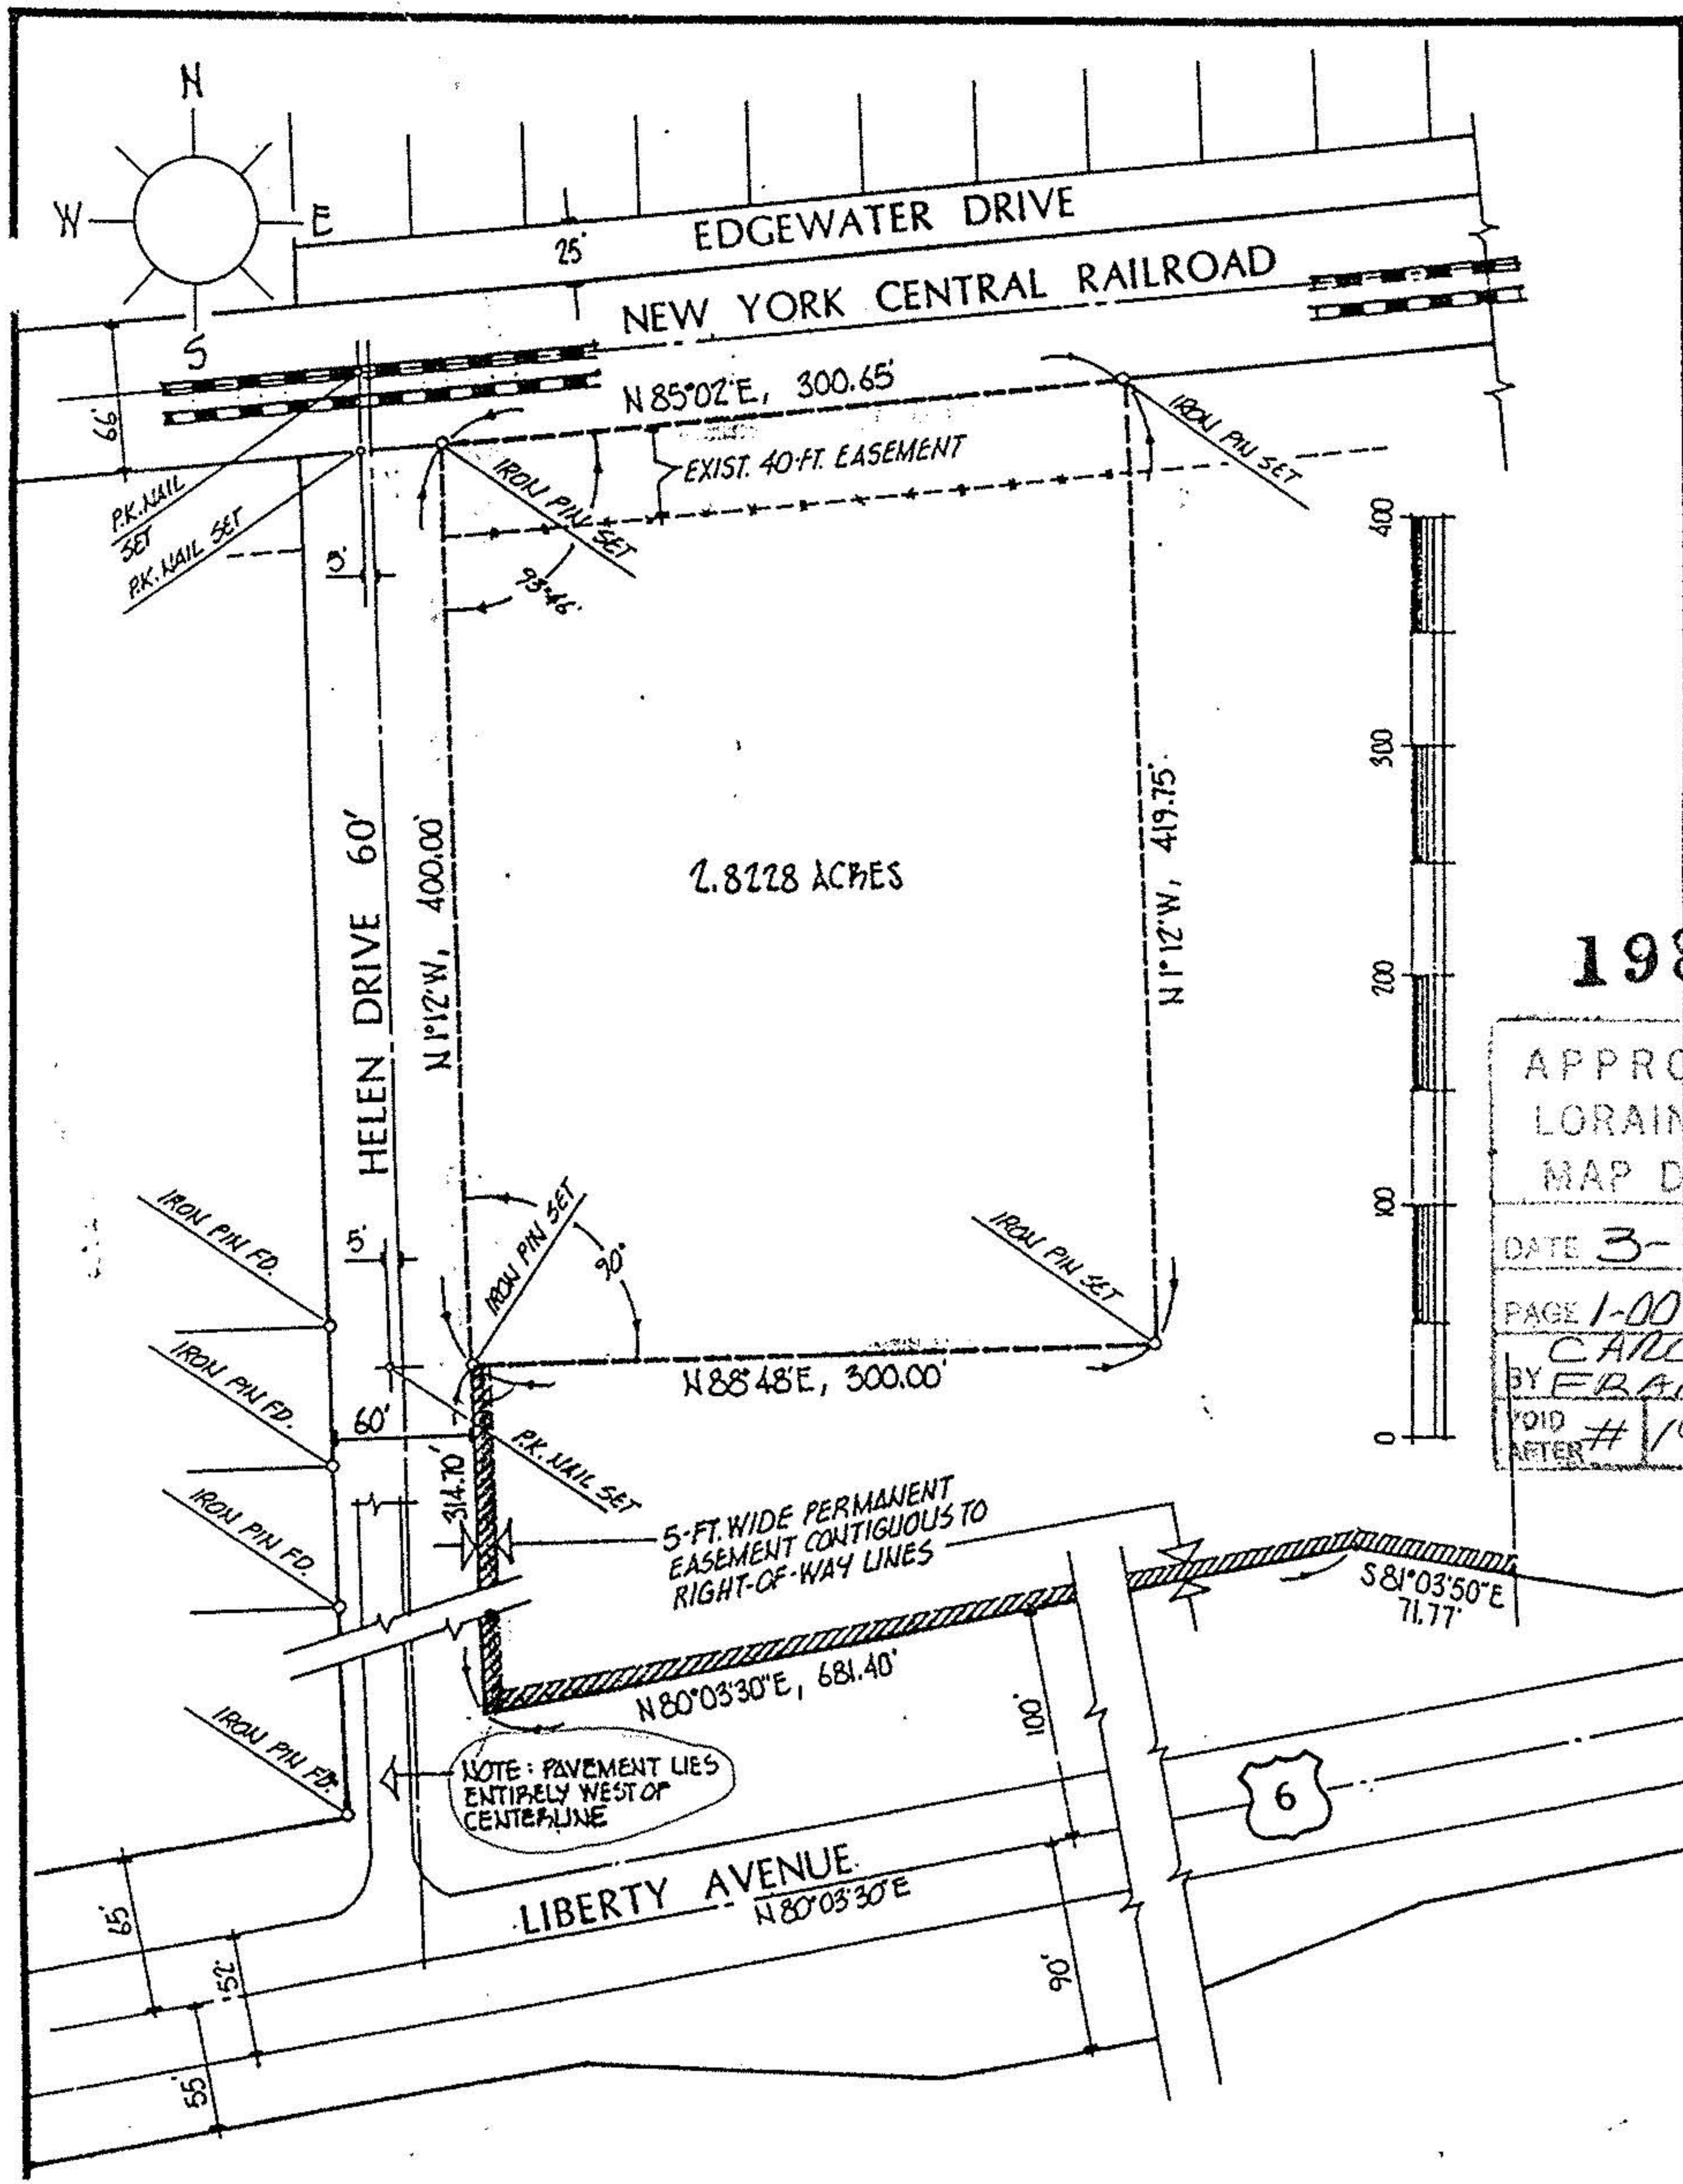

19819

APPROVED LORAIN CO. MAP DEPT.
DATE 3-13-92
PAGE 1-00 005-B
CAROLYN BY FRANCIS
VOID AFTER # 19819

ACREAGE 2.8228	PREPARED FOR OHIO EDISON COMPANY attn: G.C. BISHOP 76 SOUTH MAIN ST., AKRON, OH. 44308
DATE NOV-91	
DRAWN MGH	
SCALE 1" = 100 ft.	
	<b>MICHAEL G. HURA</b> registered surveyor 12706 MASON ROAD, VERMILION, OHIO [216] 965-4040
	<b>PERIMETER SURVEY</b>
	SUBLOT _____ OF _____ Volume _____ Page _____ of PLATS PART OF O.L. 5 TRACT _____ SECTION _____ OF BROWNHELM TOWNSHIP LORAIN CO., OHIO Perm. Parcel No. _____ Ref. deed: _____
	CITY OF VERMILION, OHIO