


P.P.N 01-00-015-000-011 013 thru 018



21476
 APPROVED
 LORAIN CO.
 MAP DEPT
 DATE 9-11-95
 PAGE 1-A
 BY CAROLYN
 FROILICIS
 21476

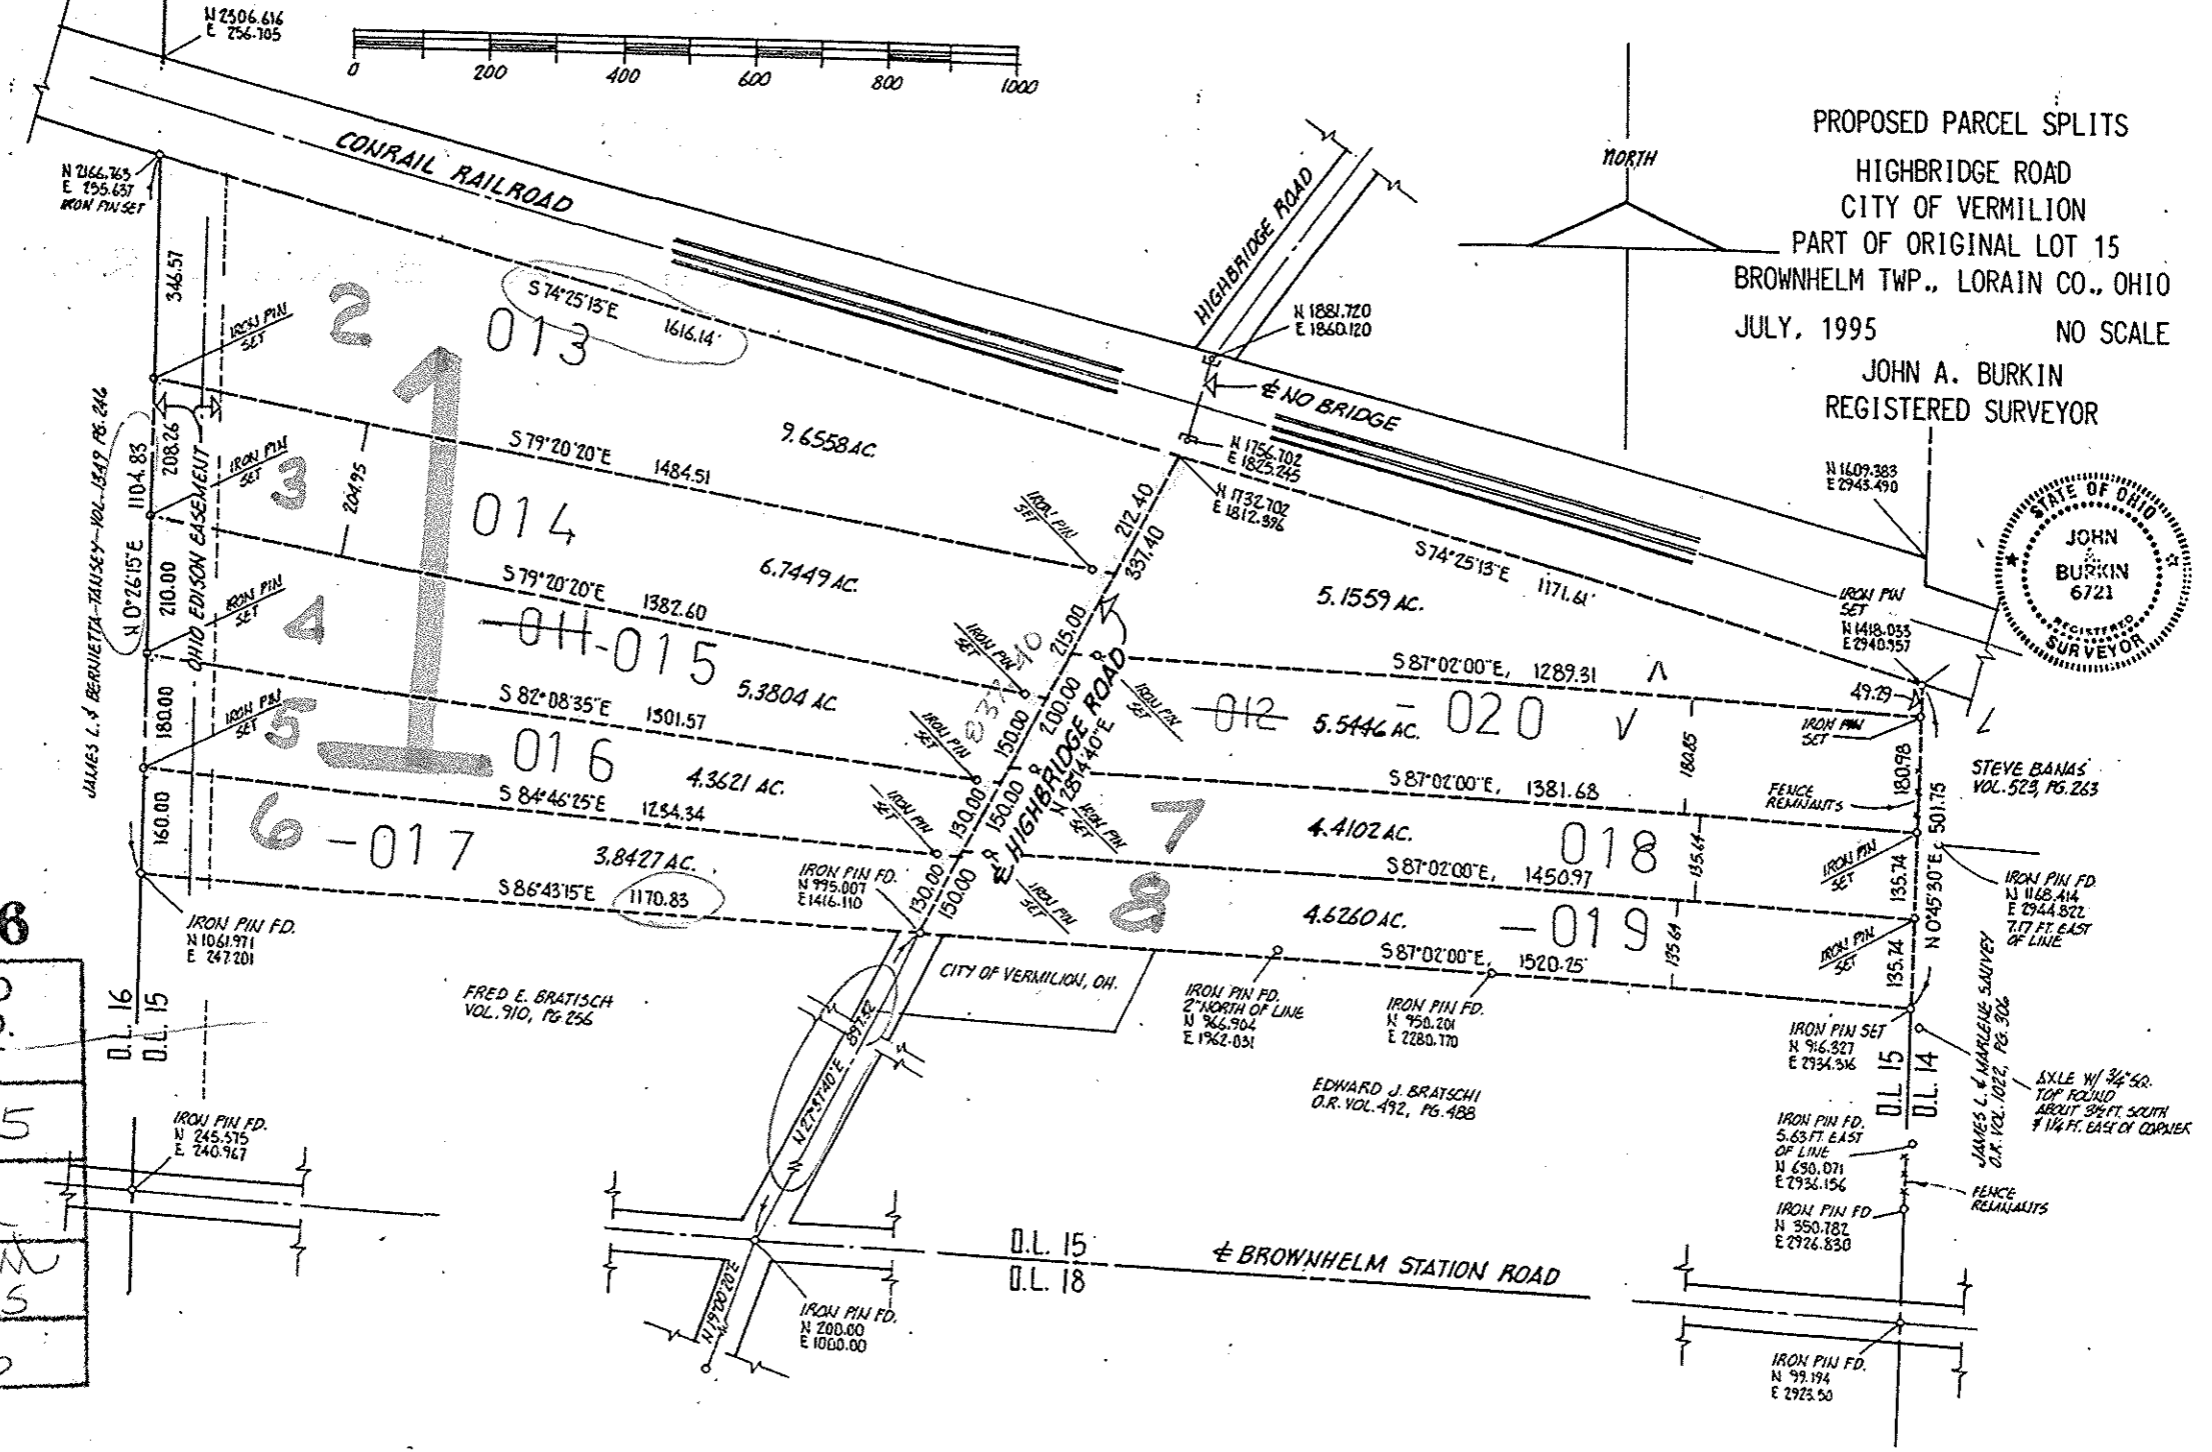