


01-00-017-000-028  
 2487 AC  
 To 2461 AC

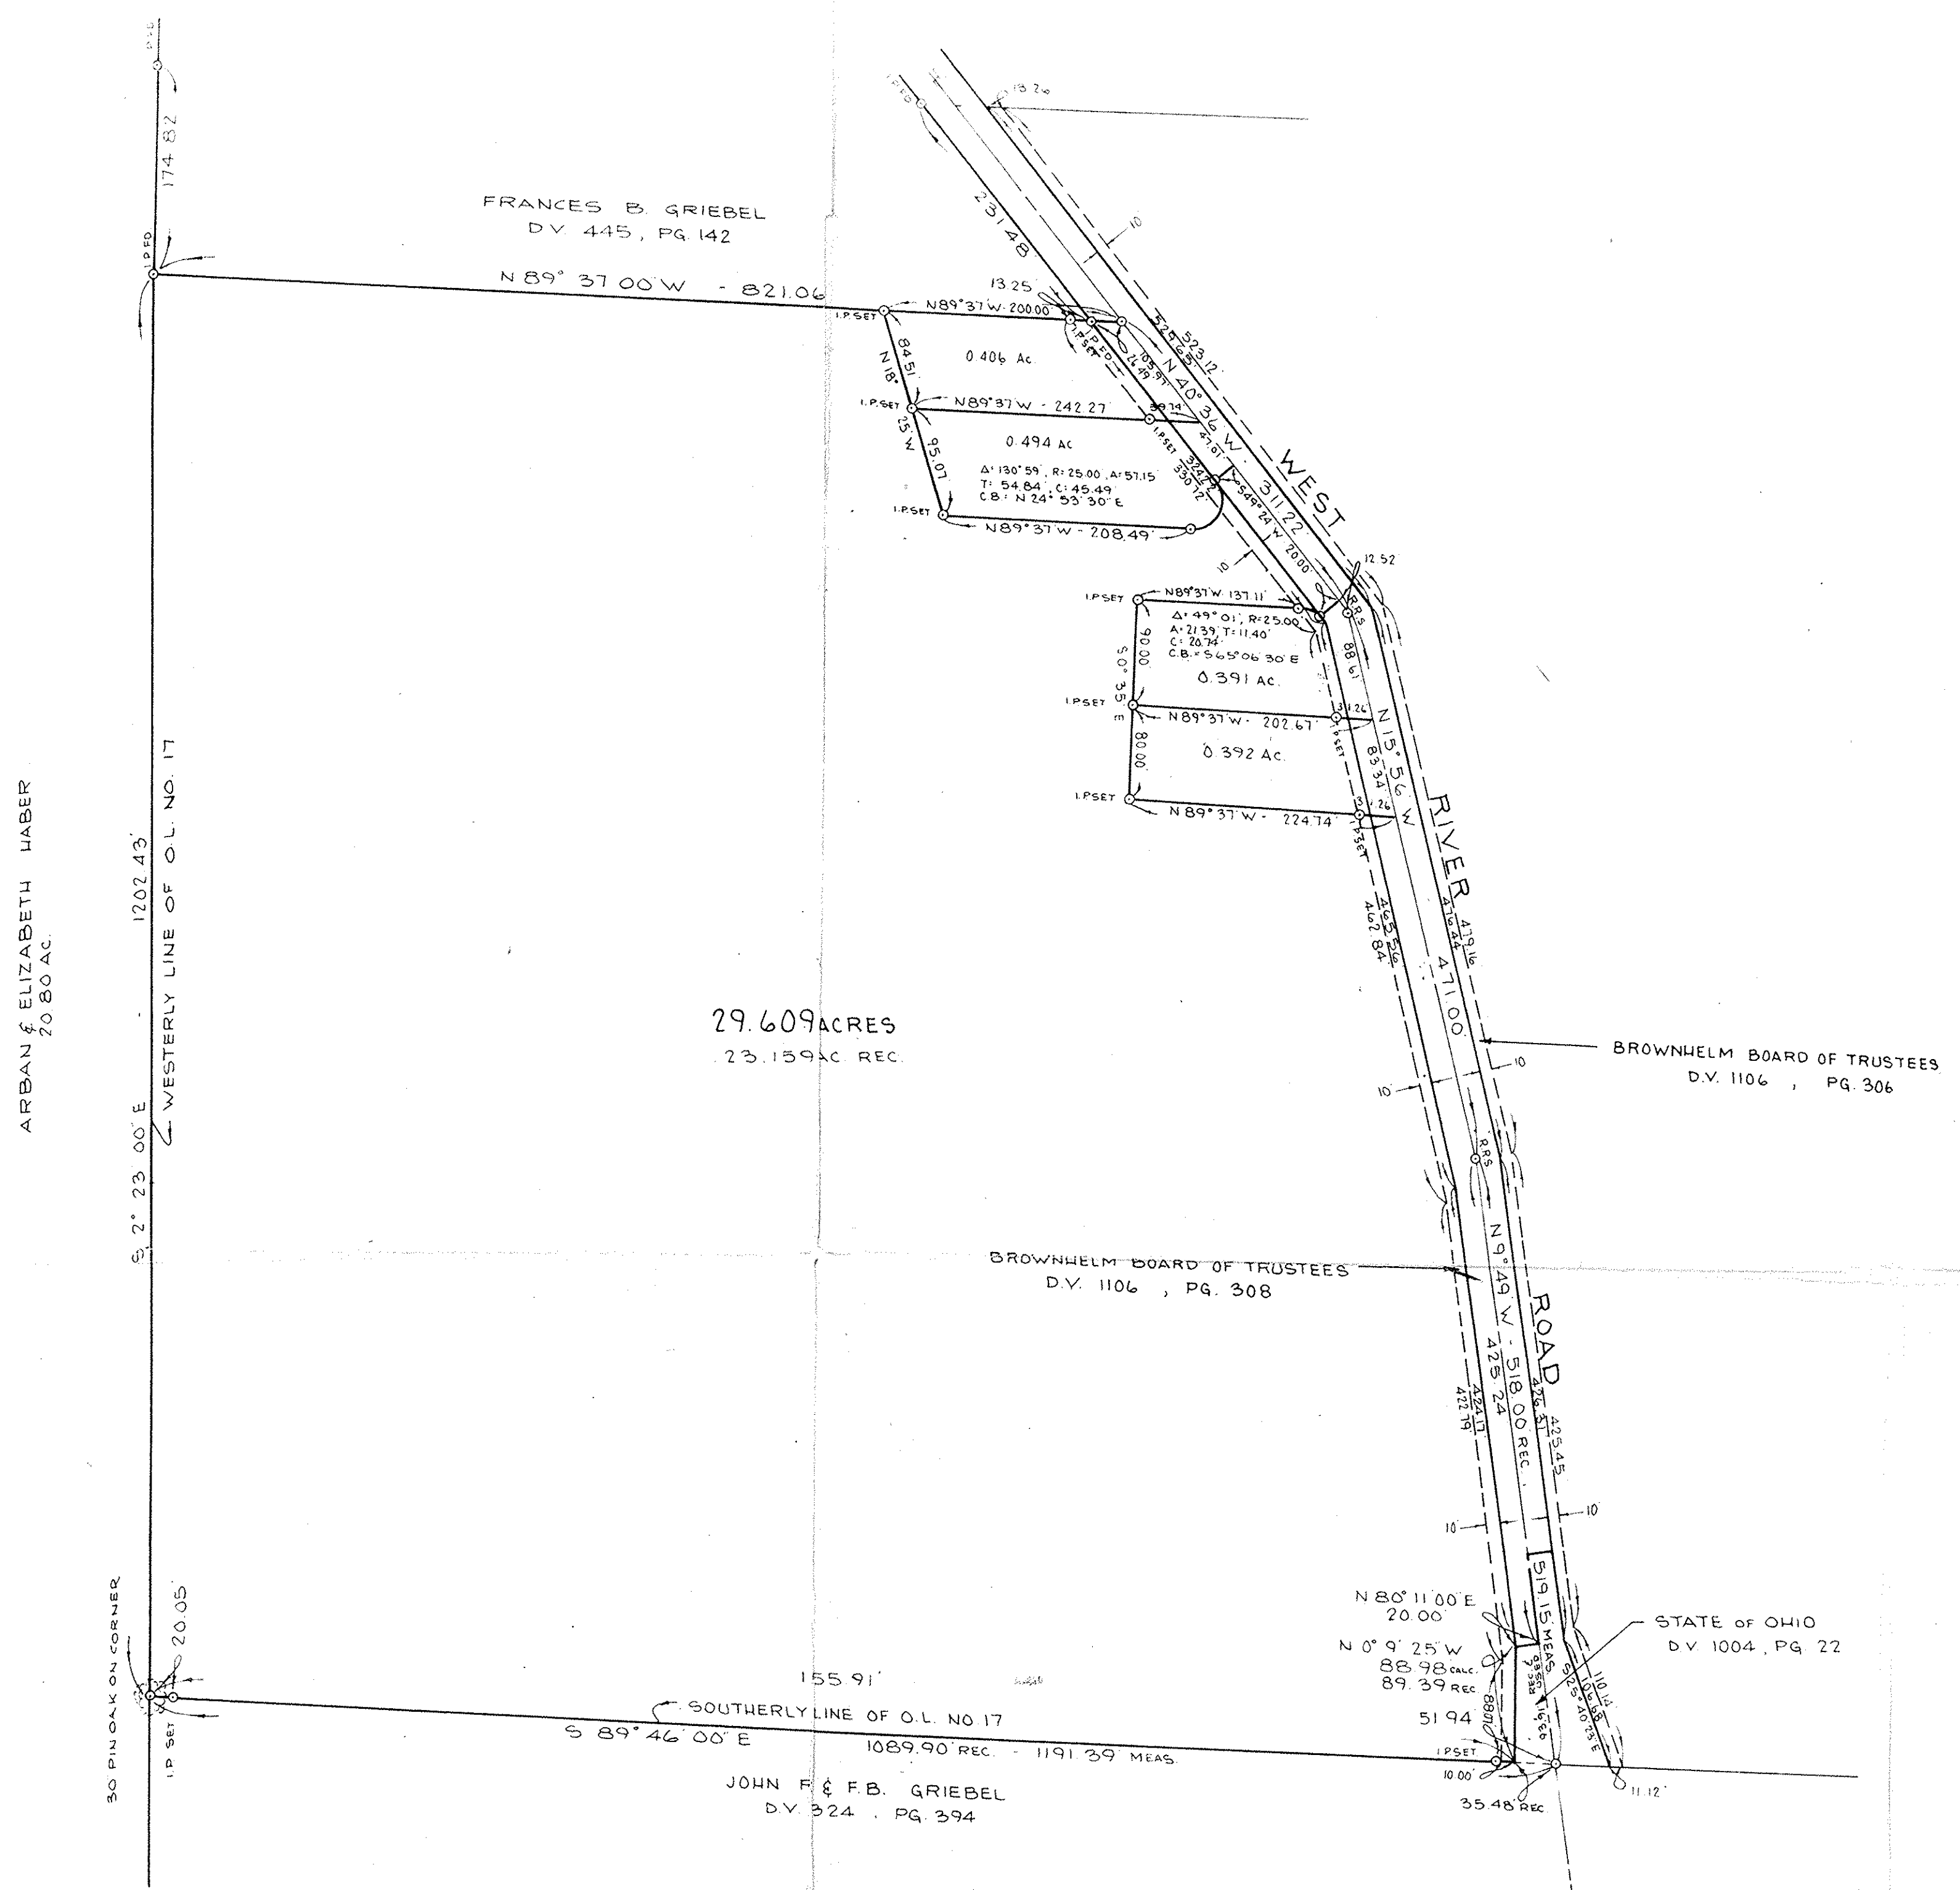

No.	Date	Description	By
1	7/19/74	ADDITION - 4 LOTS	dlc
REVISIONS			

PROJECT  
**SURVEY**  
 OF PART OF  
 ORIGINAL BROWNHELM TOWNSHIP  
 LOT NO. 17  
 COUNTY OF LORAIN STATE OF OHIO

PREPARED FOR:  
 KENNETH CASSELL

Drawn by: dlc  
 Checked by:  
 App. by:  
 Scale: 1" = 100'  
 Date: MAY 17, 1974

**KLEINOEDER-SCHMIDT**  
 and ASSOCIATES

ENGINEER — SURVEYORS — CONSULTANTS in LAND PLANNING

ELYRIA - NORWALK - MEDINA OHIO

REFERENCES	
SHEET NO.	JOB NO.
1 of 1	74-108