

KLEINOEDER · SCHMIDT

and ASSOCIATES

ENGINEERS — SURVEYORS — CONSULTANTS in LAND PLANNING

ELYRIA ·



OHIO

SURVEY

Sublot(s) _____

Subd'n _____

Township BROWNHELM Tract _____
 Orig. Lots) 17 Sec. _____
 County of LORAIN State of Ohio
 Corporation _____

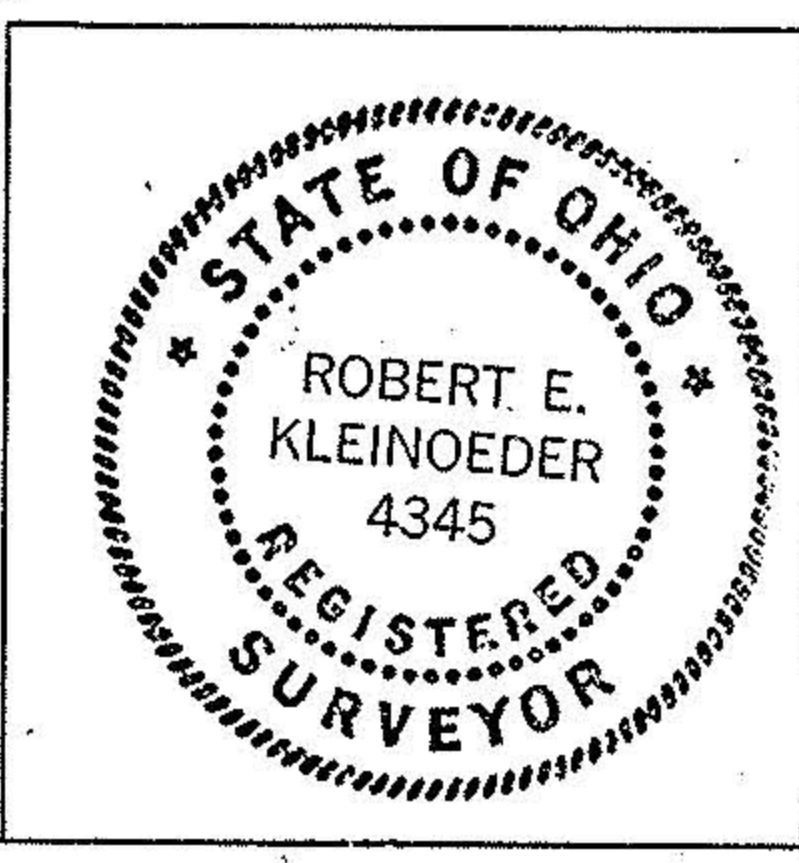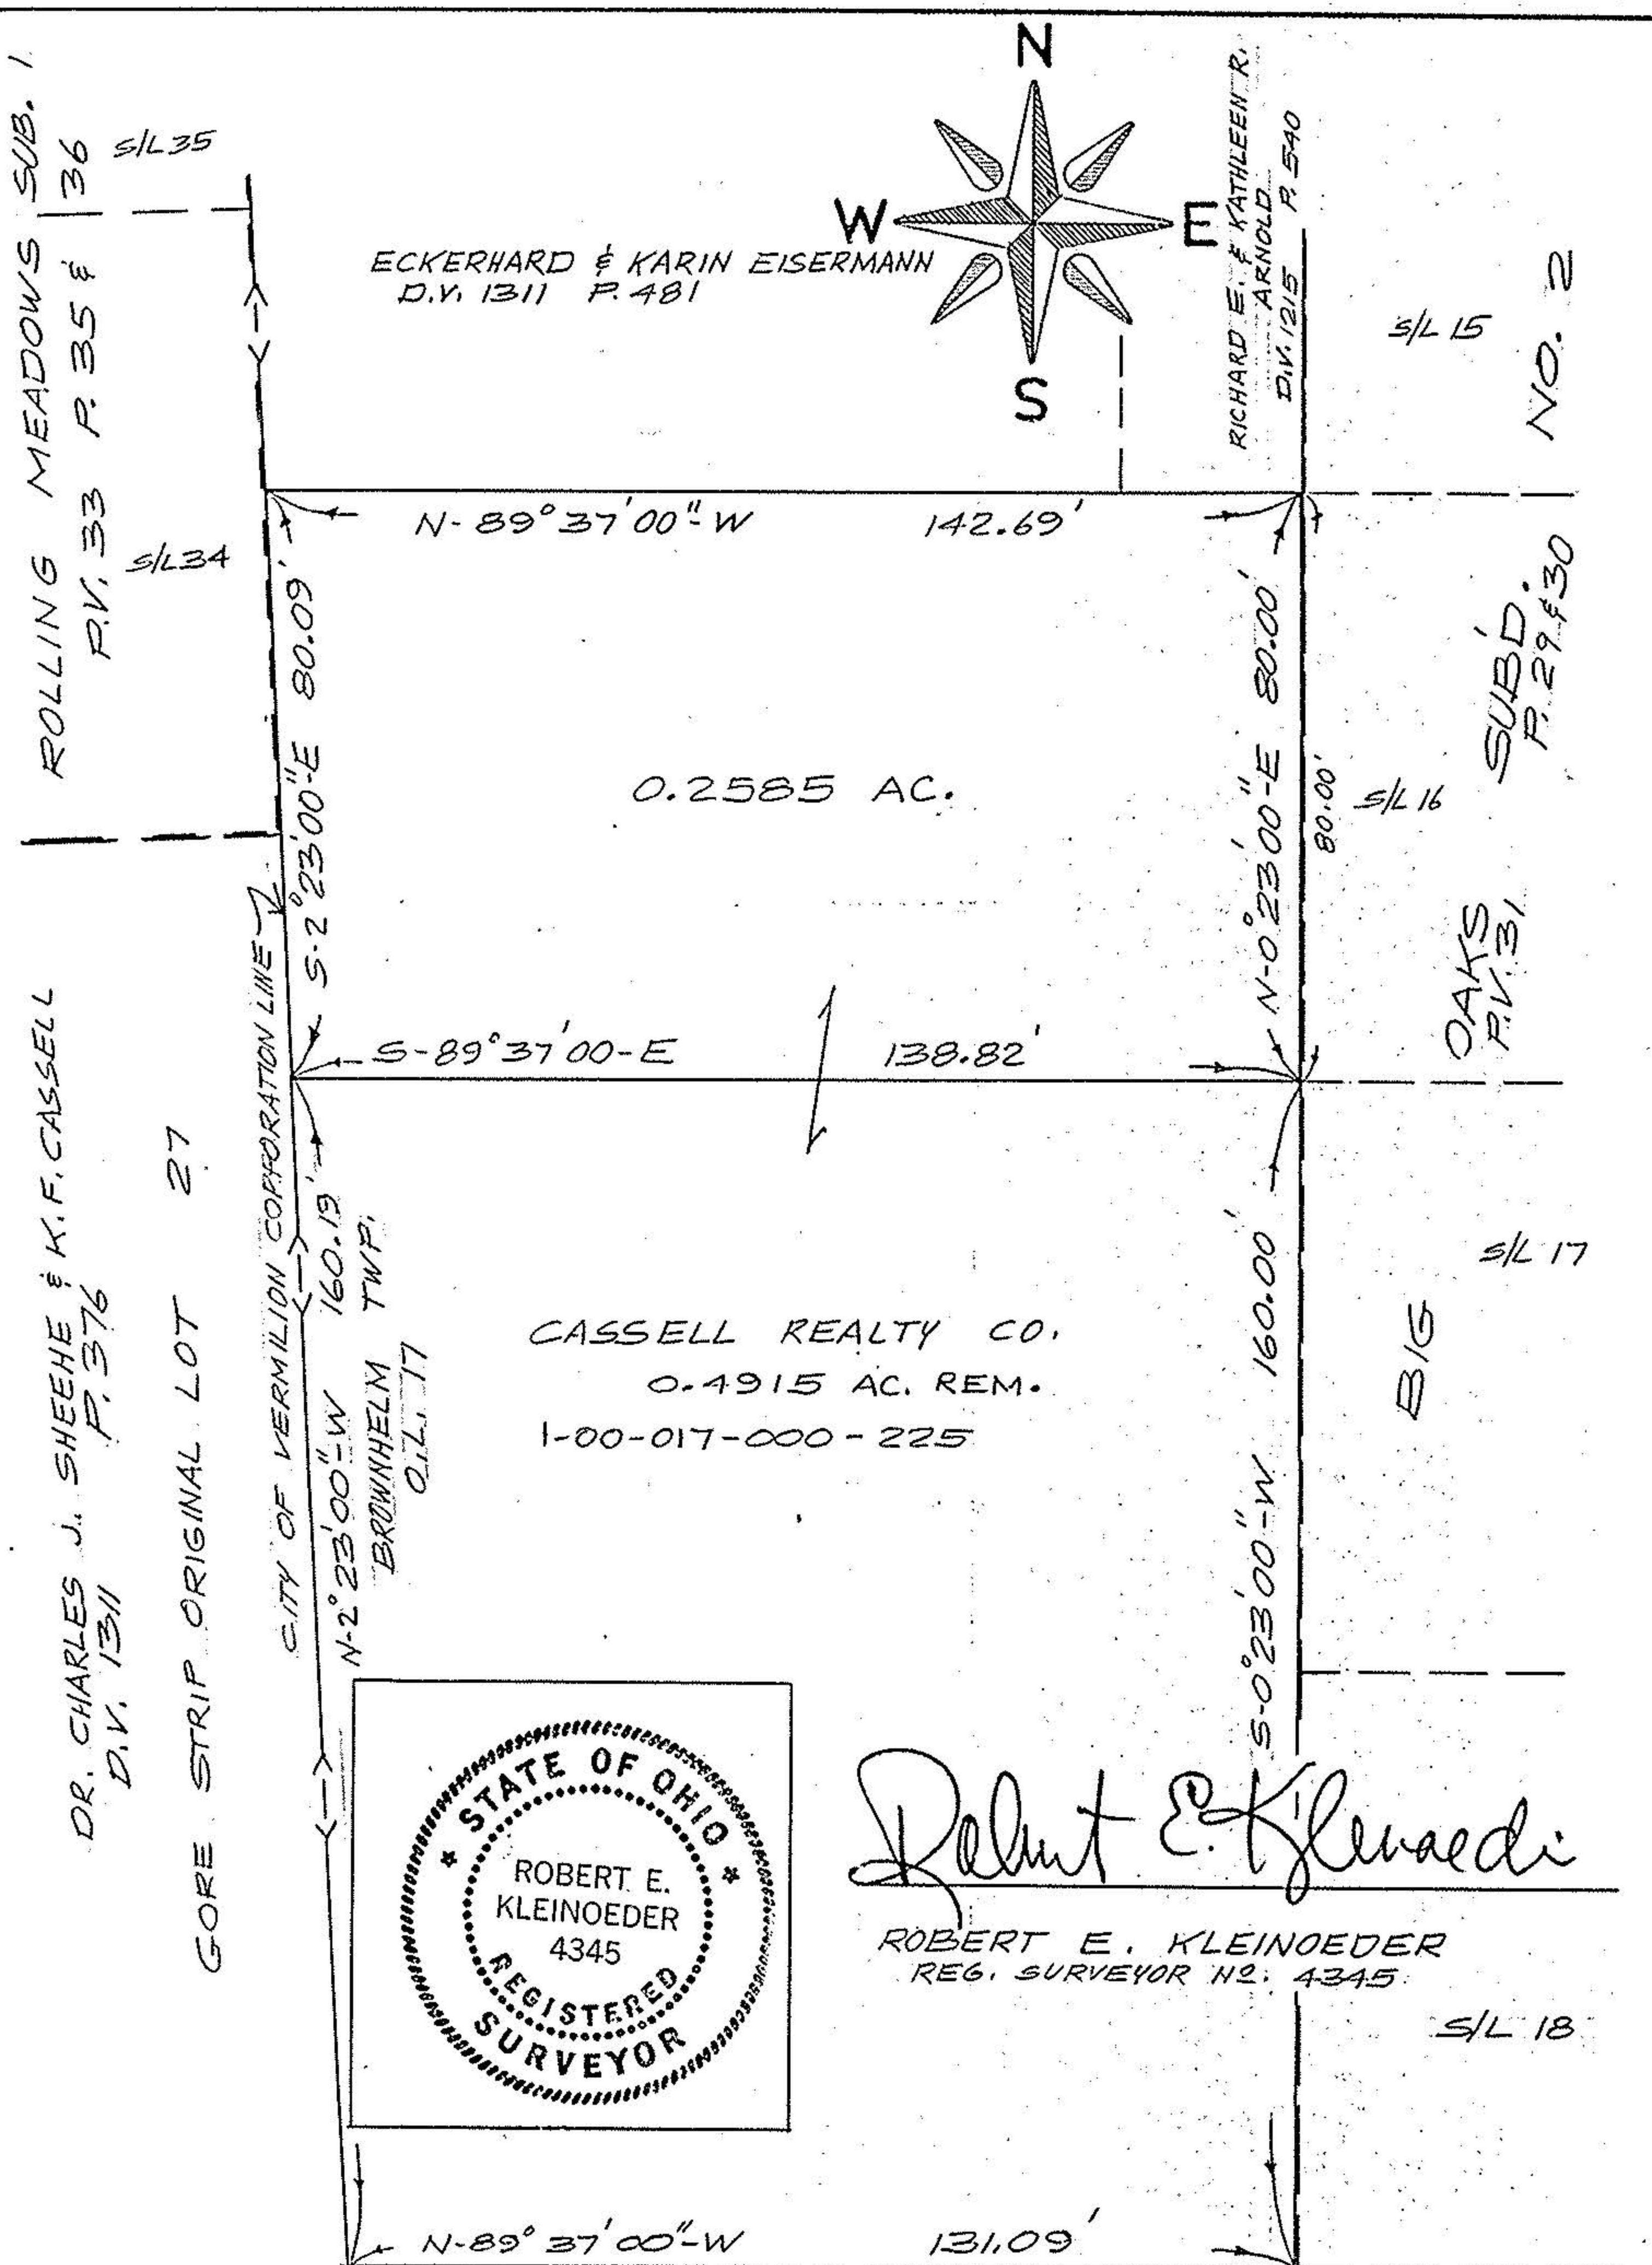

Robert E. Kleinoeder
 ROBERT E. KLEINOEDER
 REG. SURVEYOR NO. 4345

Prepared for: KEN CASSELL

Scale: 1" = 30' Date: 12-18-86 Dr. by: K.V.S. Job No 74-108

KLEINOEDER · SCHMIDT

and ASSOCIATES

ENGINEERS — SURVEYORS — CONSULTANTS in LAND PLANNING

ELYRIA ·



OHIO

SURVEY

Sublot(s) _____

Subd'n _____

Township BROWNHELM Tract _____
 Orig. Lots) 17 Sec. _____
 County of LORAIN State of Ohio
 Corporation _____

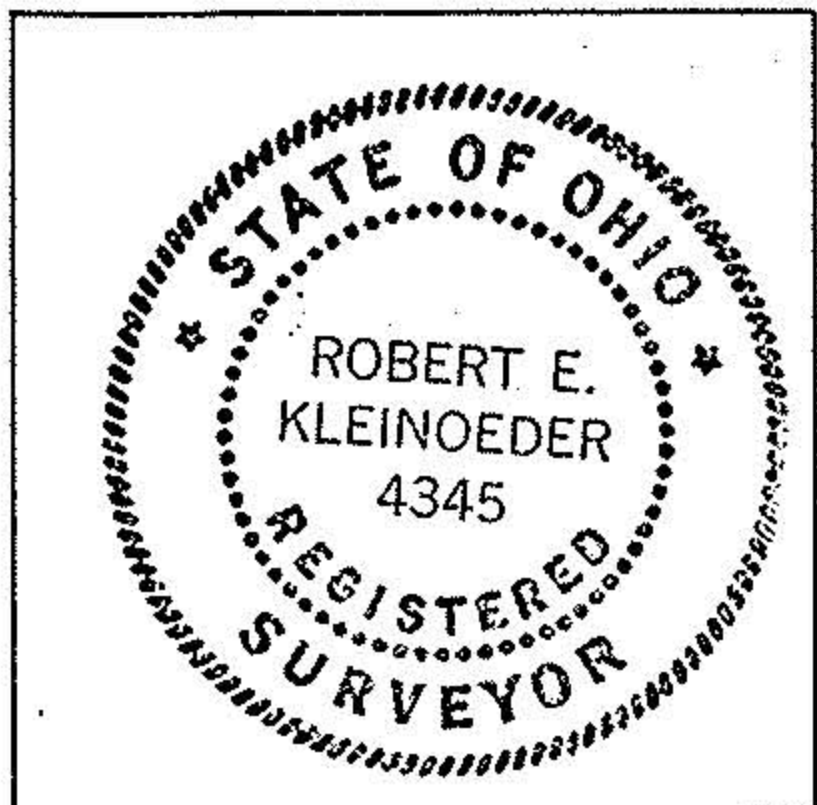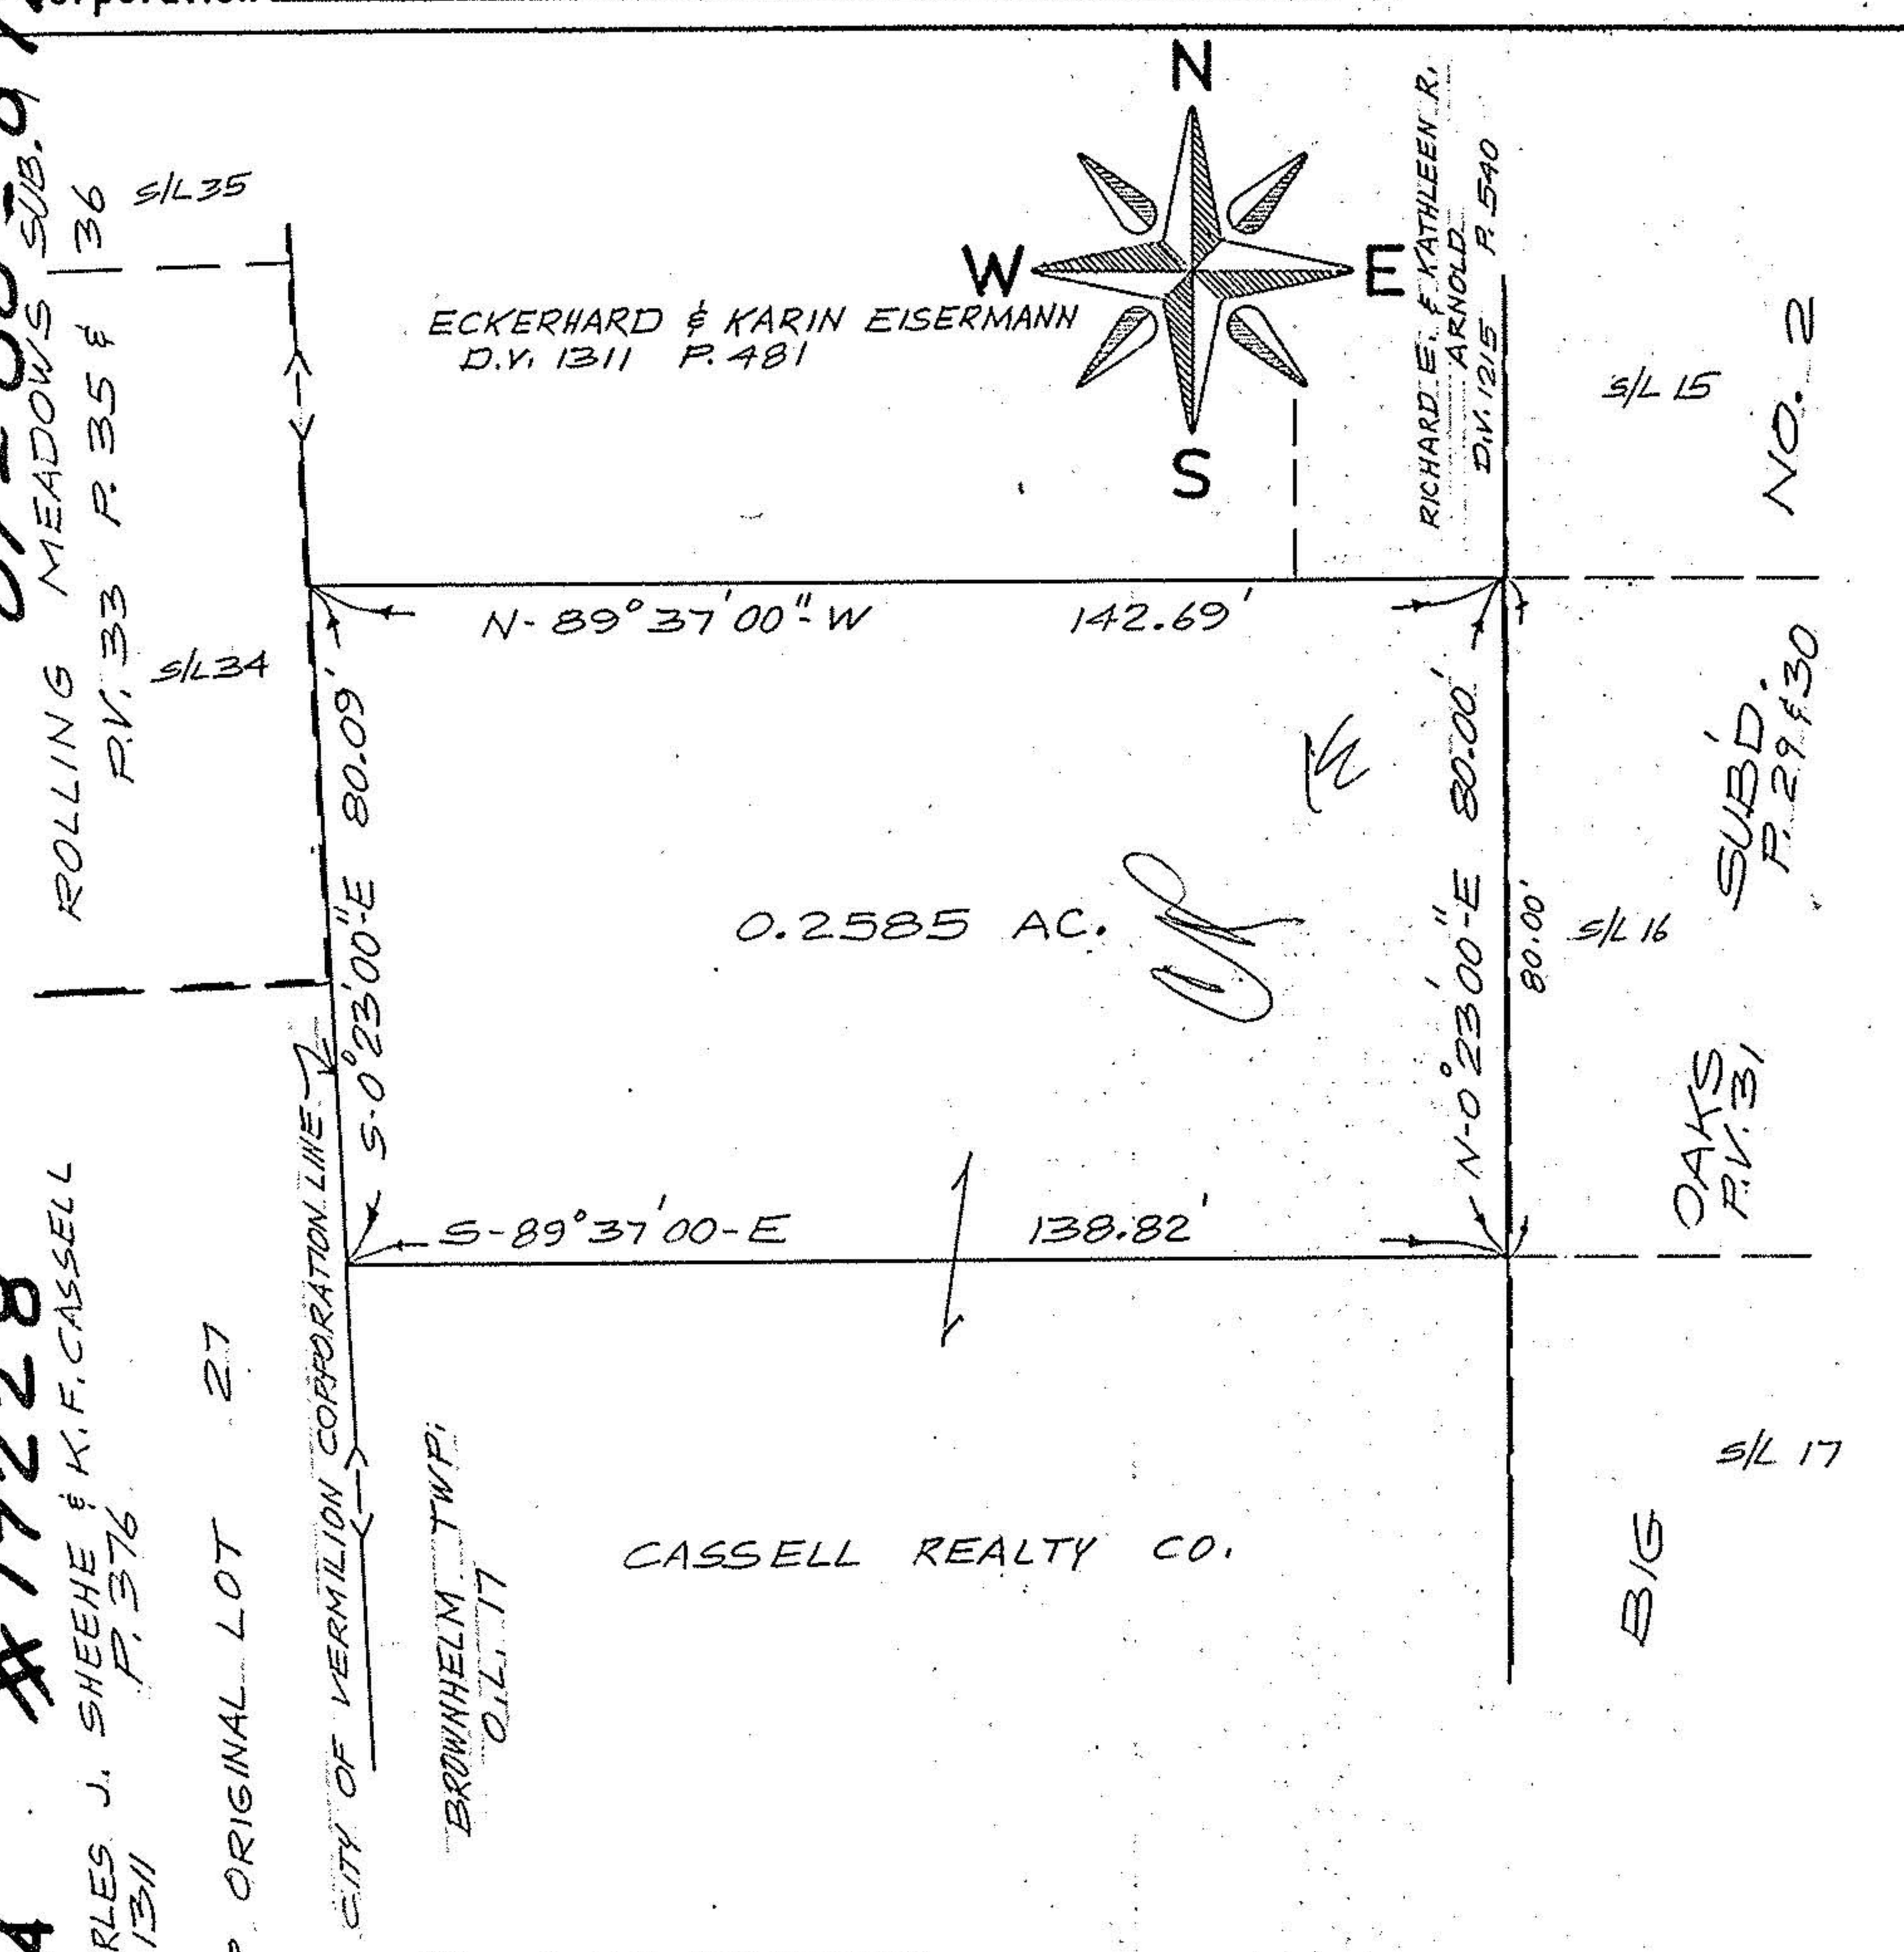

Robert E. Kleinoeder
 ROBERT E. KLEINOEDER
 REG. SURVEYOR NO. 4345

Prepared for: KEN CASSELL

Scale: 1" = 30' Date: 12-18-86 Dr. by: K.V.S. Job No 74-108

APPROVED	
LORAIN CO.	
MAP DEPT.	
DATE	1-21-87
PAGE	1-00-017-A
BY	C. Francis
VOID	
AFTER	177228

1-00-017-A #17228

P.P.N 01-00-017-000-007

Copy

17228