

ARNOLD KOEPP


REGISTERED SURVEYOR

629 BRENNAN DRIVE

AMHERST, OHIO 44001

Feb. 27, 1971

Survey for Jona Love Part of Lot 22 Brownhelm Twp. Now City of Vermilion
Lorain Co. Ohio Scale 1" = 100'

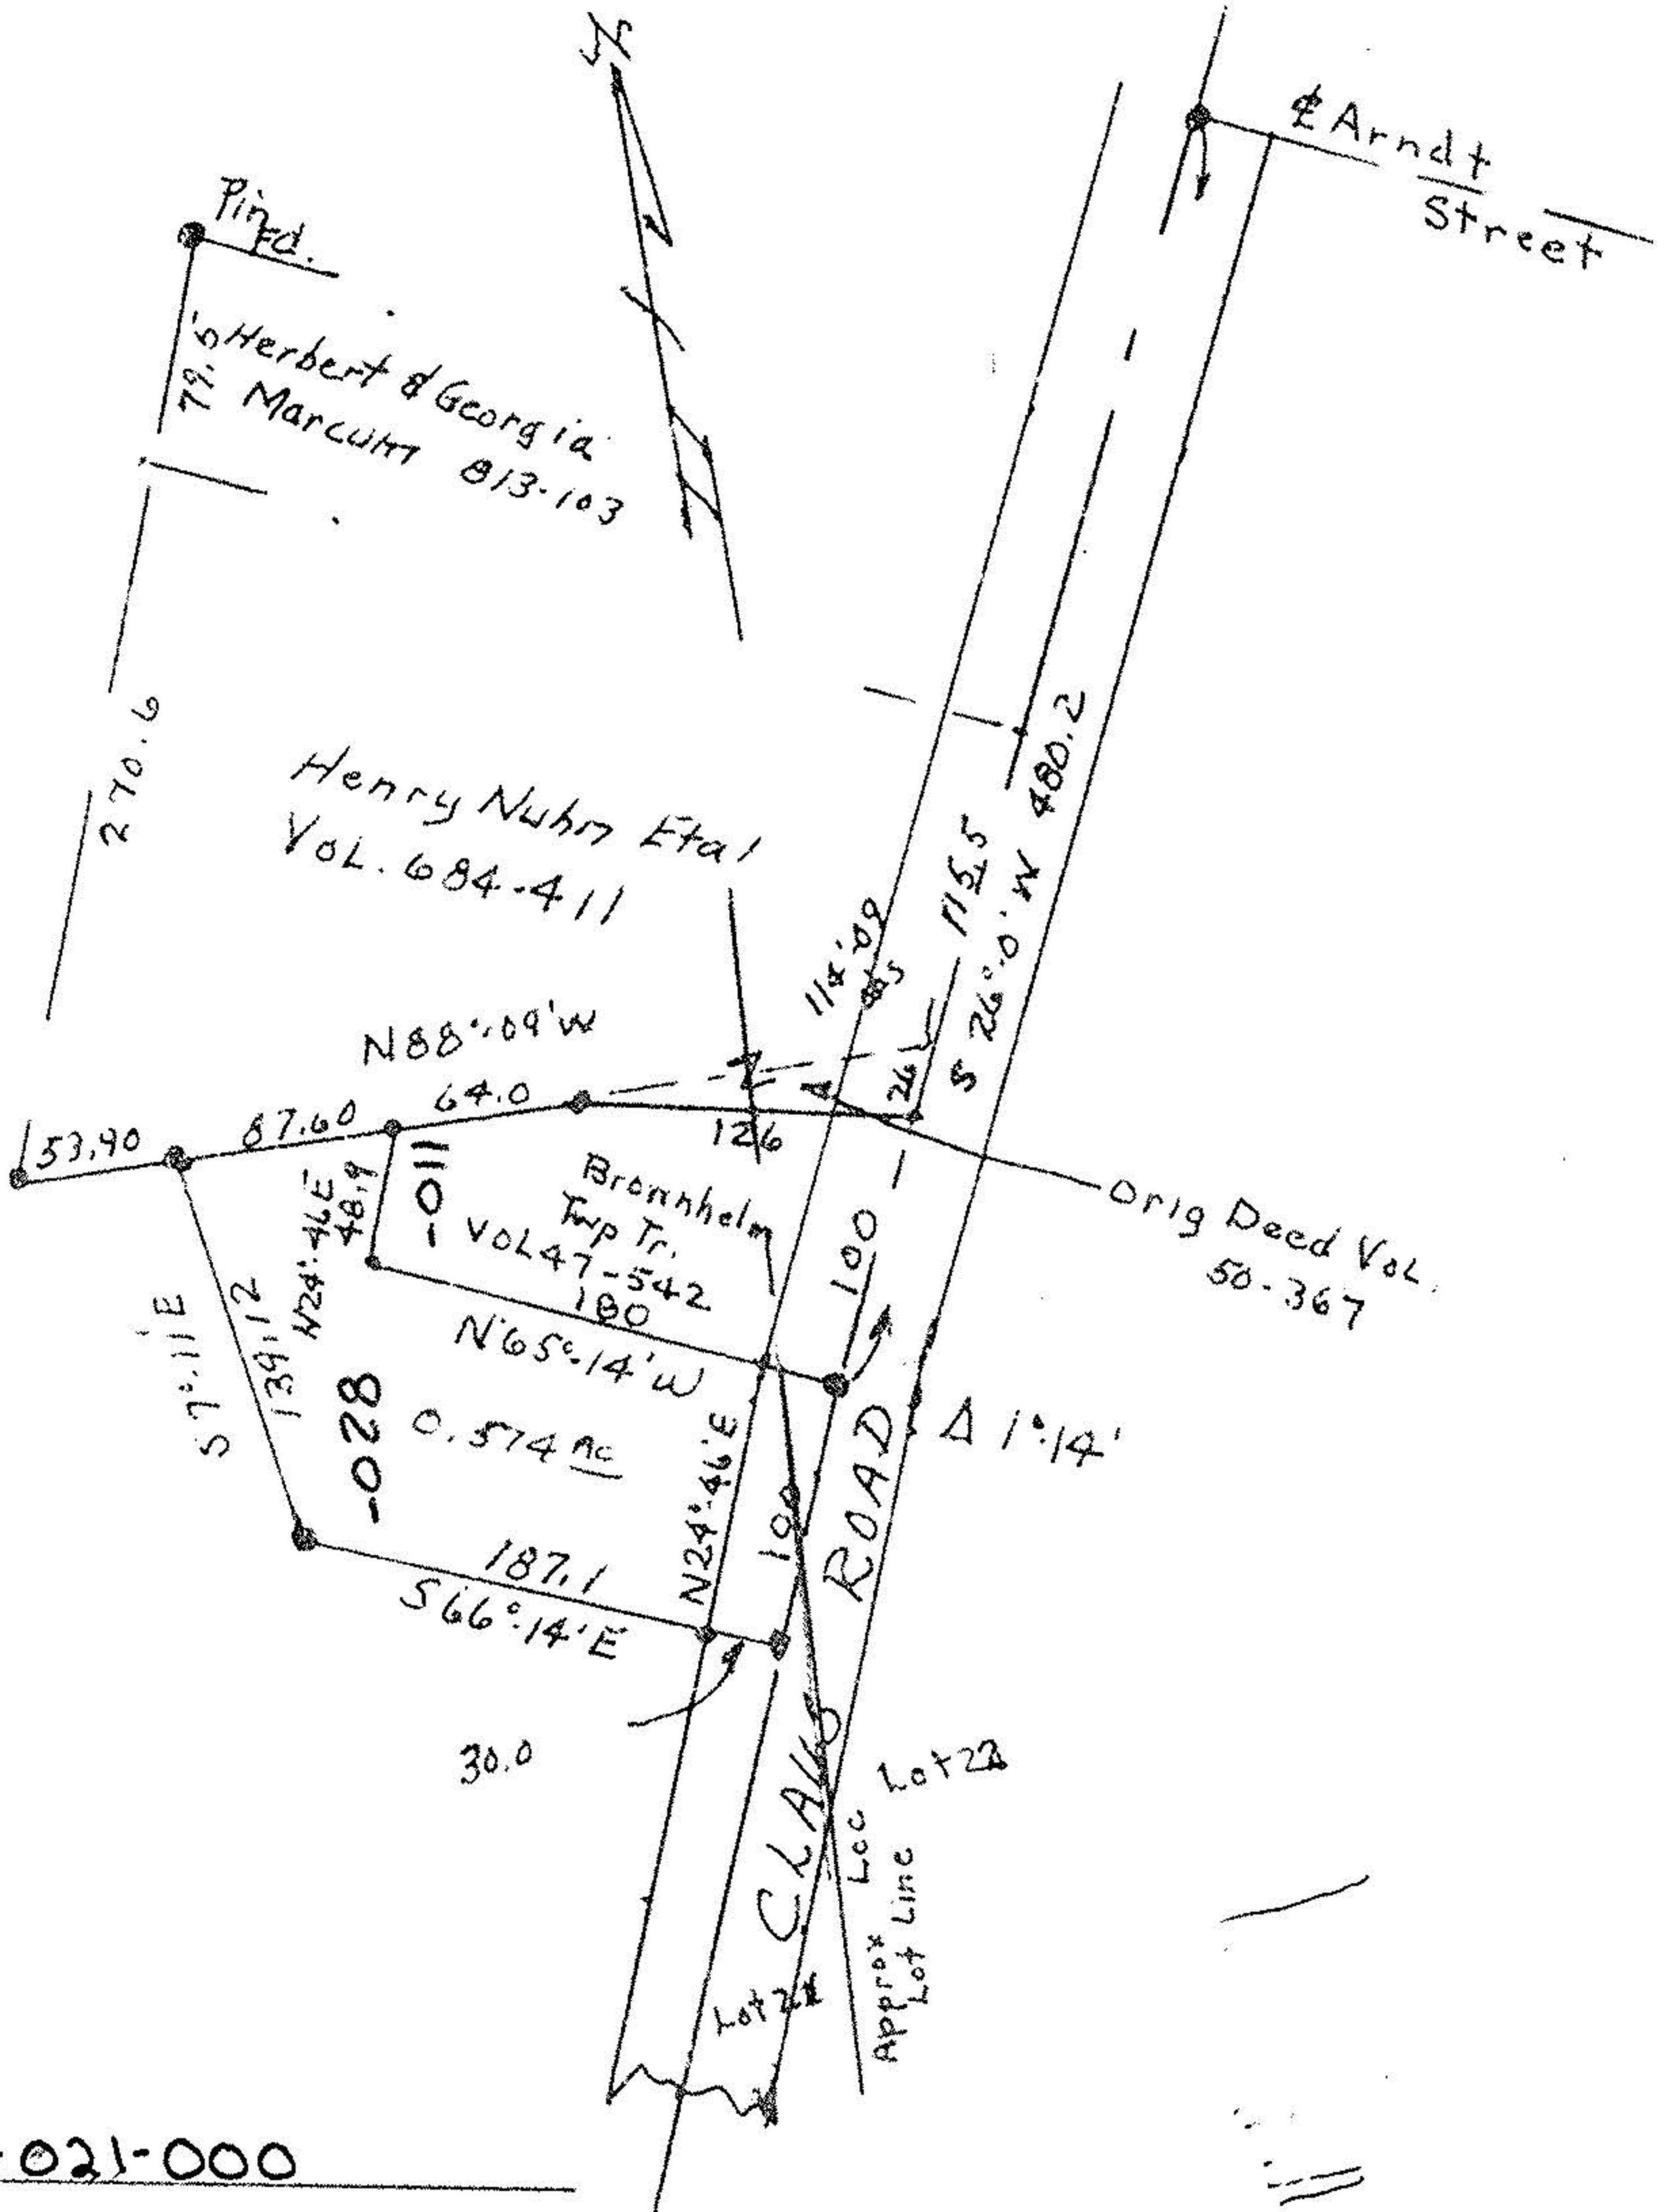

01-00-021-000

1-00-021-B

P.P.N 01-00-021-000