


HARTUNG & ASSOCIATES ENGINEERS & SURVEYORS

P.O. BOX 426, 421 WILLIAMS ST., HURON, OH 44839-0426
(419) 433-4321 • FAX (419) 433-7879

DANIEL E. HARTUNG JR., PE, PS

STATE OF OHIO (DV 1003 PG 439)

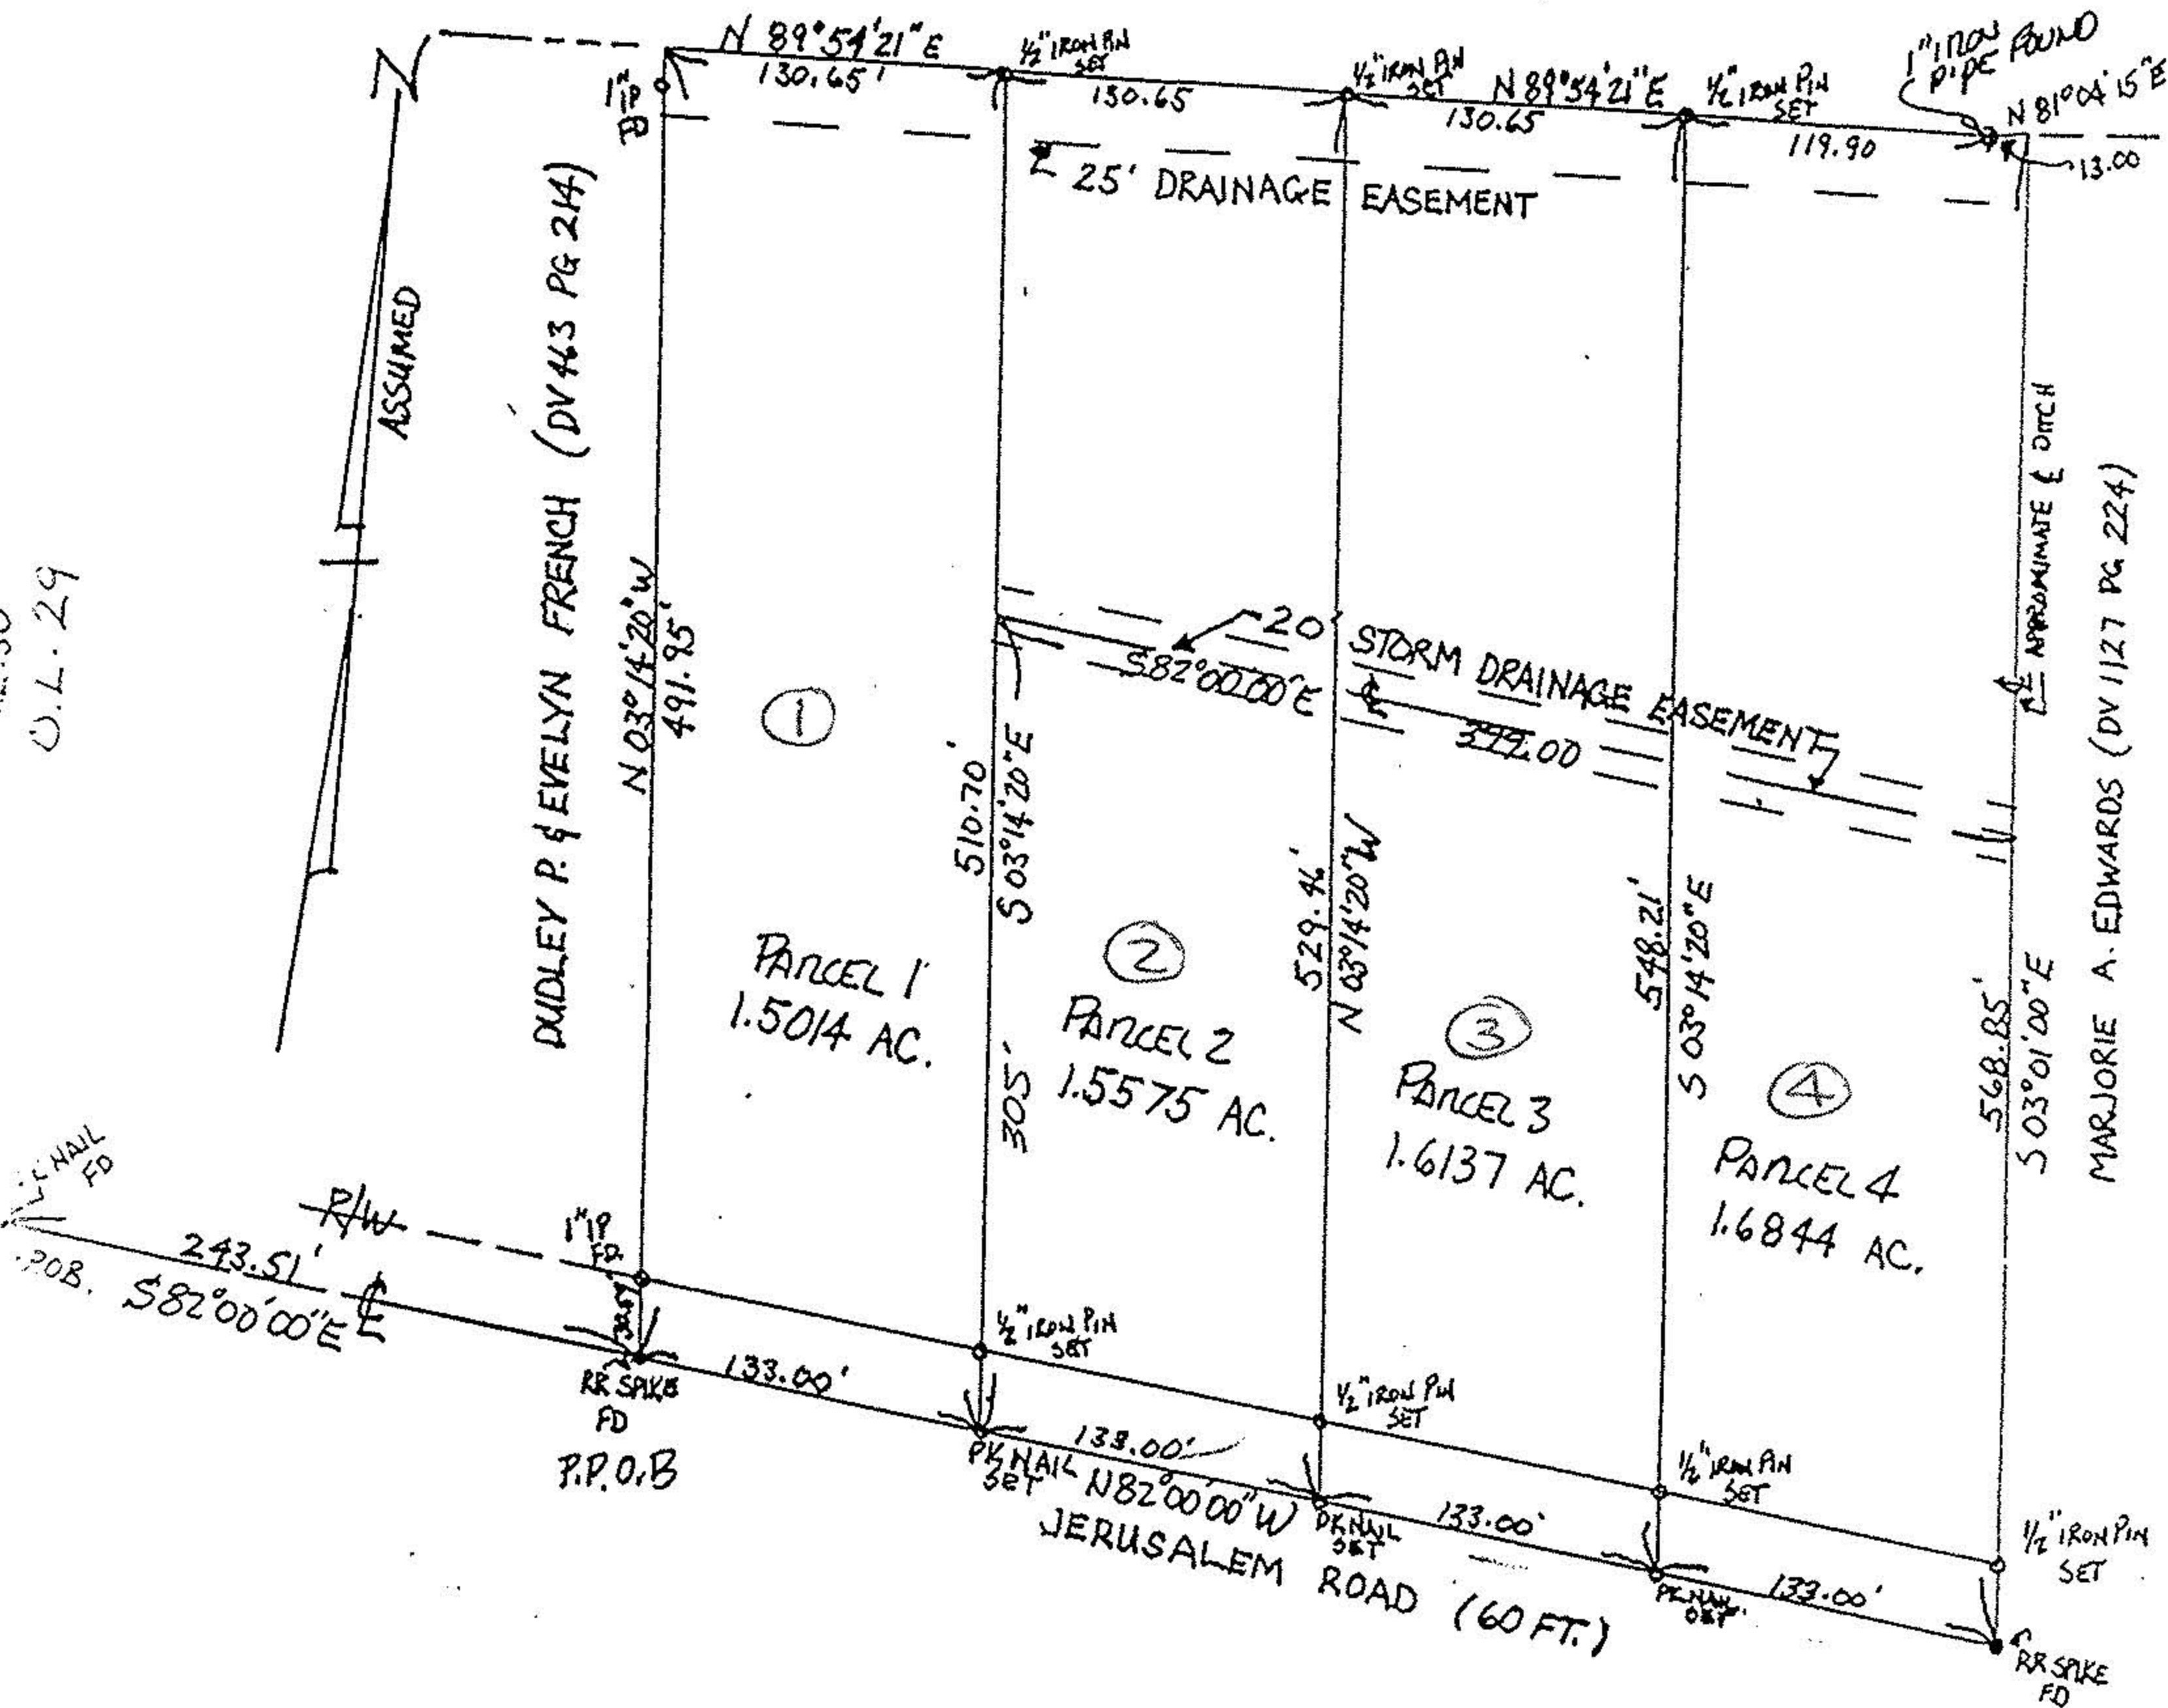

U.L. 29

PK NAIL
FD
243.51'
POB. S82°00'00"E


"SURVEY"
FOR
MELVIN PIPPERT

ORIGINAL LOT 29
CITY OF VERMILION
MARCH 1997
BROWNHELM TOWNSHIP
LORAIN COUNTY, OHIO
SCALE 1"=100'



I HEREBY CERTIFY THE WITHIN
TO BE A TRUE REPRESENTATION
OF A SURVEY MADE BY ME.

Daniel E. Hartung Jr.
DANIEL E. HARTUNG, JR. PE, PS

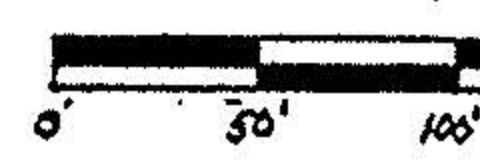

00210

| |
|---------------------|
| APPROVED |
| LORAIN CO. |
| MAP DEPT. |
| DATE 9-17-99 |
| PAGE 1-00-029A |
| BY D. Holland |
| VOID AFTER 99 00210 |

DN 01-00-029-000-037, -040 thru-044