



01-00-026-000  
 1-00-026-B  
 Pt. 022

10.12A

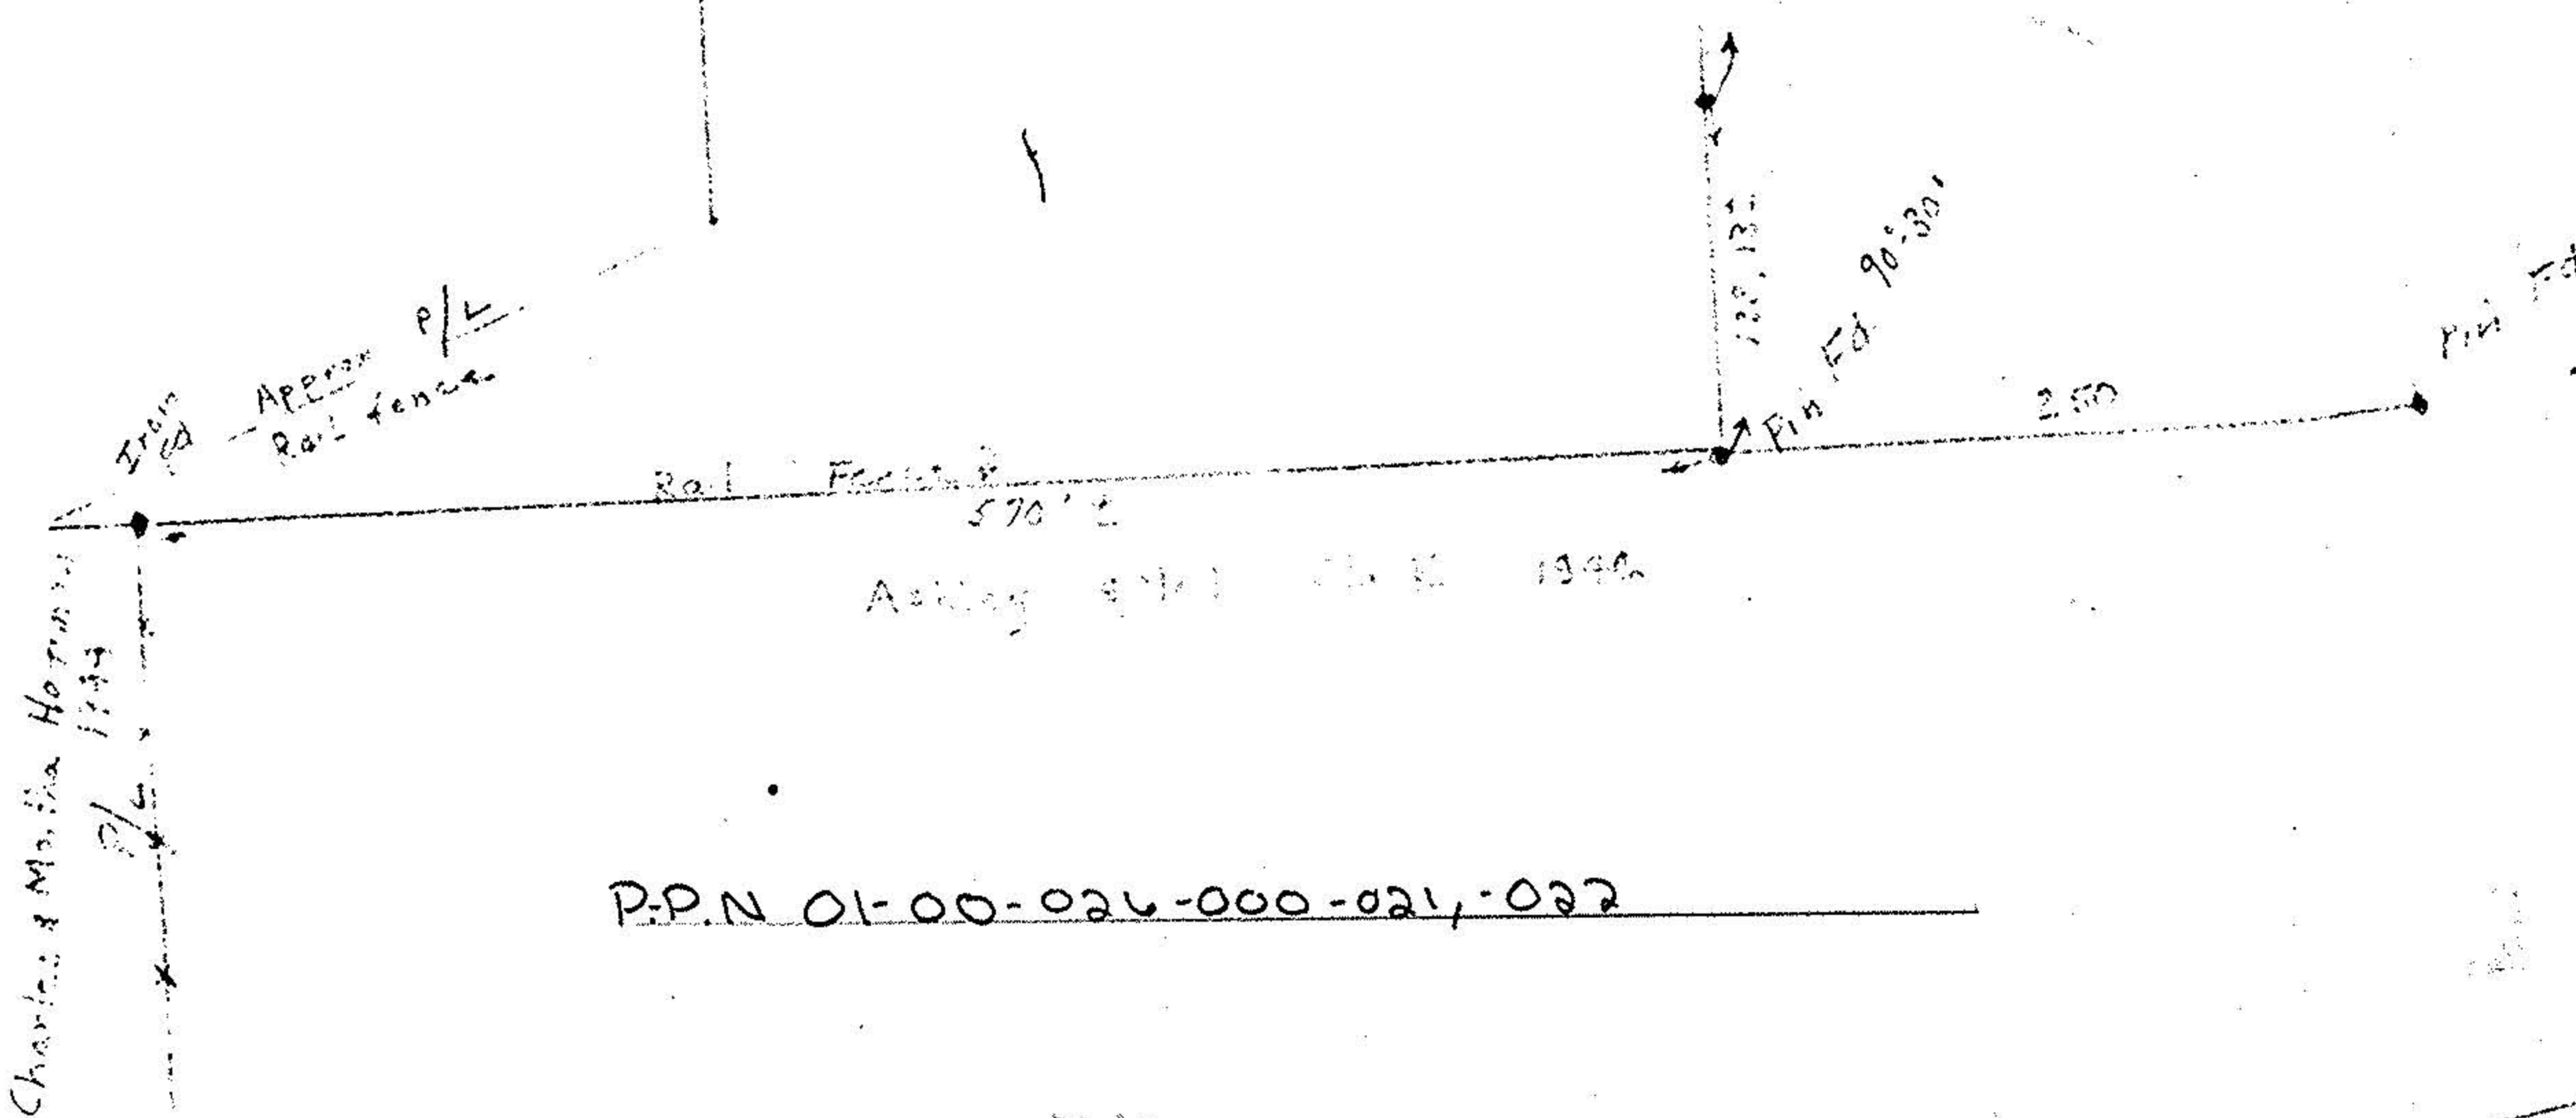

P.P.N 01-00-026-000-021, 022

Map of Partial Survey Lot 26 Brownhelm Twp. Lorain Co. Ohio Scale 1" = 100'  
 June 23, 1973 By Arnold F. Koopp Registered Surveyor No. 4306

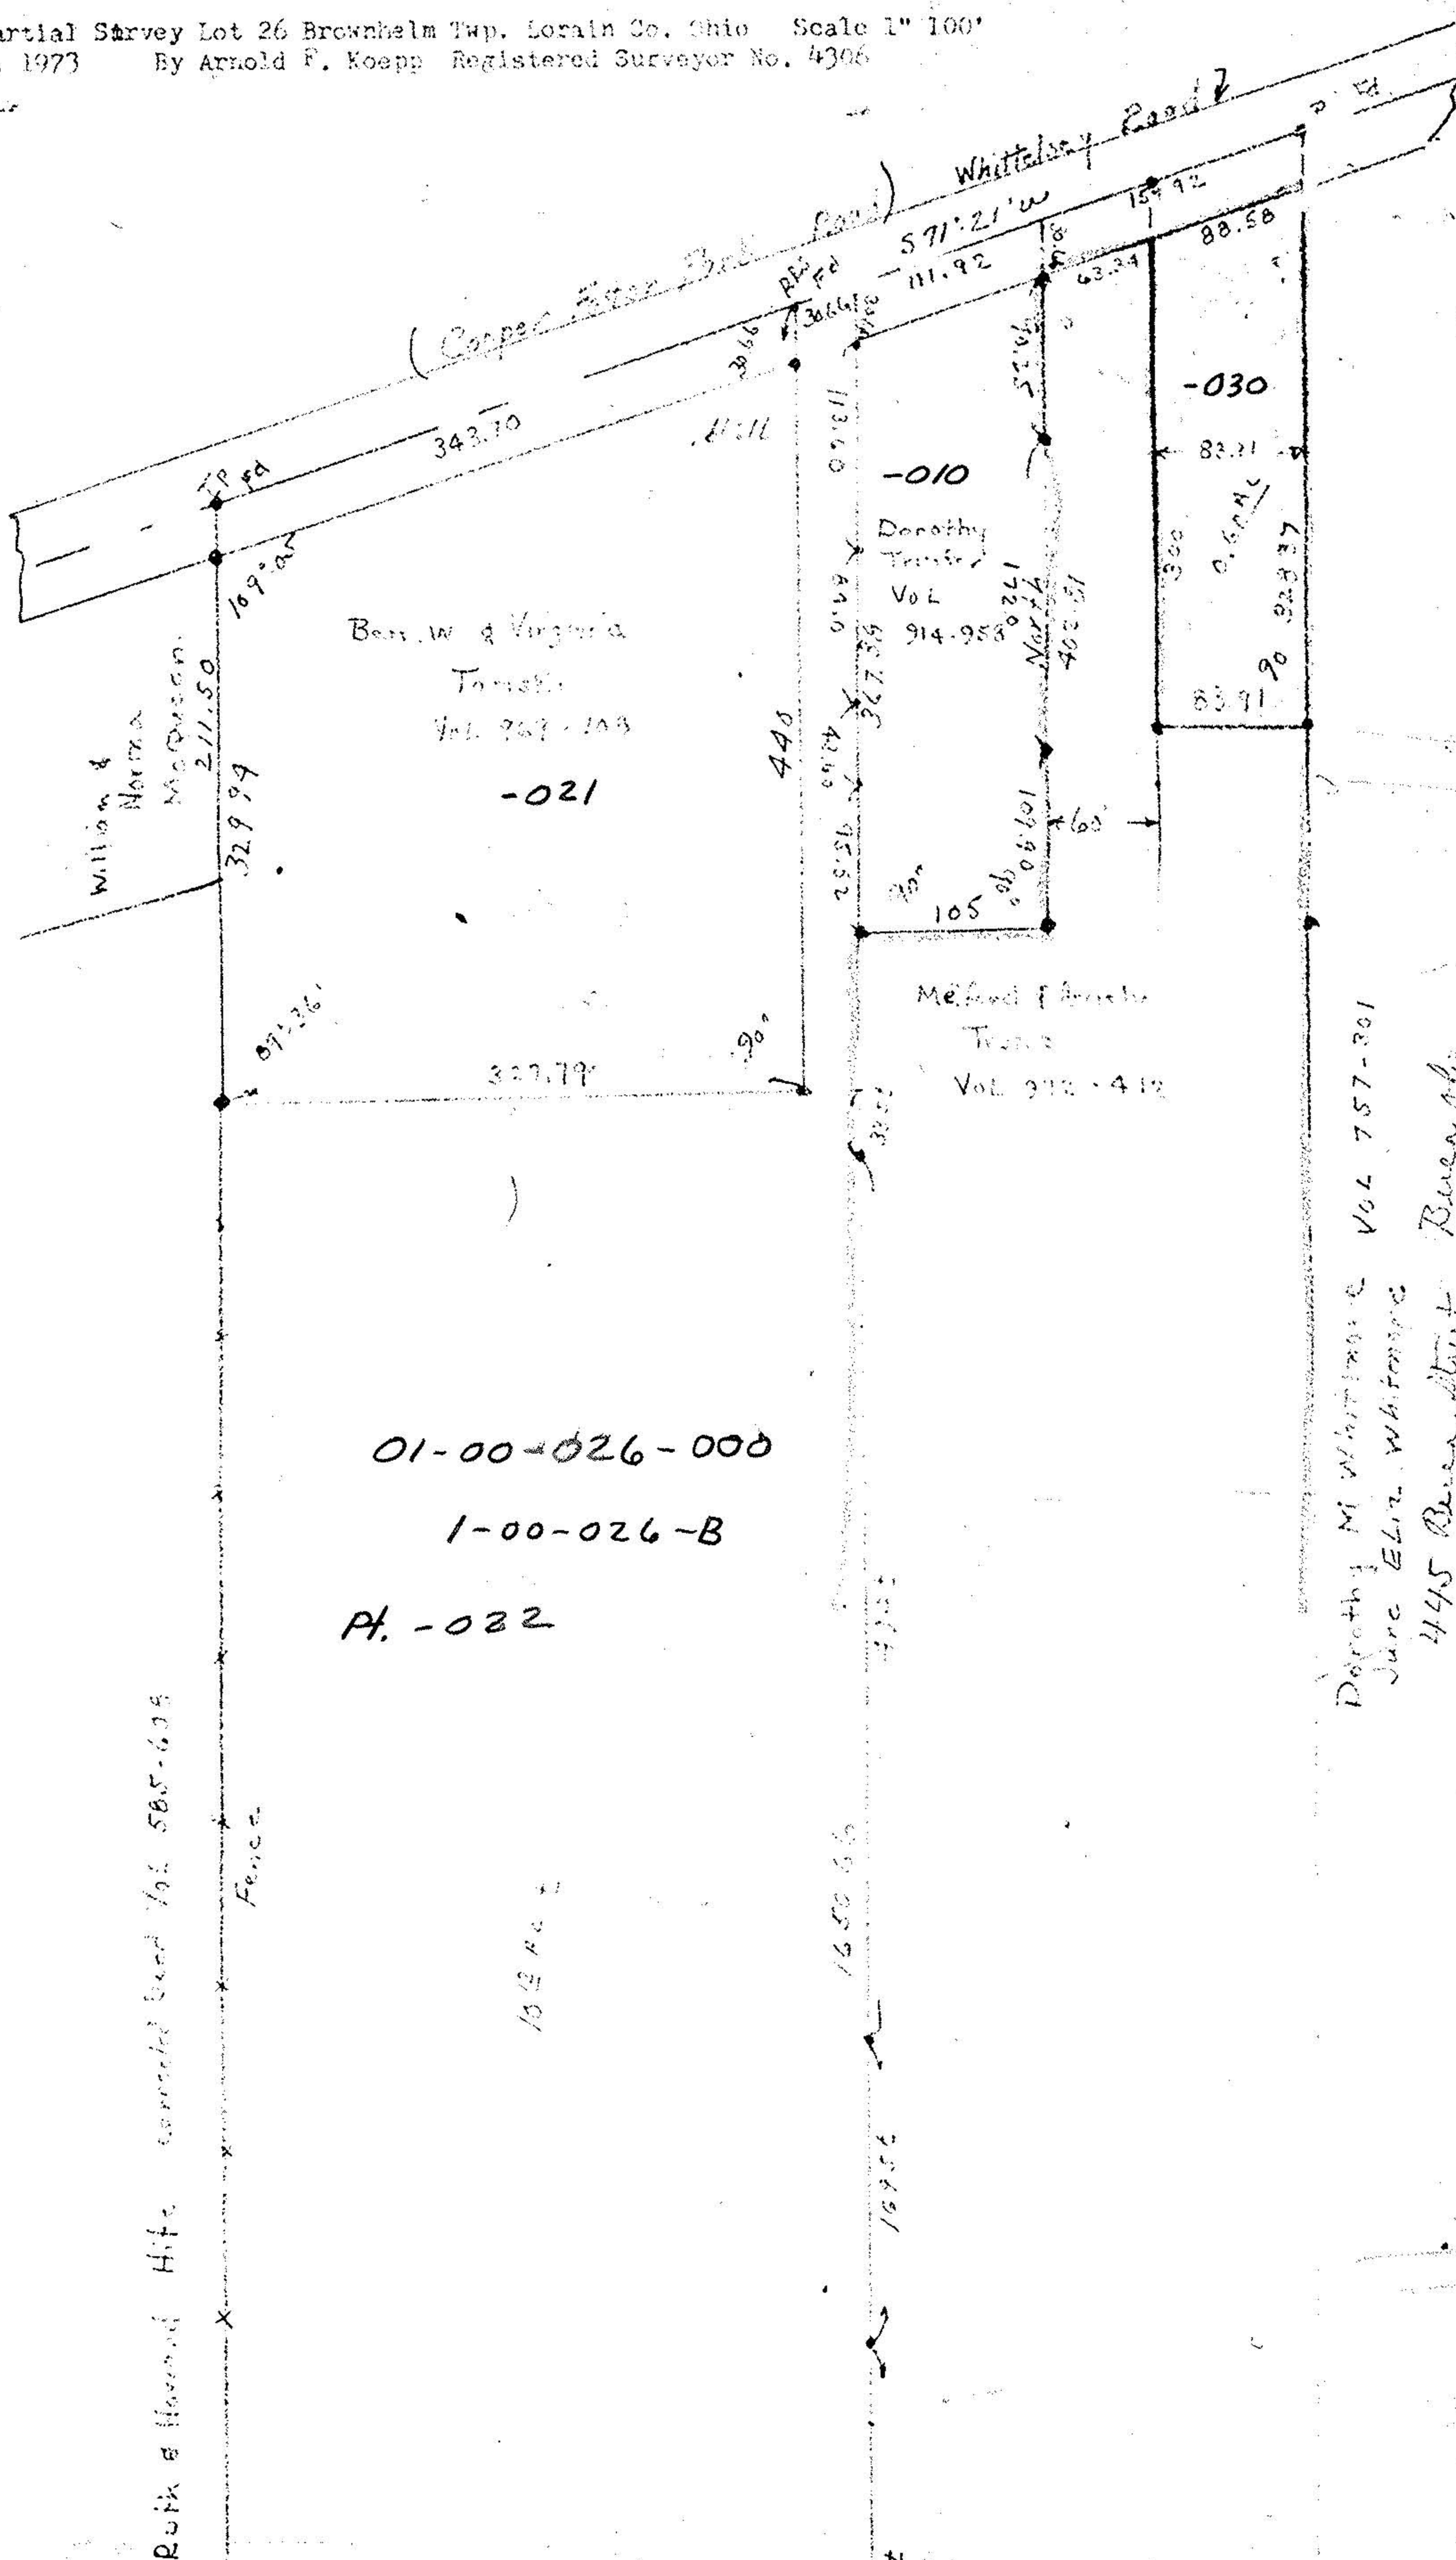

01-00-026-000  
 1-00-026-B  
 Pt. -022

Ruth & Howard Hife consold land Vol 585-604

Dorothy M Whitman Vol 757-301  
 June Eliz Whitman  
 445 Bevan Street River 06