

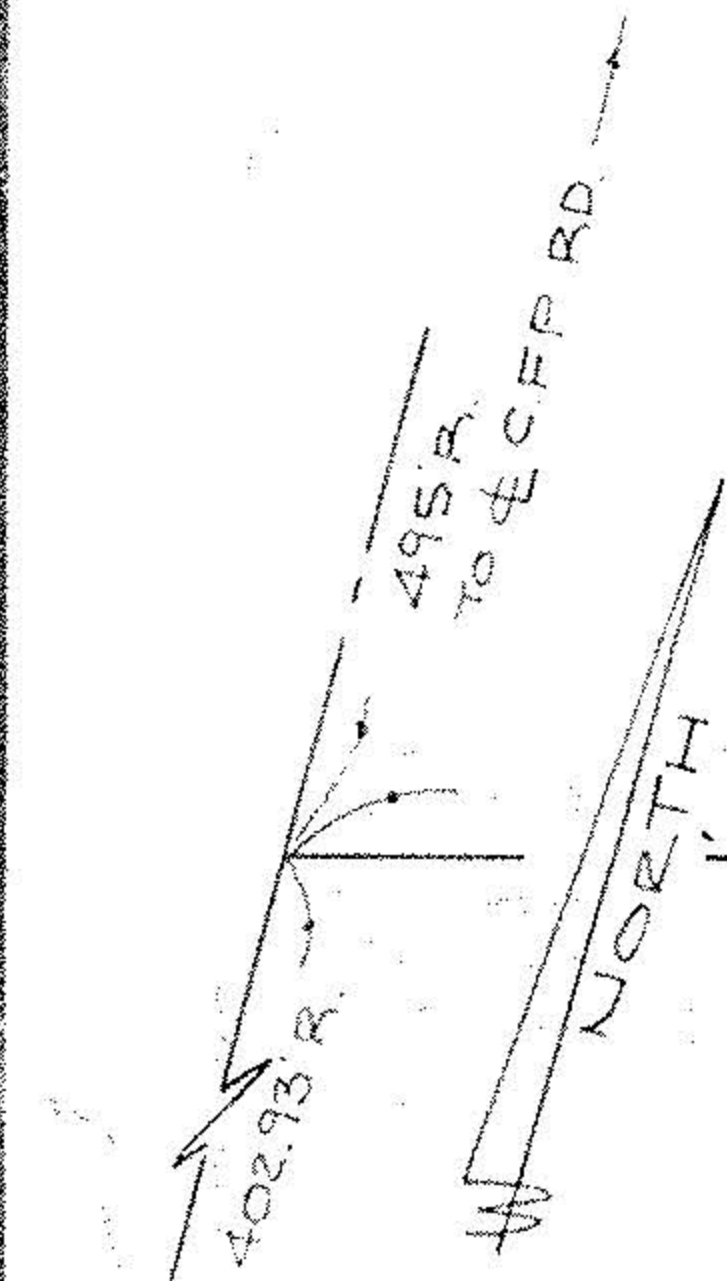


COOPER FOSTER PARK ROAD (A.K.A. WHITTLESEY ROAD)

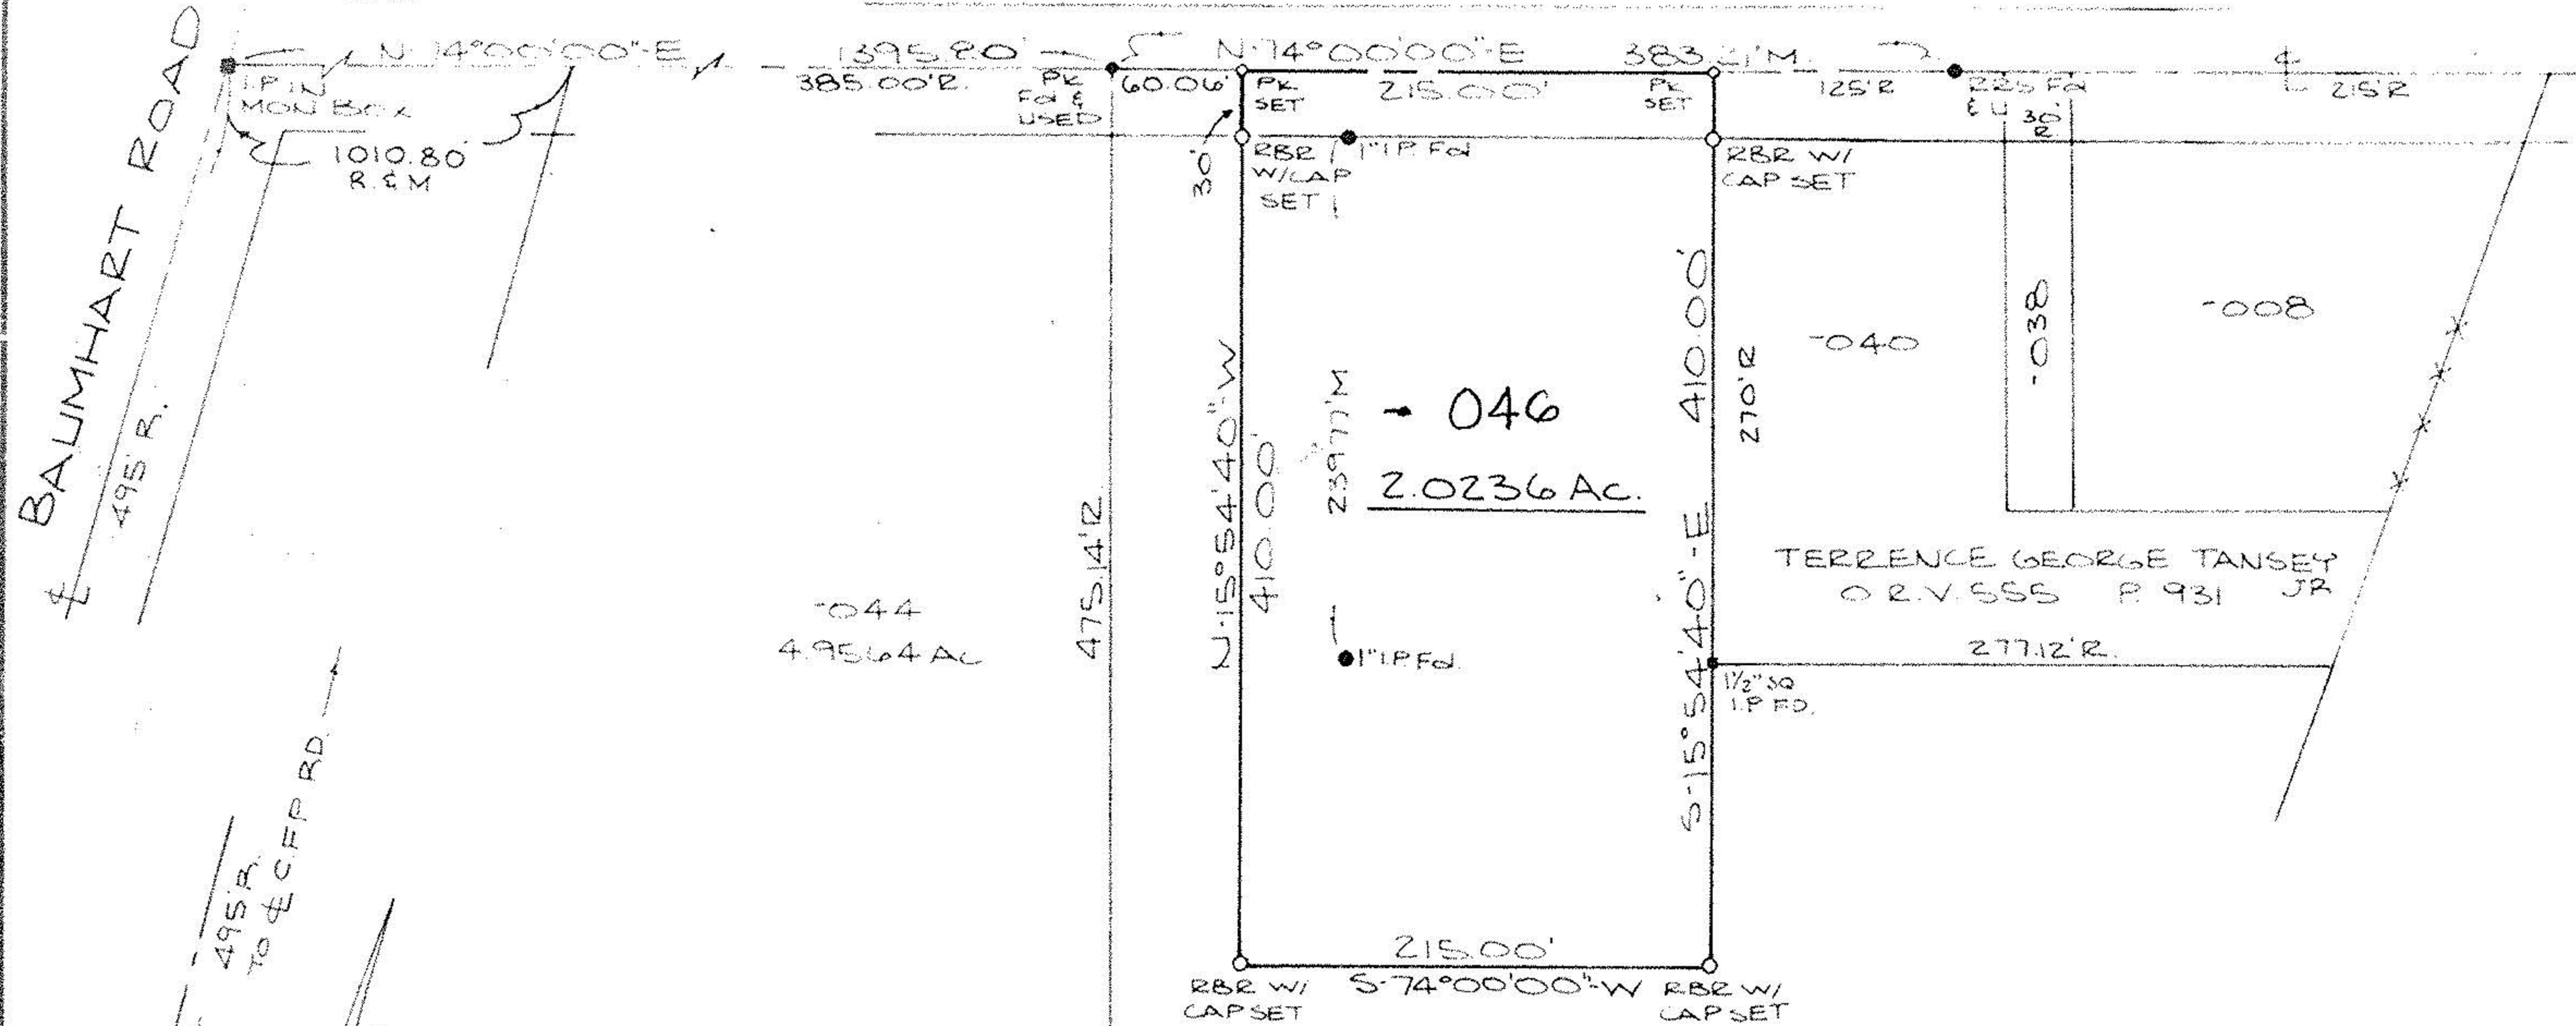

1534.59 R.

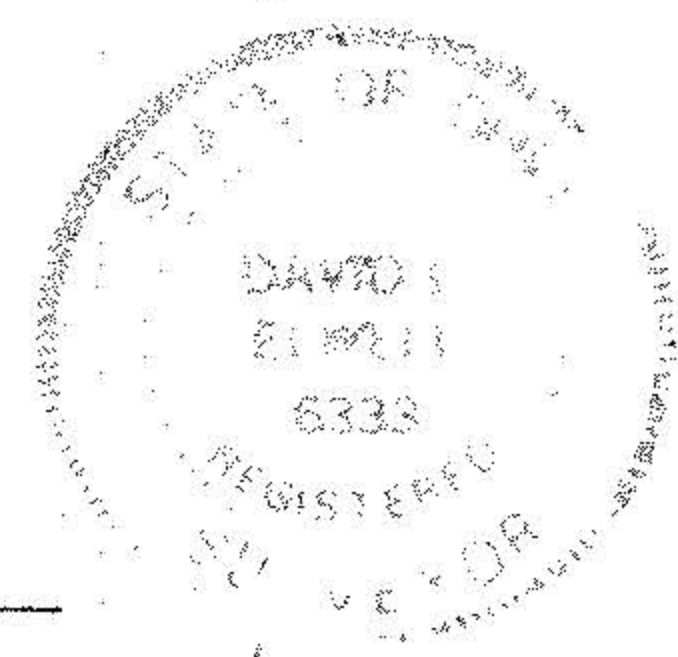

SCALE: 1"=100'

S. LINE OL 26



CLAYTON W. HITE  
 D.V. 1165 P. 160 P. 1#2  
 (01-00-026-000-045)  
 33.53 AC ± REM 047

**P.P.N 01-00-026-000-046**

*David L. Elwell*  
 DAVID L. ELWELL  
 REG. SURVEYOR NO. 6333

**SURVEY MAP**

PART OF BROWNHELM TOWNSHIP  
 ORIGINAL LOT NO. 26  
 TOWNSHIP OF BROWNHELM  
 COUNTY OF LORAIN STATE OF OHIO  
 JULY 27, 1994

PREPARED BY:  
**KS ASSOCIATES INC.**  
 ENGINEERS SURVEYORS