




LAUNDON . SIMON . CAHL & ASSOC. INC.
 CONSULTING ENGINEERS & SURVEYORS
 219 COURT ST. ELYRIA, OHIO 44035

SURVEY FOR:

BERNARD N. & KAREN KALK

Orig. Lot 37	City of	Date 3 rd JUNE '86 Scale 1" = 150'
Orig. Sec	Village of	Dwn. by R.G.S. Chkd. by
Tract	County of LORAIN	Job No. 86-1467 F.B. —
Township of BROWNHELM	State of OHIO	Printed

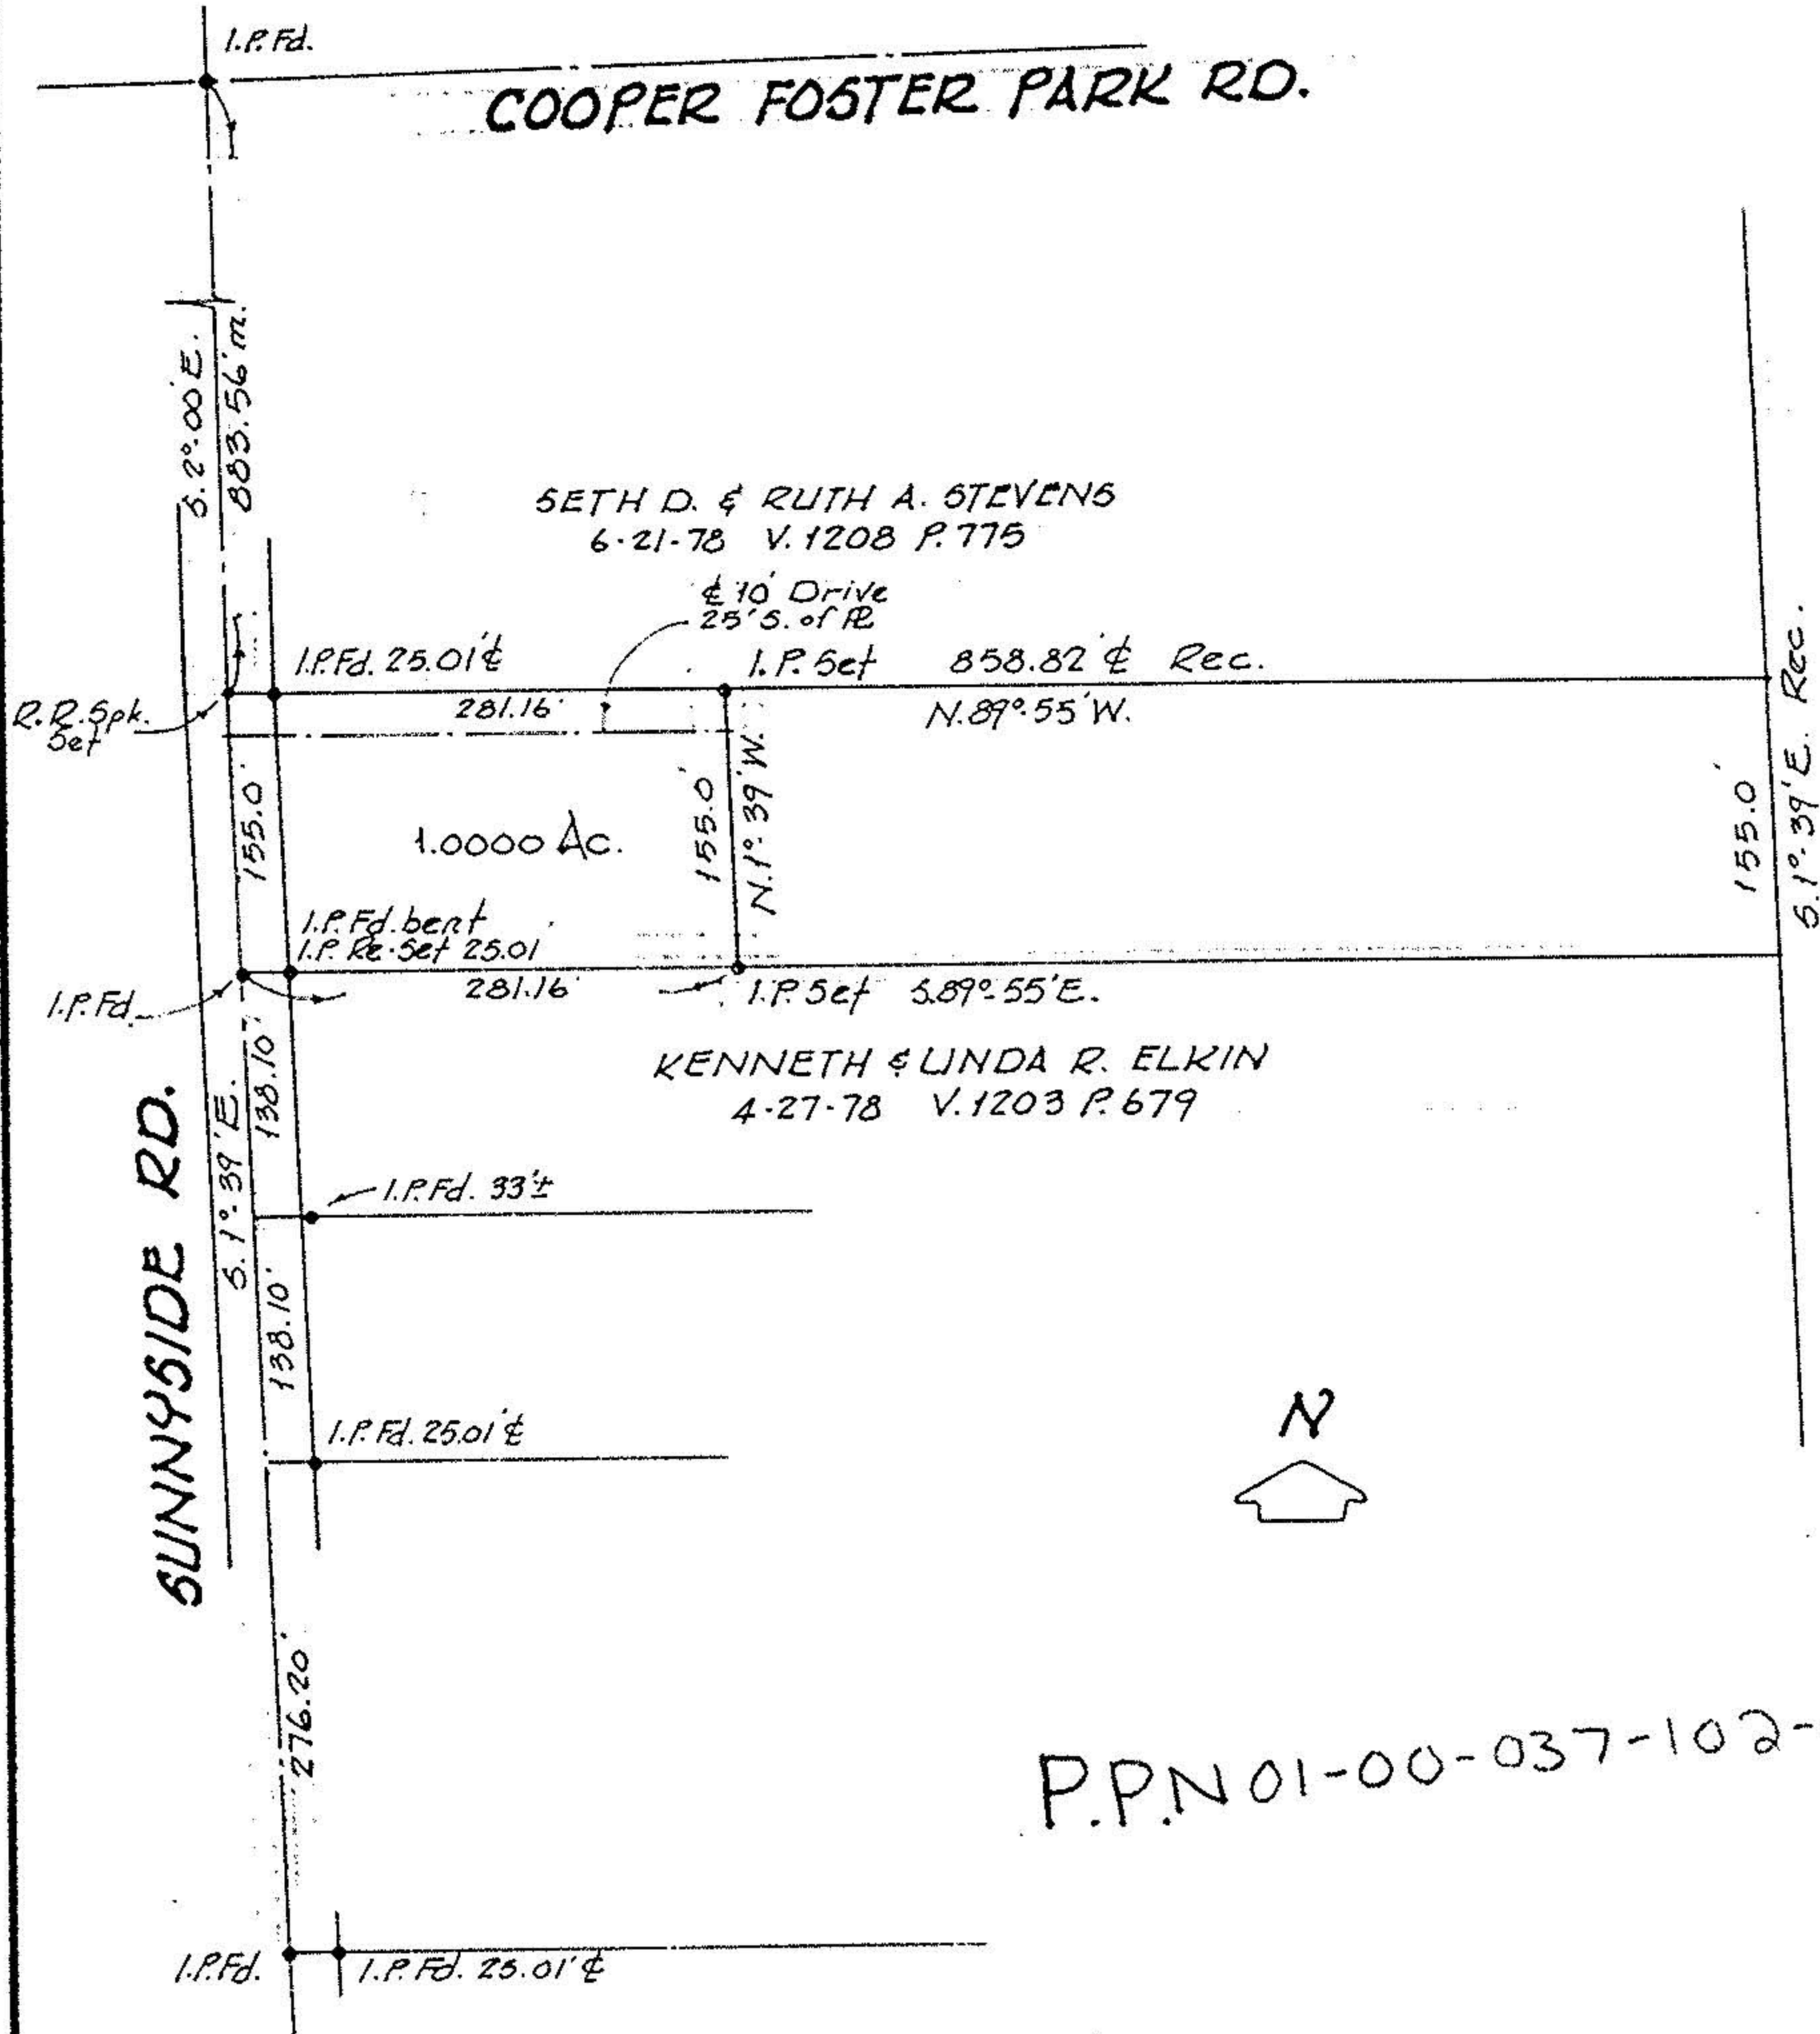

P.P.N 01-00-037-102-004