


Survey Map of Part of O.L. 44 Brownhelm Twp. Lorain Co. Ohio
 Oct. 28, 1987 By Arnold F. Koeppe Reg. Surveyor No. 4306

Scale 1" = 200'

01-00-044-000-033

#17775

1-00-044-A, B

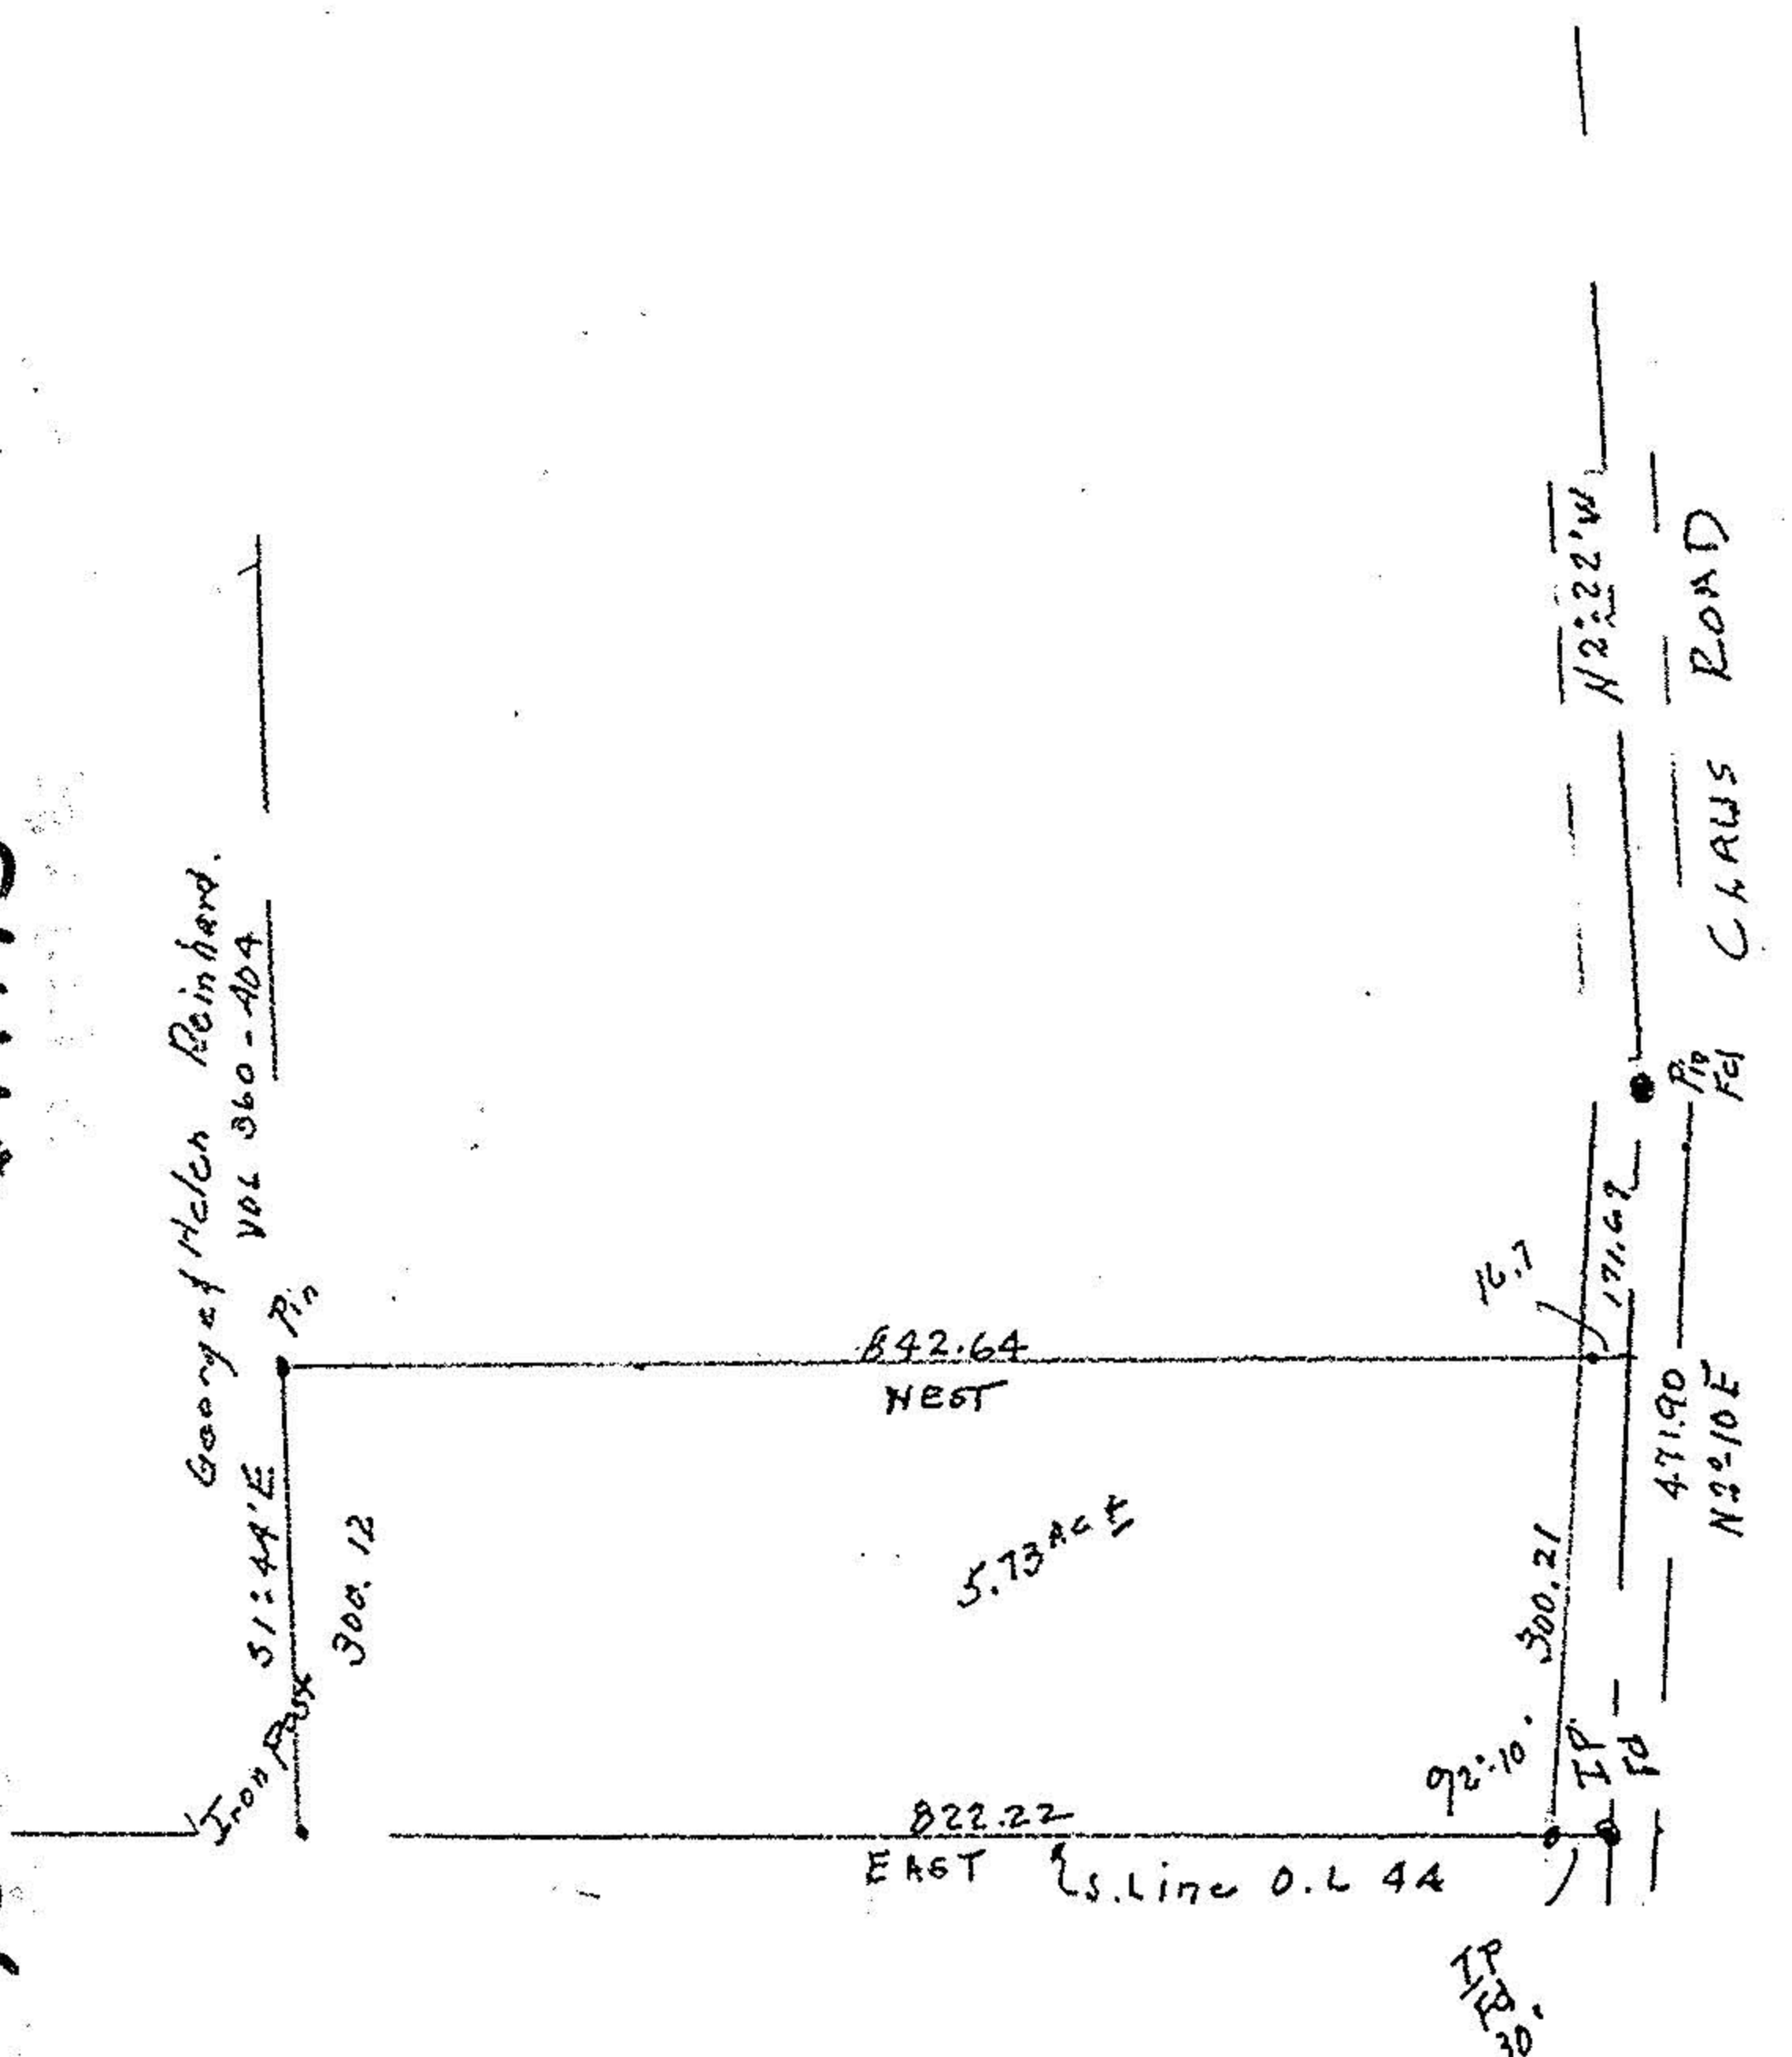

#17775

APPROVED LORAIN CO. MAP DEPT.	
DATE 11-23-87	
PAGE 1-00-044	A B
BY Carol-Francis	
VOID AFTER	17775