


01-00-044-000-036

#18401

1-00-044-A, B

Map of Part of O.L. 44 Brownhelm Twp. And Vermilion City Lorain Co. Ohio
Scale 1" = 200'
March 17, 1988
By Arnold F. Koepf Reg. Surveyor No. 4306

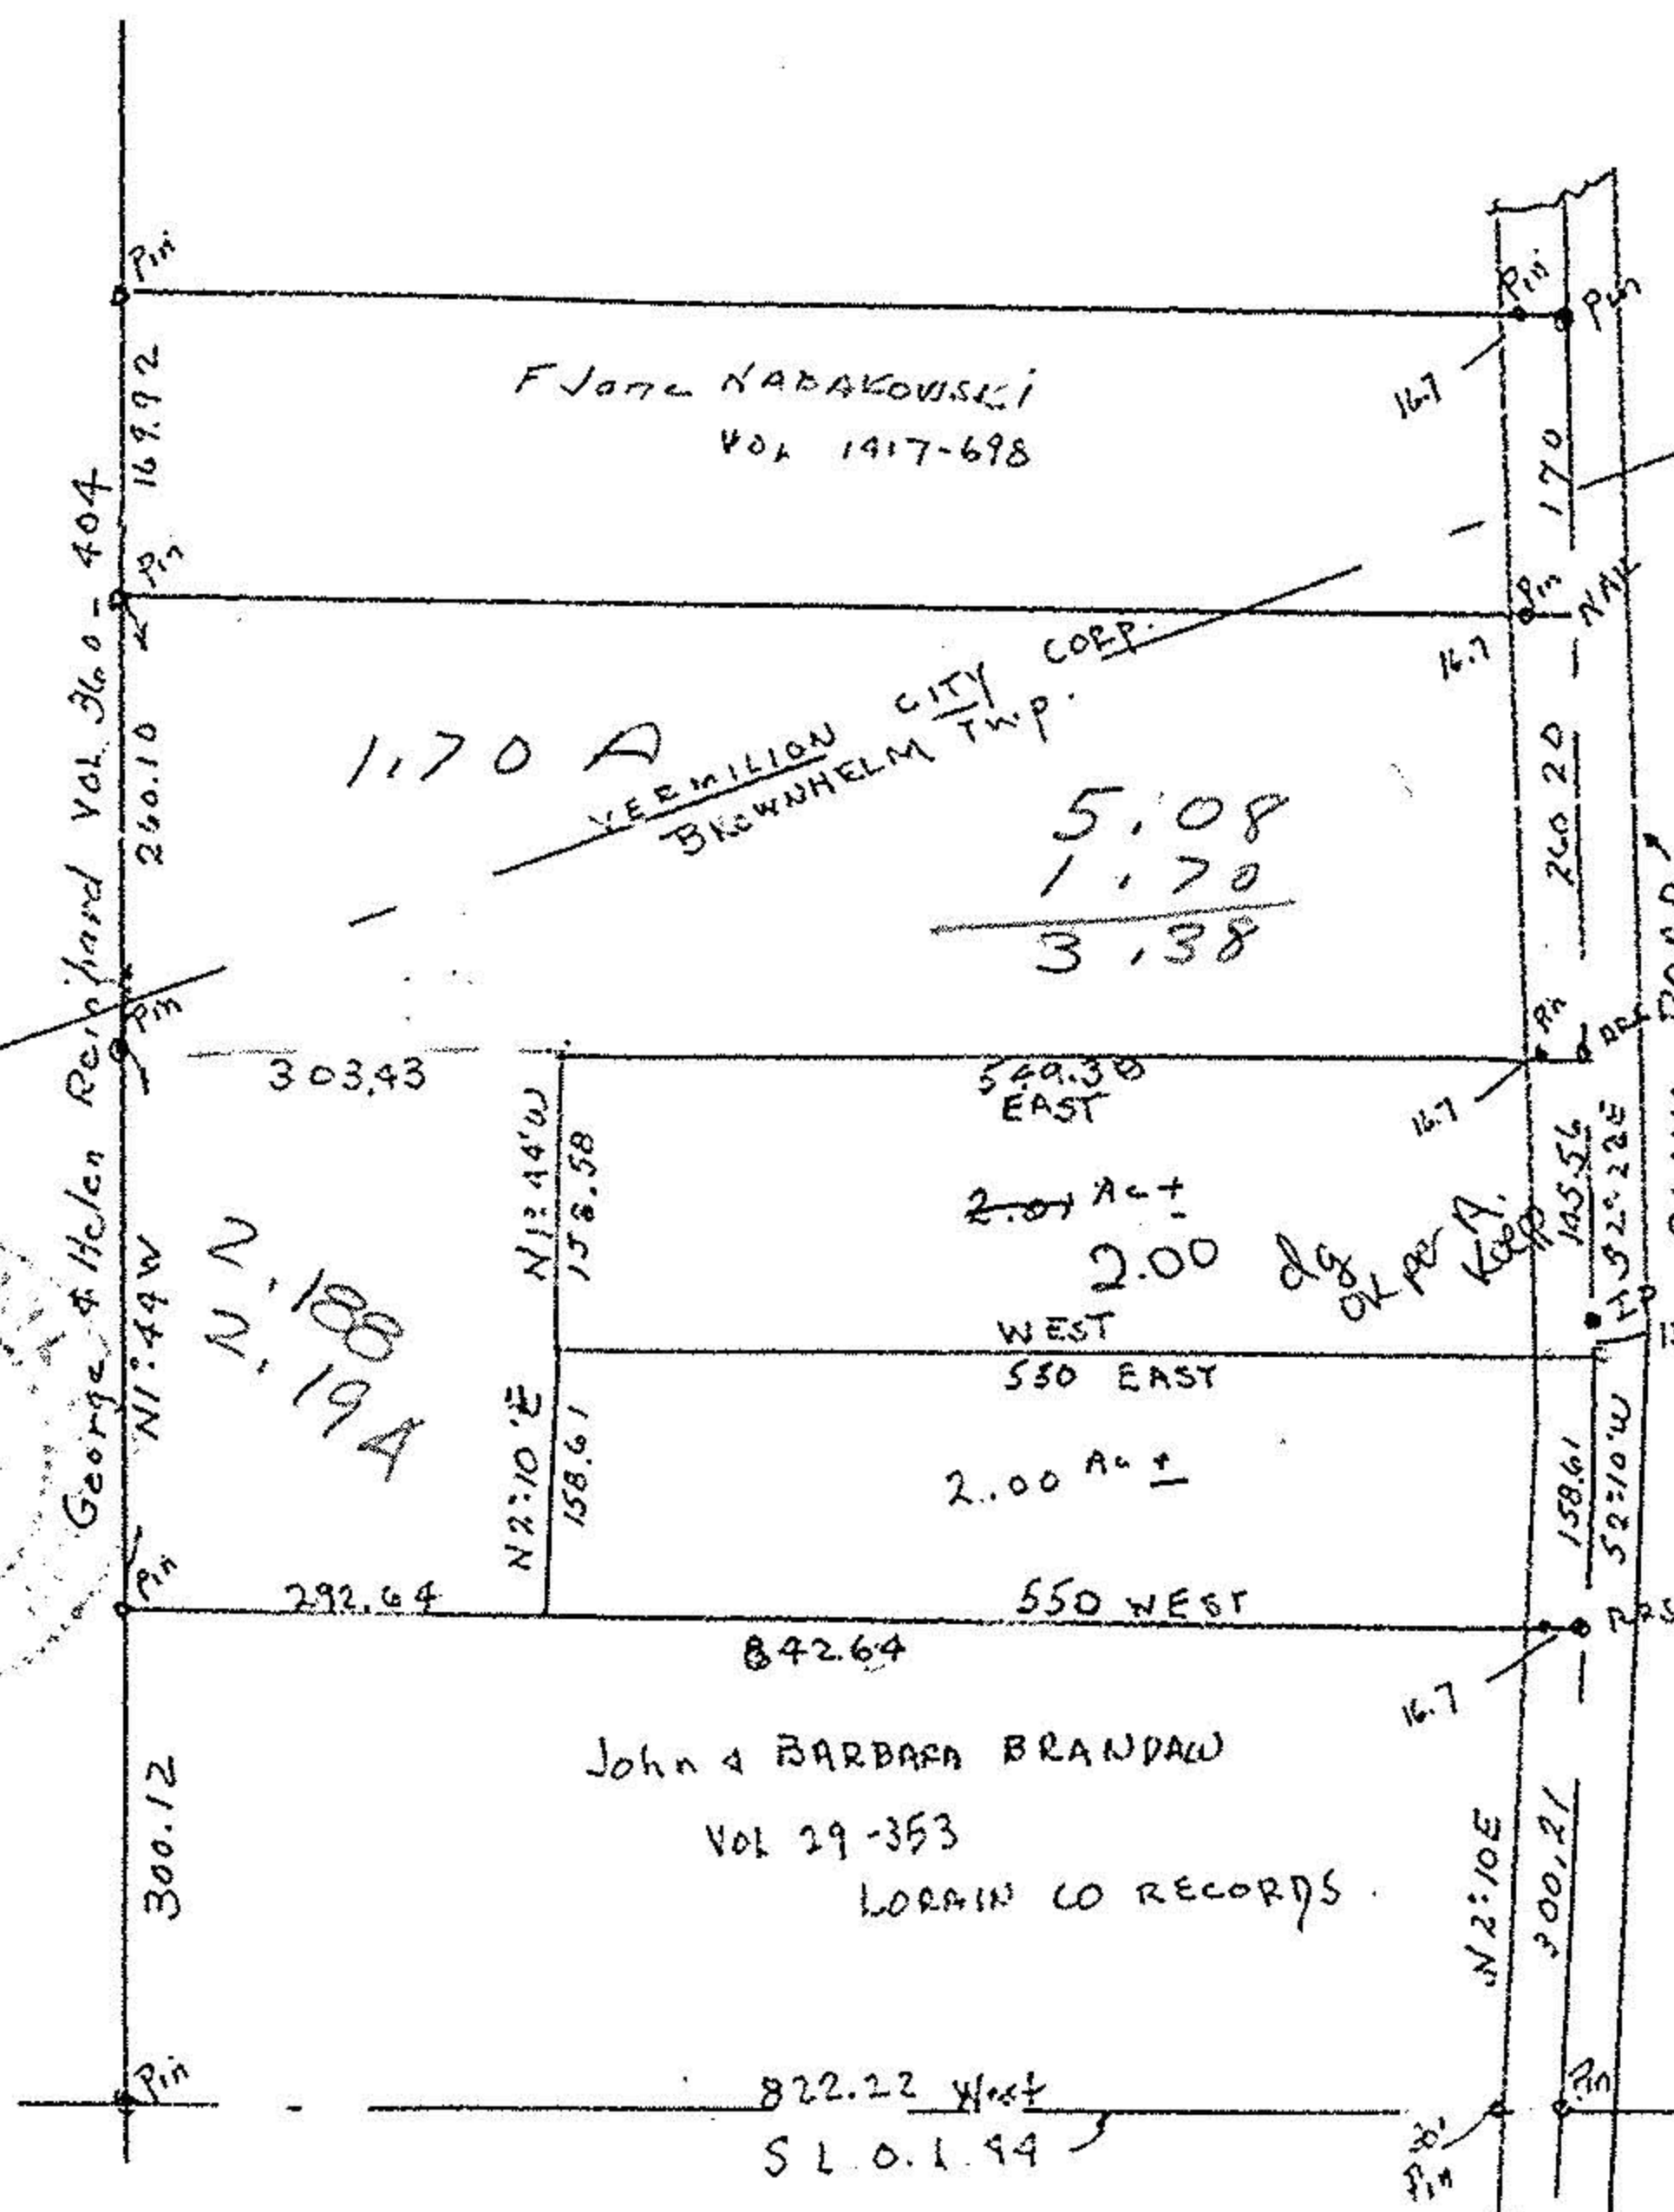

3.38
2.19

5.57

#18401

APPROVED
LORAIN CO.
MAP DEPT.

DATE 4-26-89

PAGE 1-00-044-

BY CAROL-FRANCIS

VOID AFTER #18401

A
B