

Map of Part of O.L. 44 Brownhelm Twp. And Vermilion City Lorain Co. Ohio

Scale 1" = 200'

March 17, 1988


By Arnold F. Koeppe Reg. Surveyor No. 4306

01-00-044-000

#18401

01-00-044-A & B

01-00-044-000-037

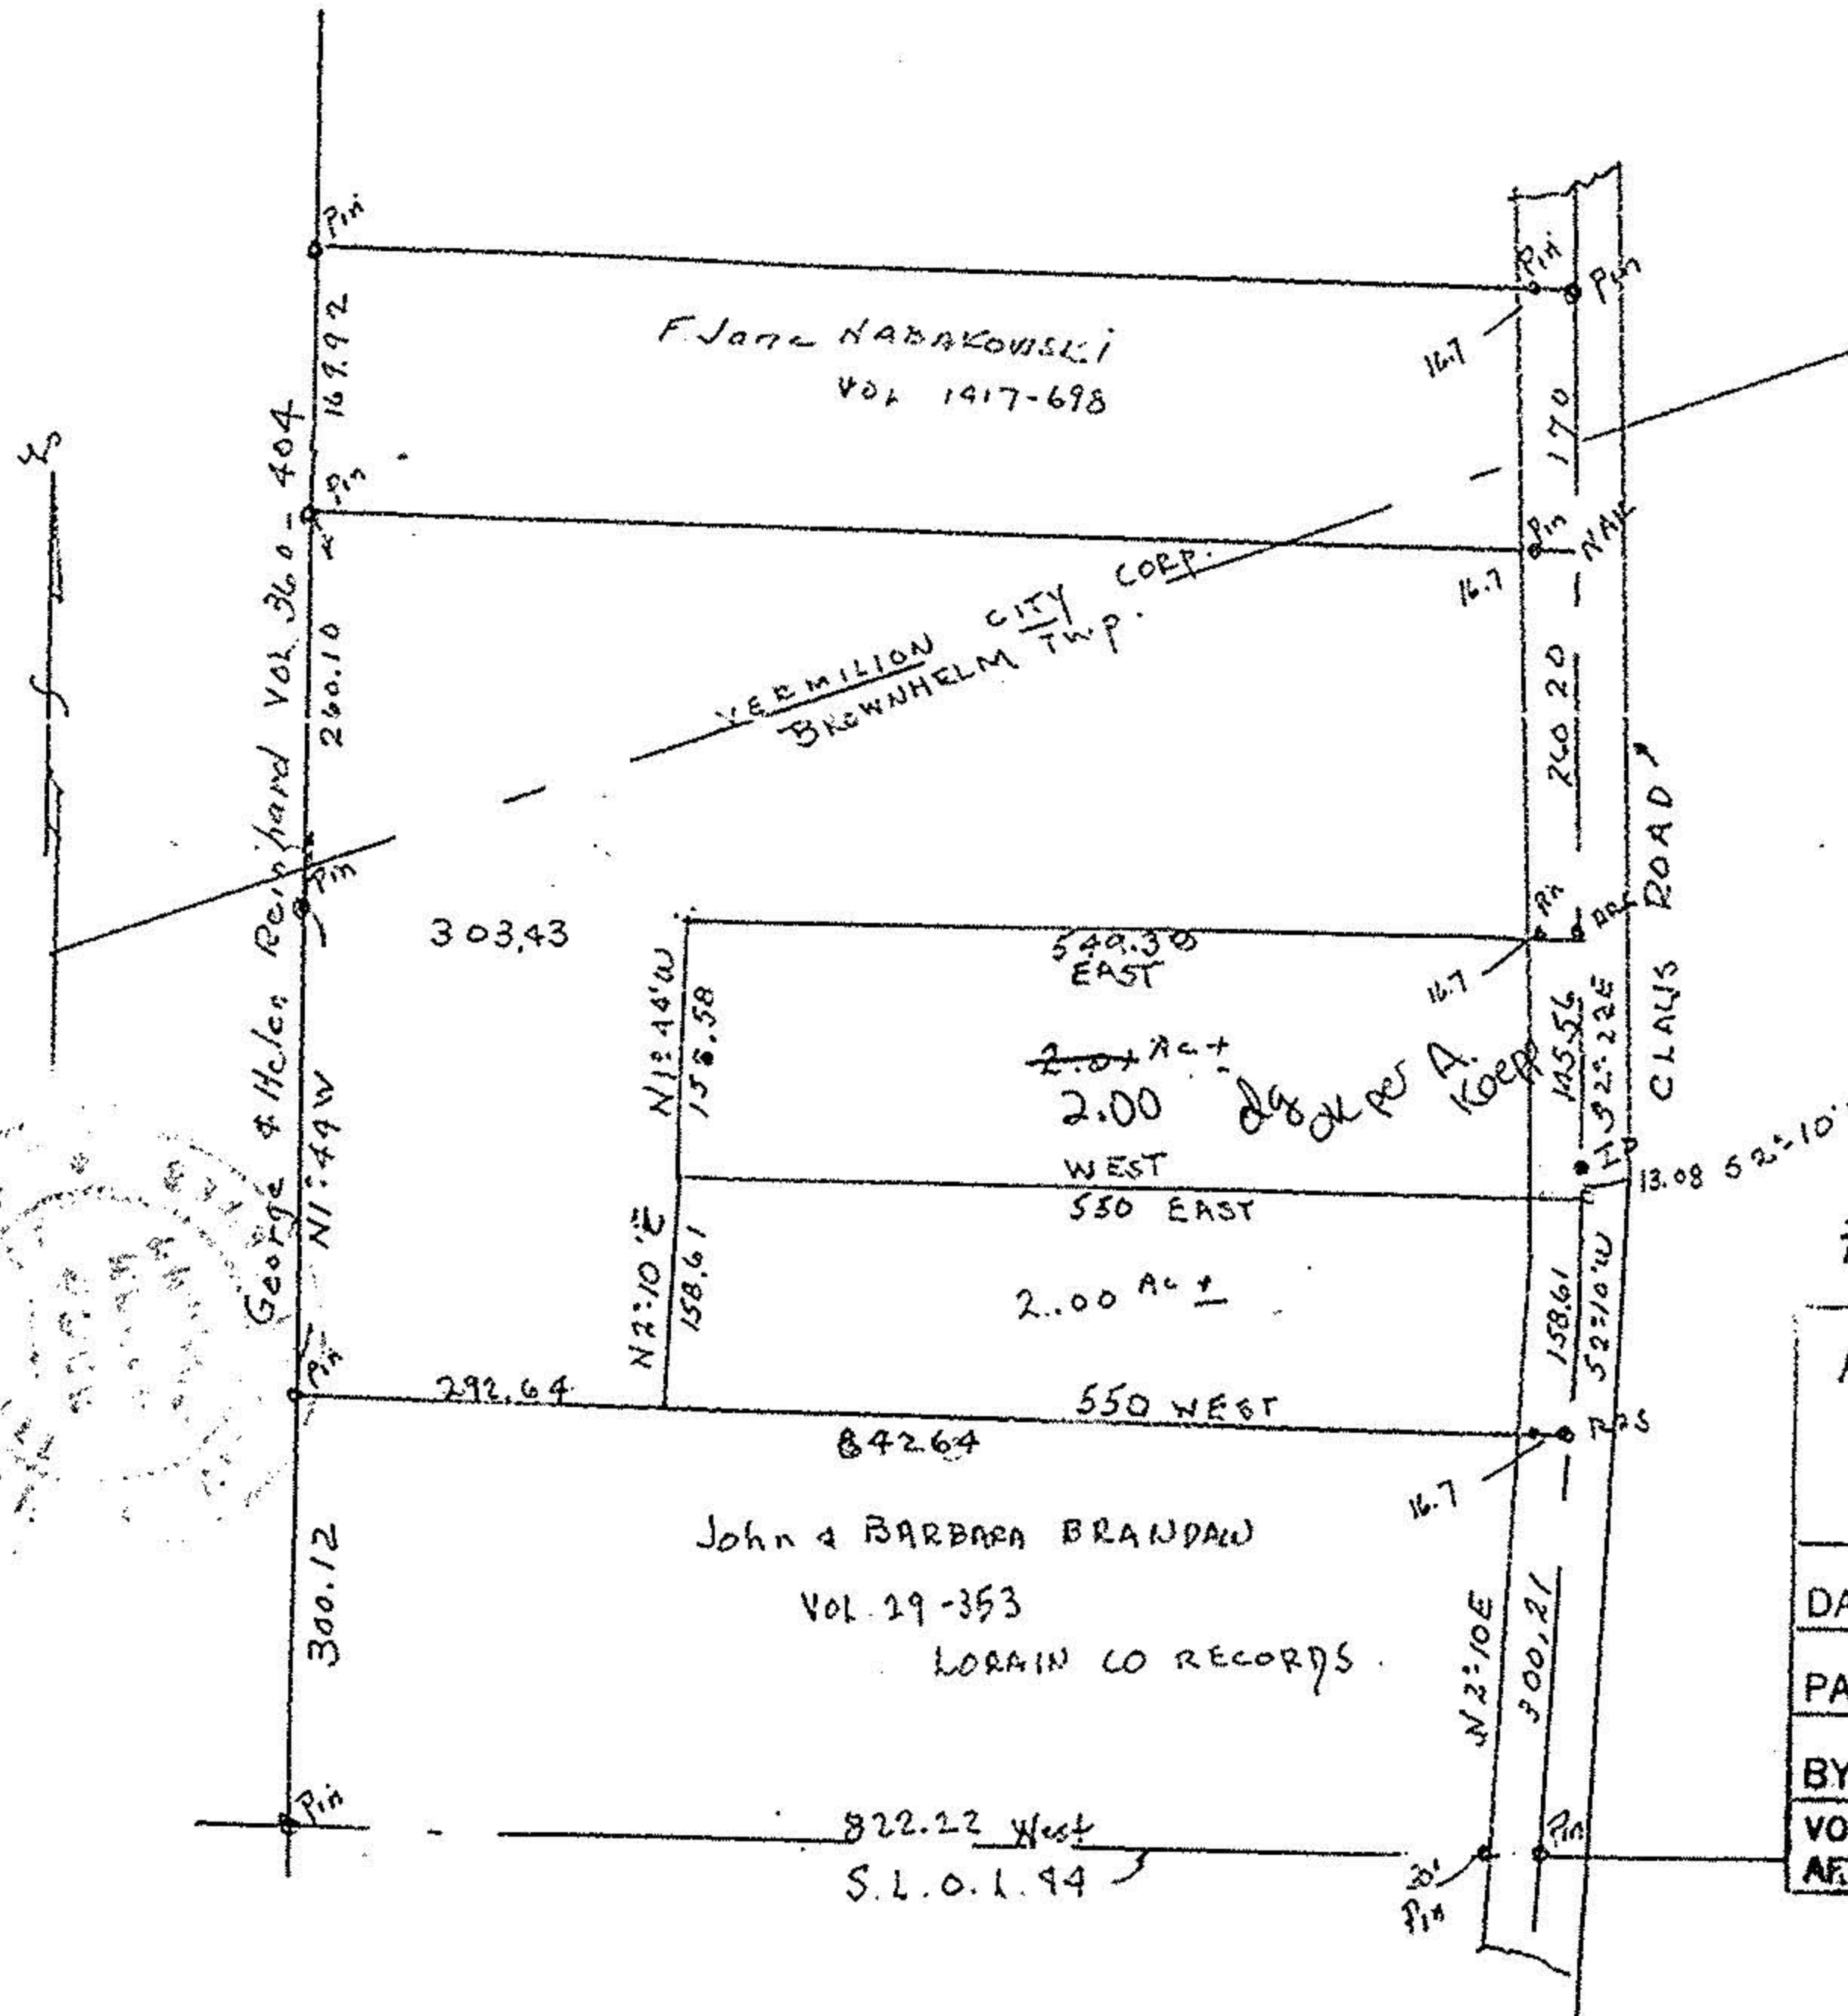

#18401

APPROVED LORAIN CO. MAP DEPT.
DATE 4-26-89
PAGE 1-00-044-
BY CAROL-FRANZIS
VOID AFTER #18401

A  
B