

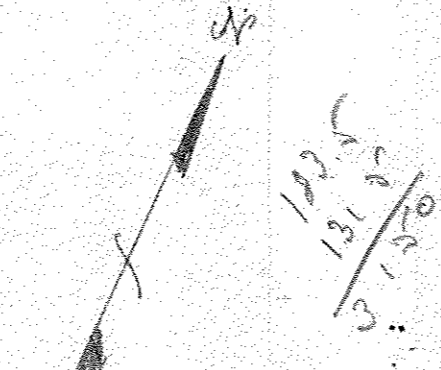


P.P.N 01-00-051-000-007

Survey part of O.L. 51 Brownhelm Twp. Lorain Co.
 for Berk Realty Co. Vermilion, Ohio
 Scale 1" = 100' June 1, 1961
 By Arnold F. Koepp Registered Surveyor No. 4306

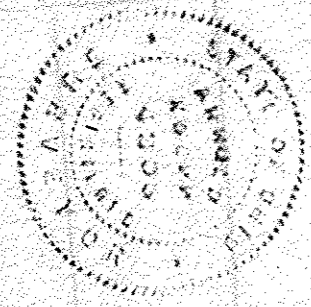

Grove's Ruth
 Cook
 Vol. 376-301

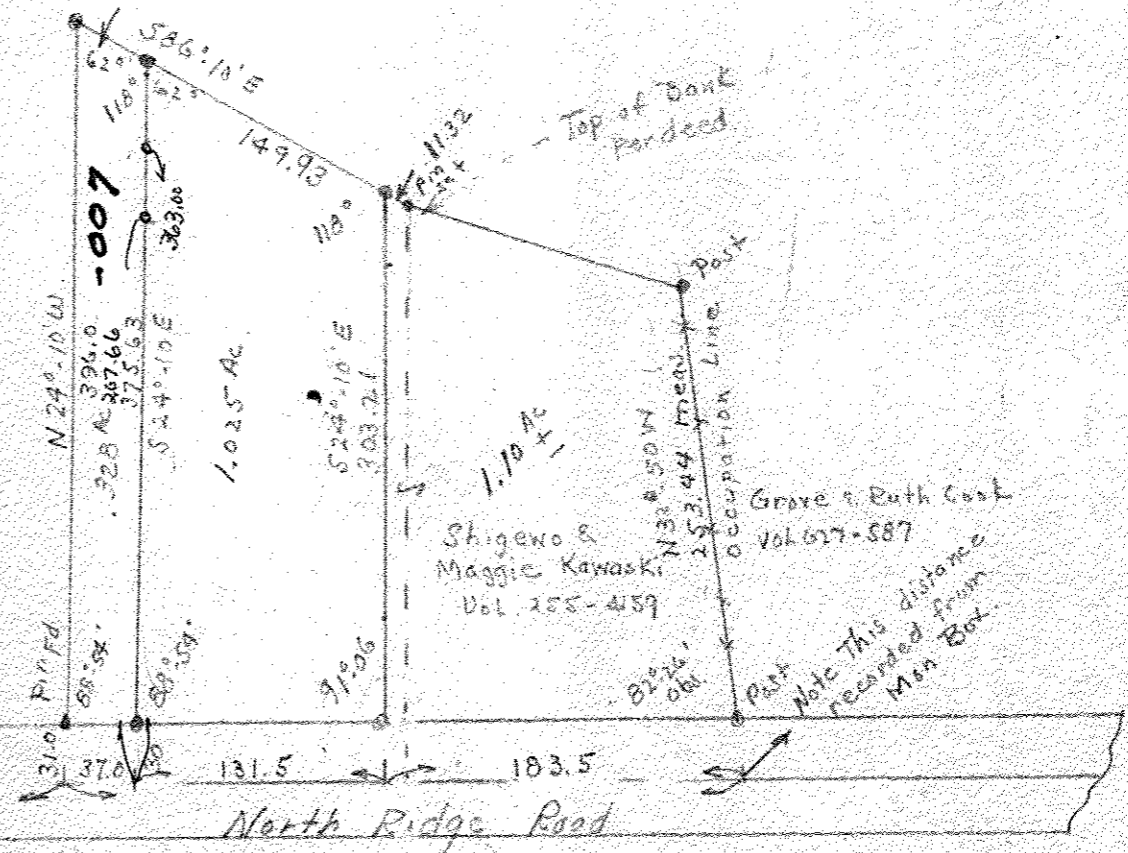

Total acreage 2.95 AC
 " " 2.75 AC Deed
 Shortage 0.30 AC

