


P.P.N 01-00-064-000-059

- monument box
- iron pipes fd
- iron pipes set

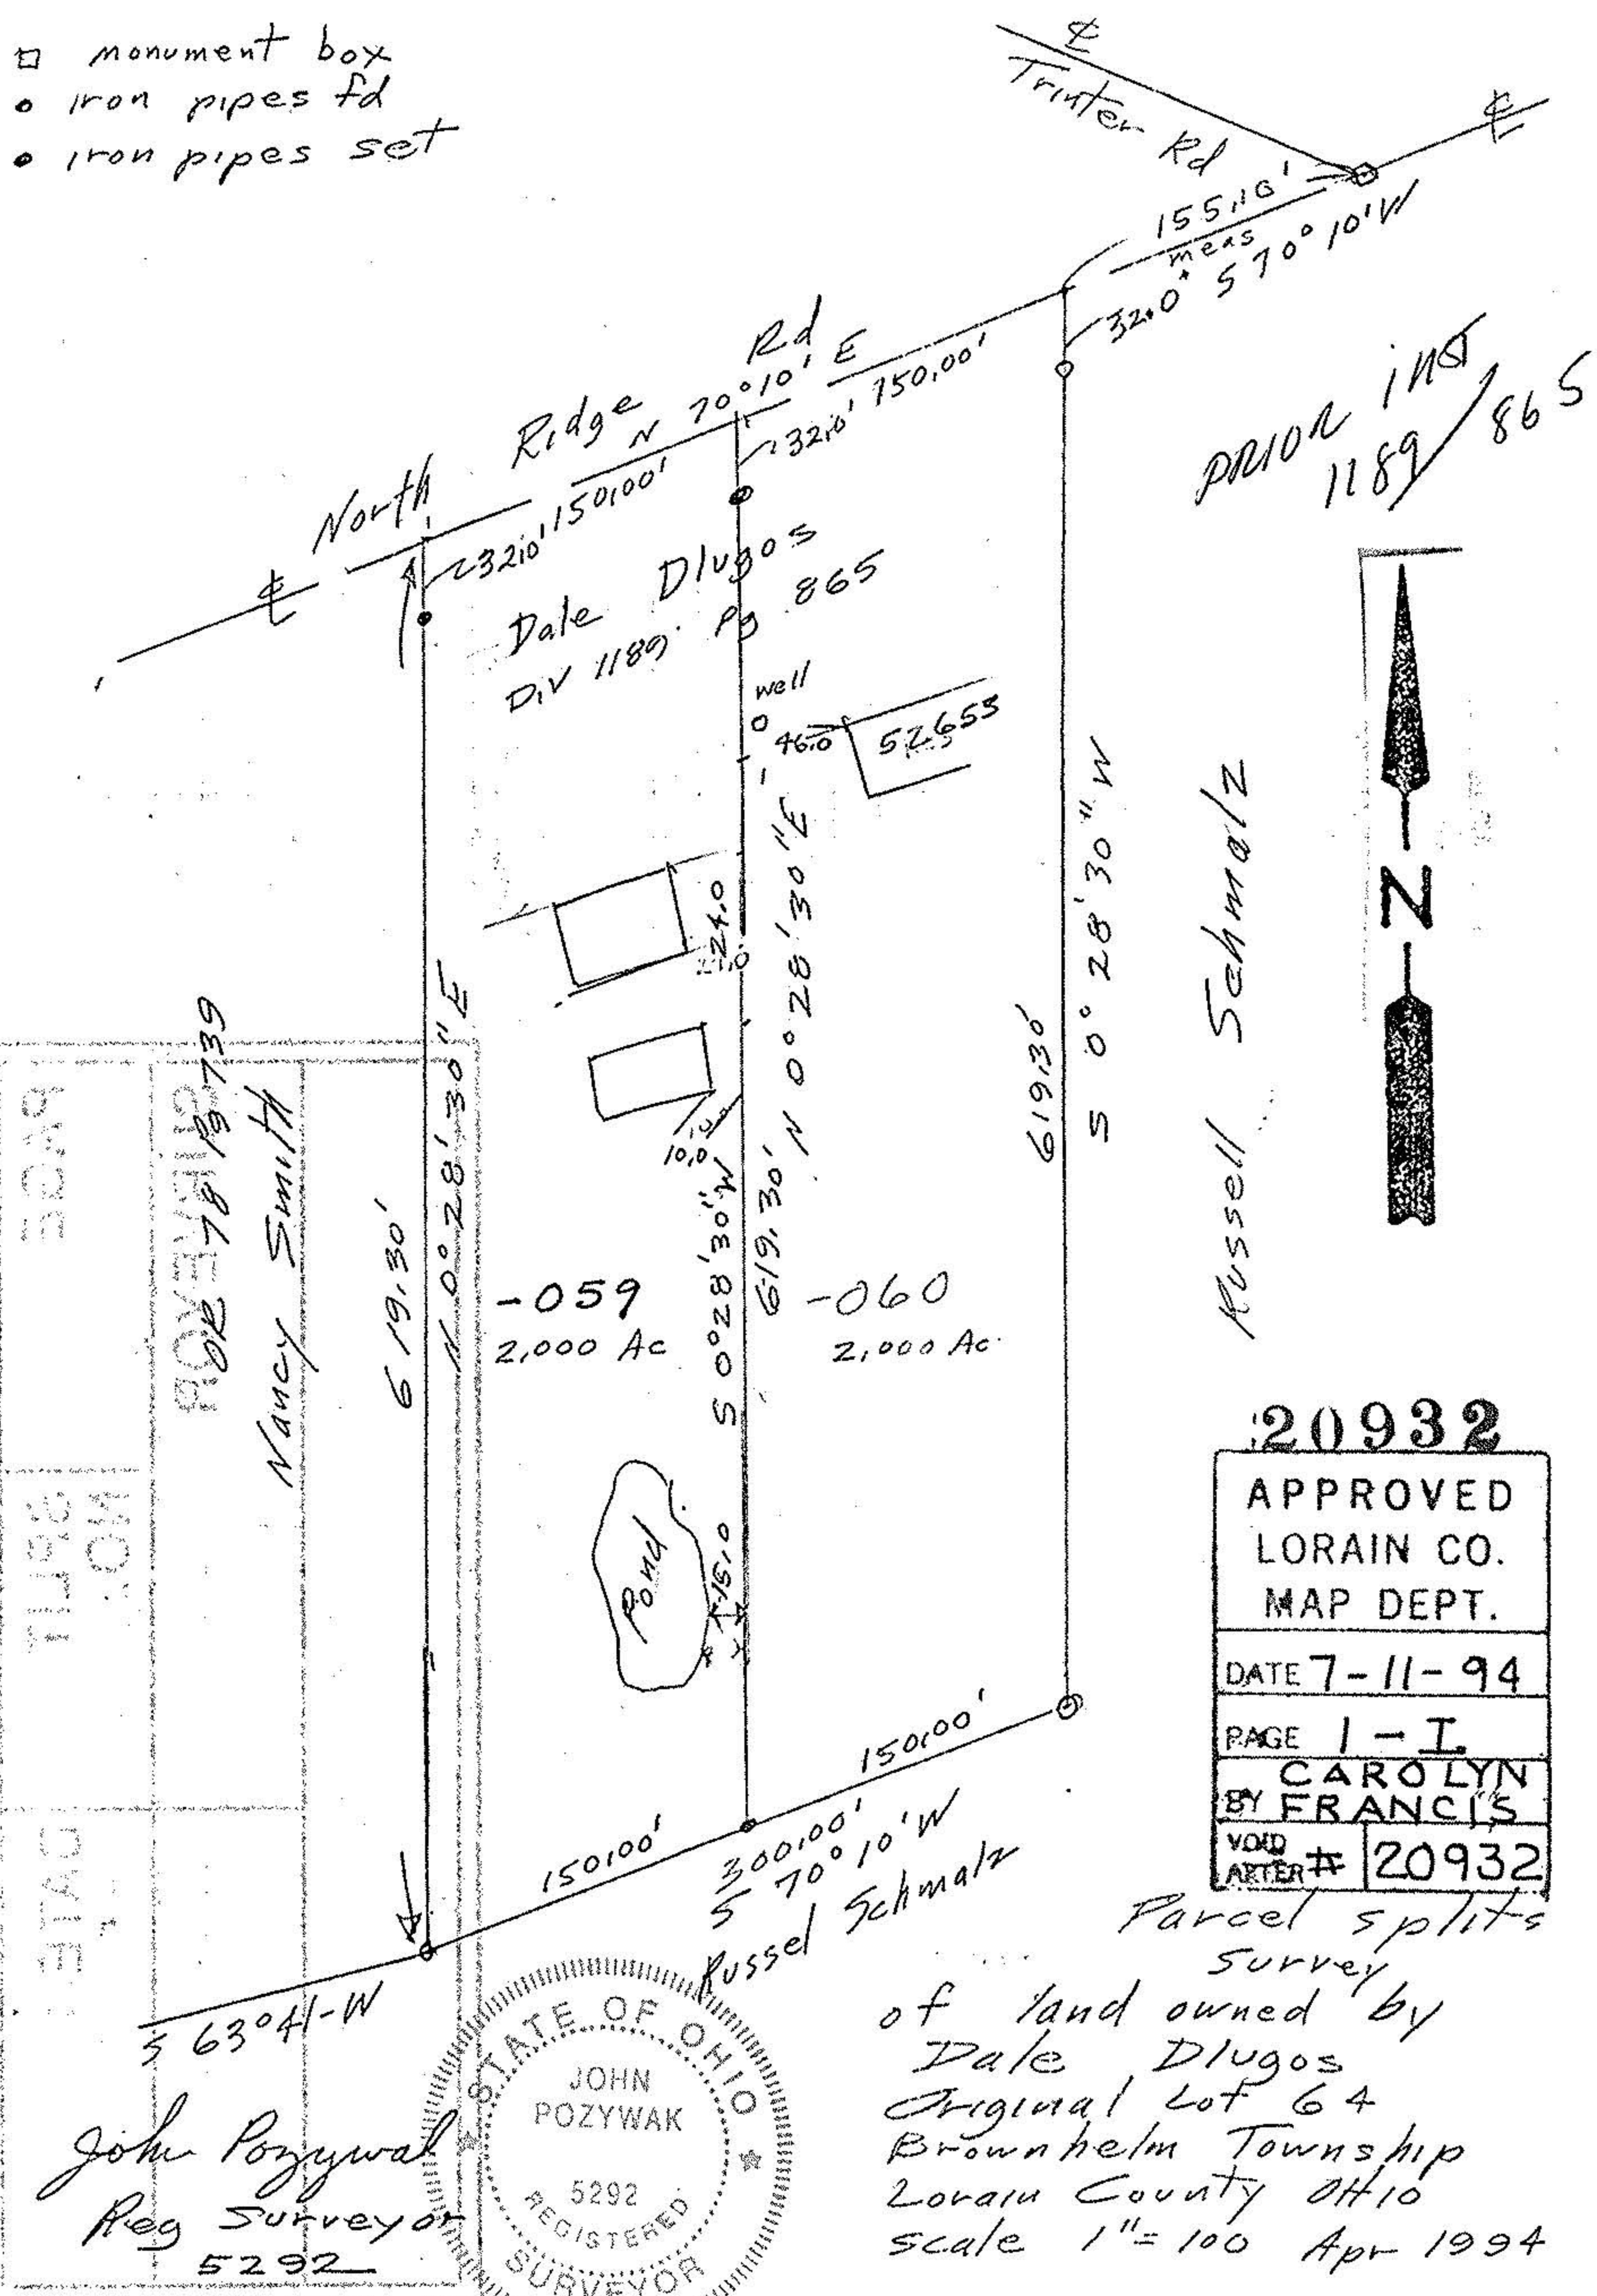

PRIOR INSTR 1189 865

Russell Schmalz


20932

APPROVED
LORAIN CO.
MAP DEPT.
DATE 7-11-94
PAGE 1-I
CAROLYN BY FRANCIS
VOID AFTER # 20932

Parcel splits survey

of land owned by  
 Dale Dlugos  
 Original Lot 64  
 Brownhelm Township  
 Lorain County Ohio  
 scale 1" = 100 Apr 1994

John Poznywak  
 Reg Surveyor  
 5292

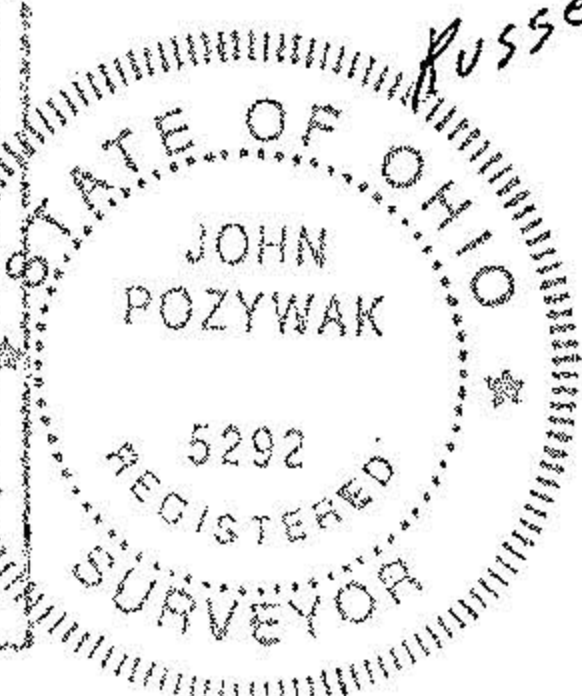

PROVE 78 19739  
 Nancy Smith

1198 3049  
 2611 3049  
 1310 3049