


4306

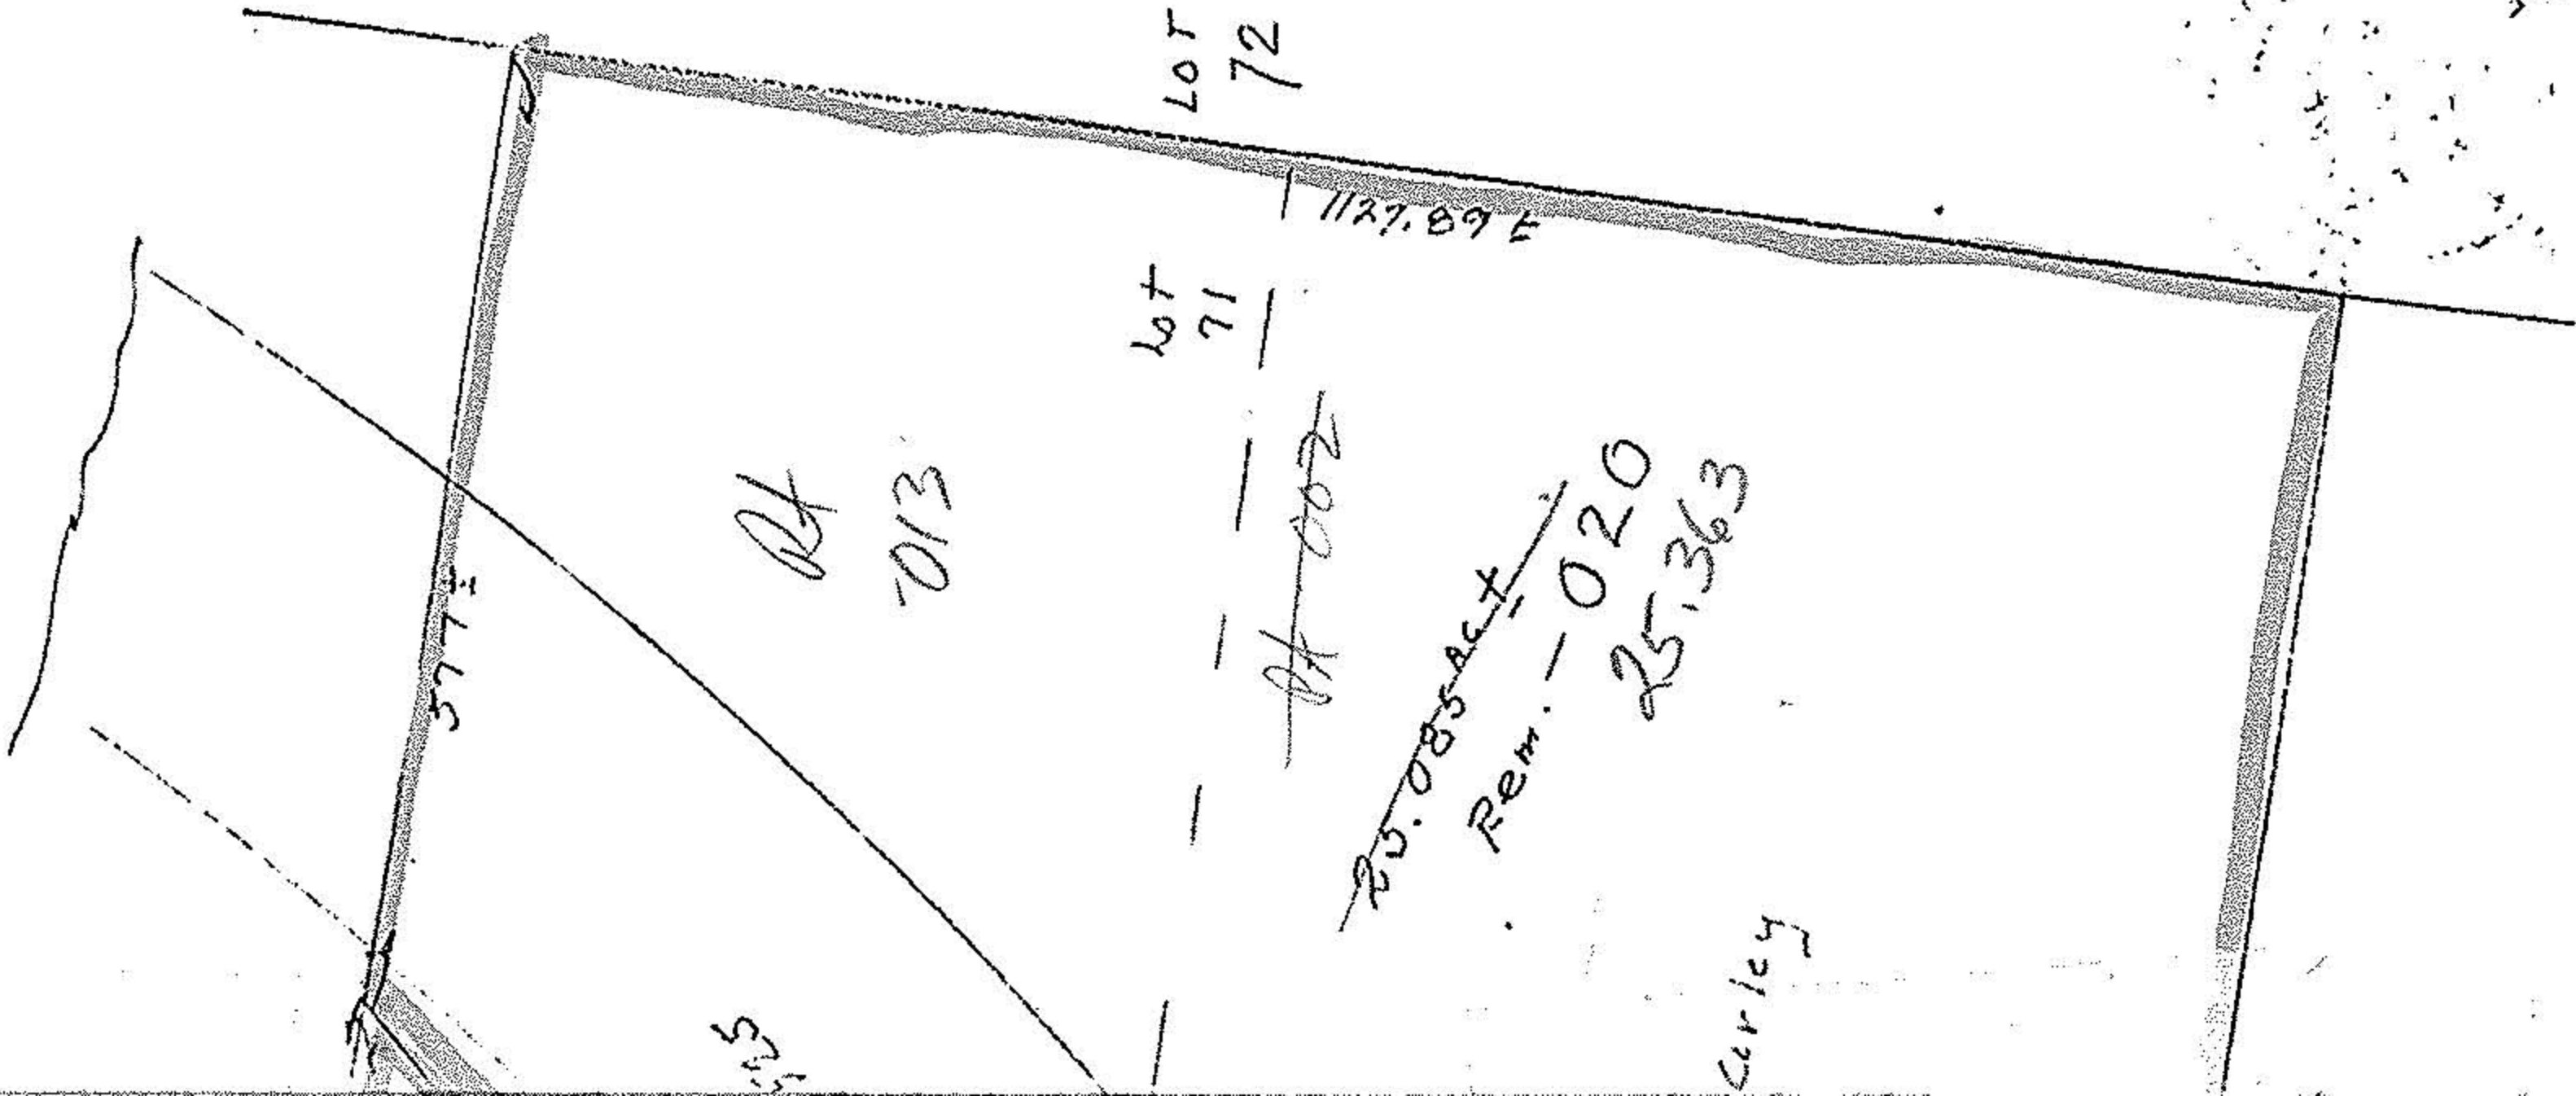

01-00-071-000-020

#17403

#17402

VOID → #17397

APPROVED
LORAIN CO.
MAP DEPT
DATE 4-29-87
PAGE 1-4
BY C. FRANCIS
VOID AFTER