

MAP OF PART OF D.L. 77 BROWN HELL TWP
 LORAIN CO. OHIO
 BY ARNOLD KOEPP REG. SURVEYOR NO 4306


Map revised Dec -10-1976

1-J

01-00-072-000-042,032

#31547

Please Return

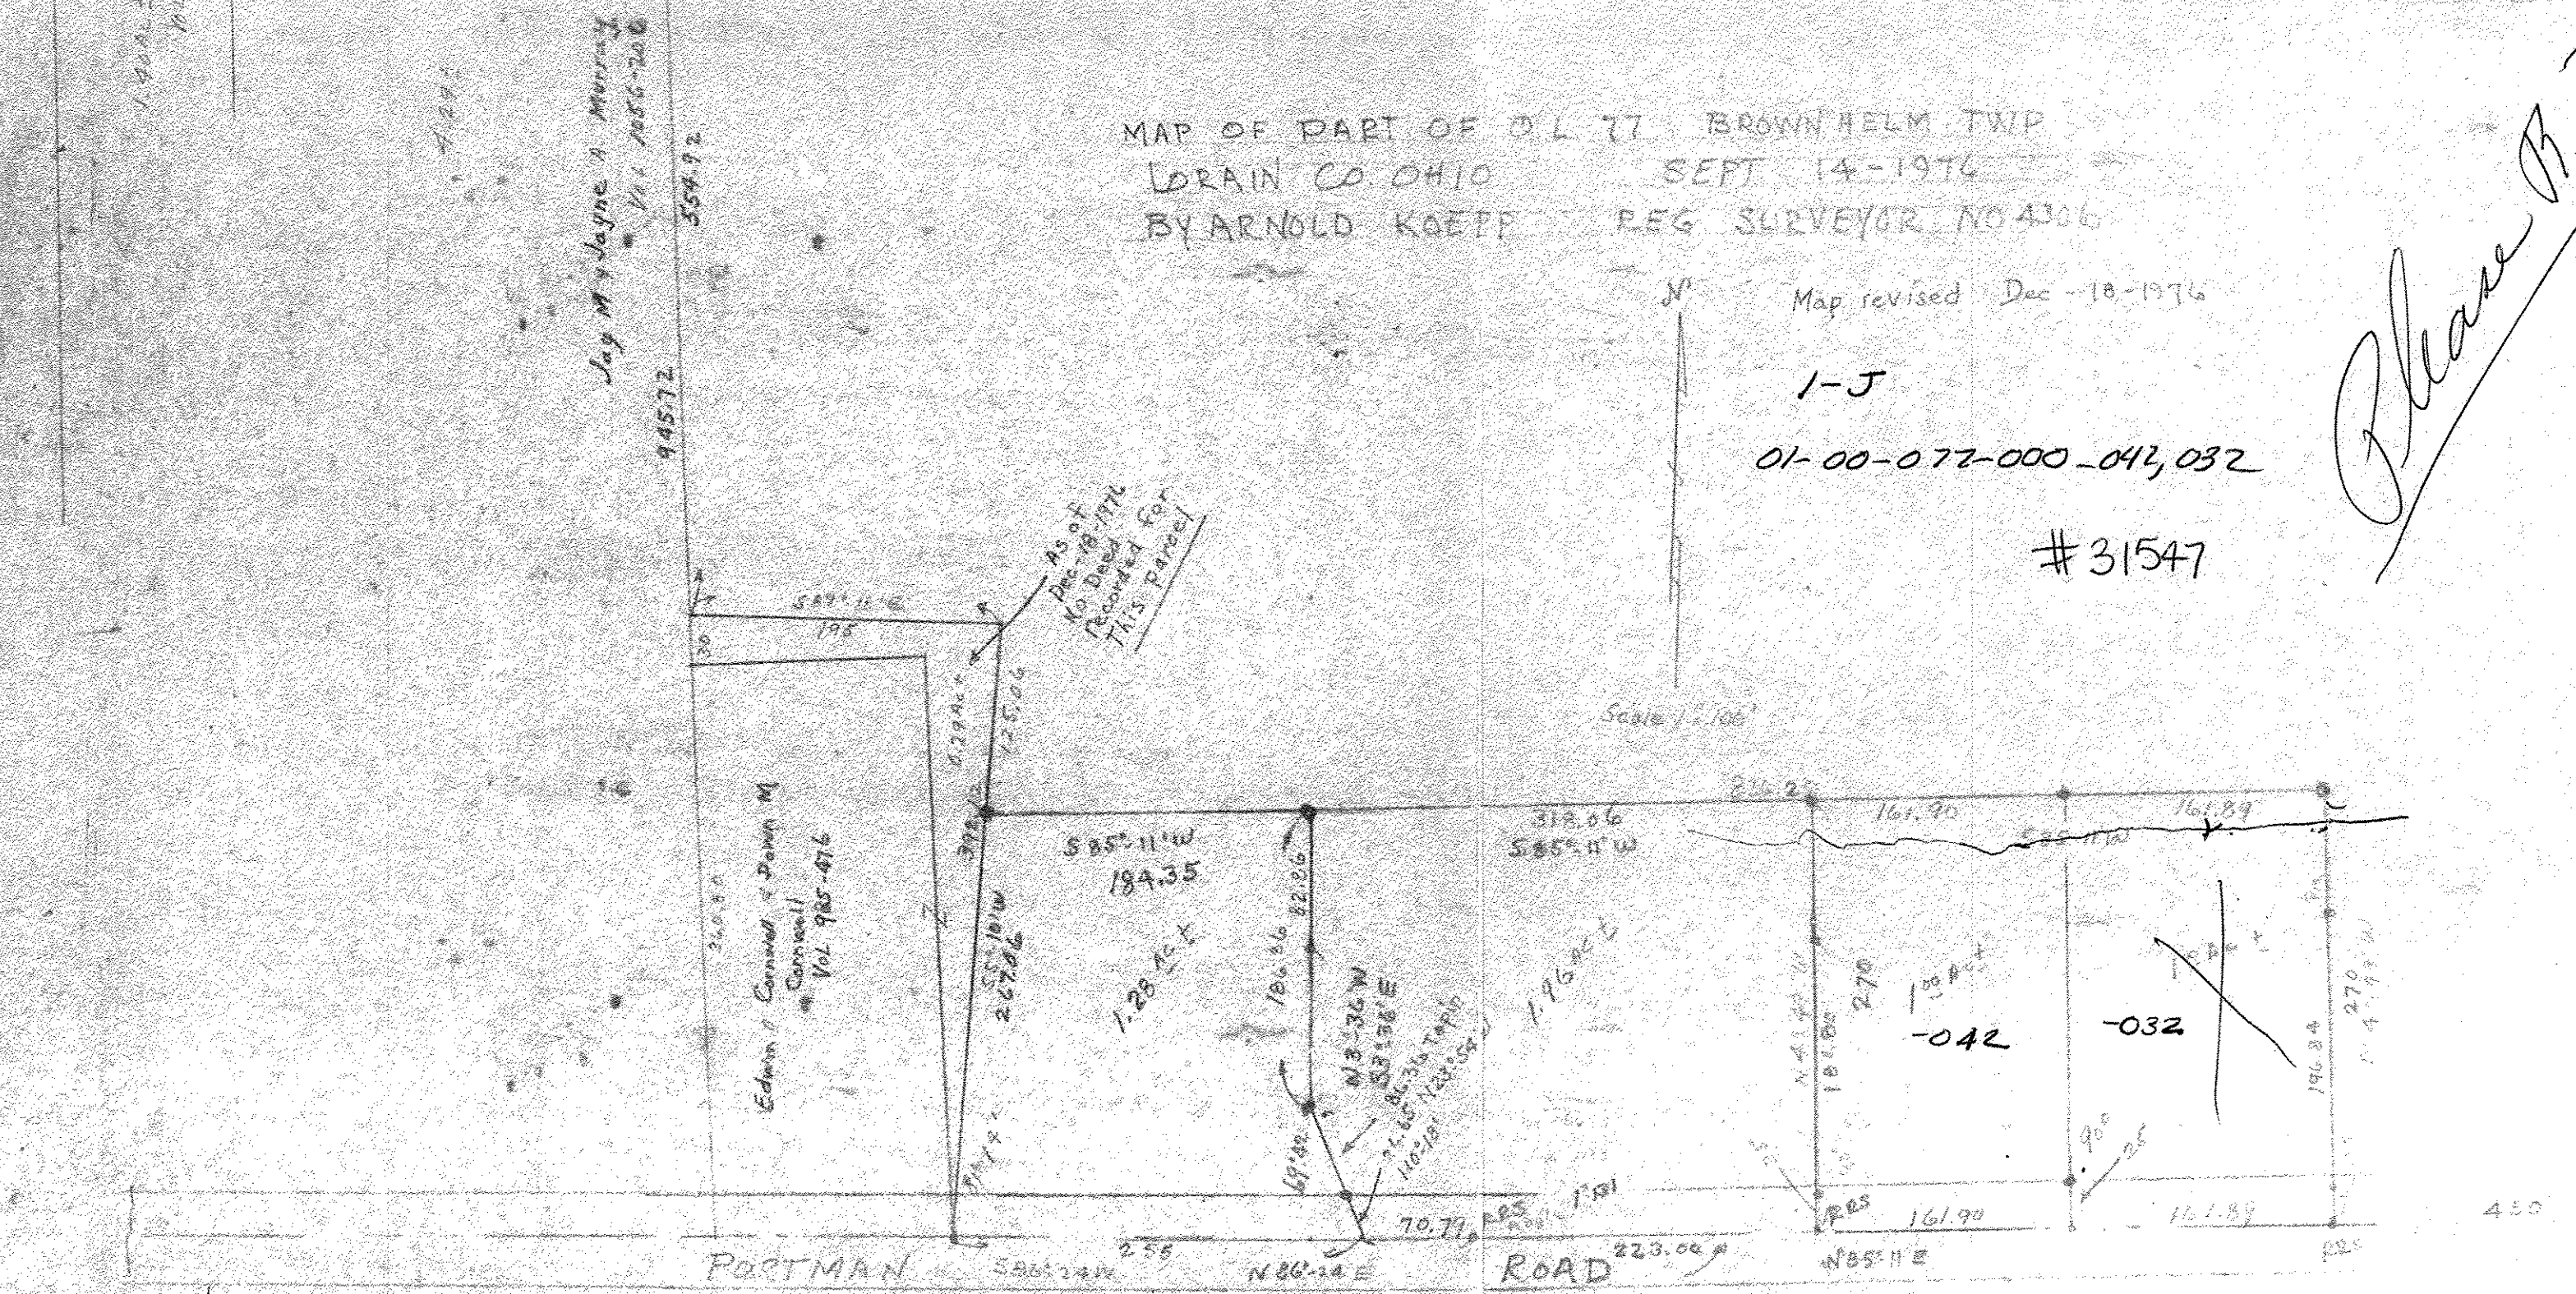

660-00-1

660-00-1