


* 16712

- 053

Map of Part of O.L. 77 Brownhelm Twp. Lorain Co. Ohio
Scale 1" = 400' June 5, 1985
By Arnold F. Koepf Reg. Surveyor No. 4306

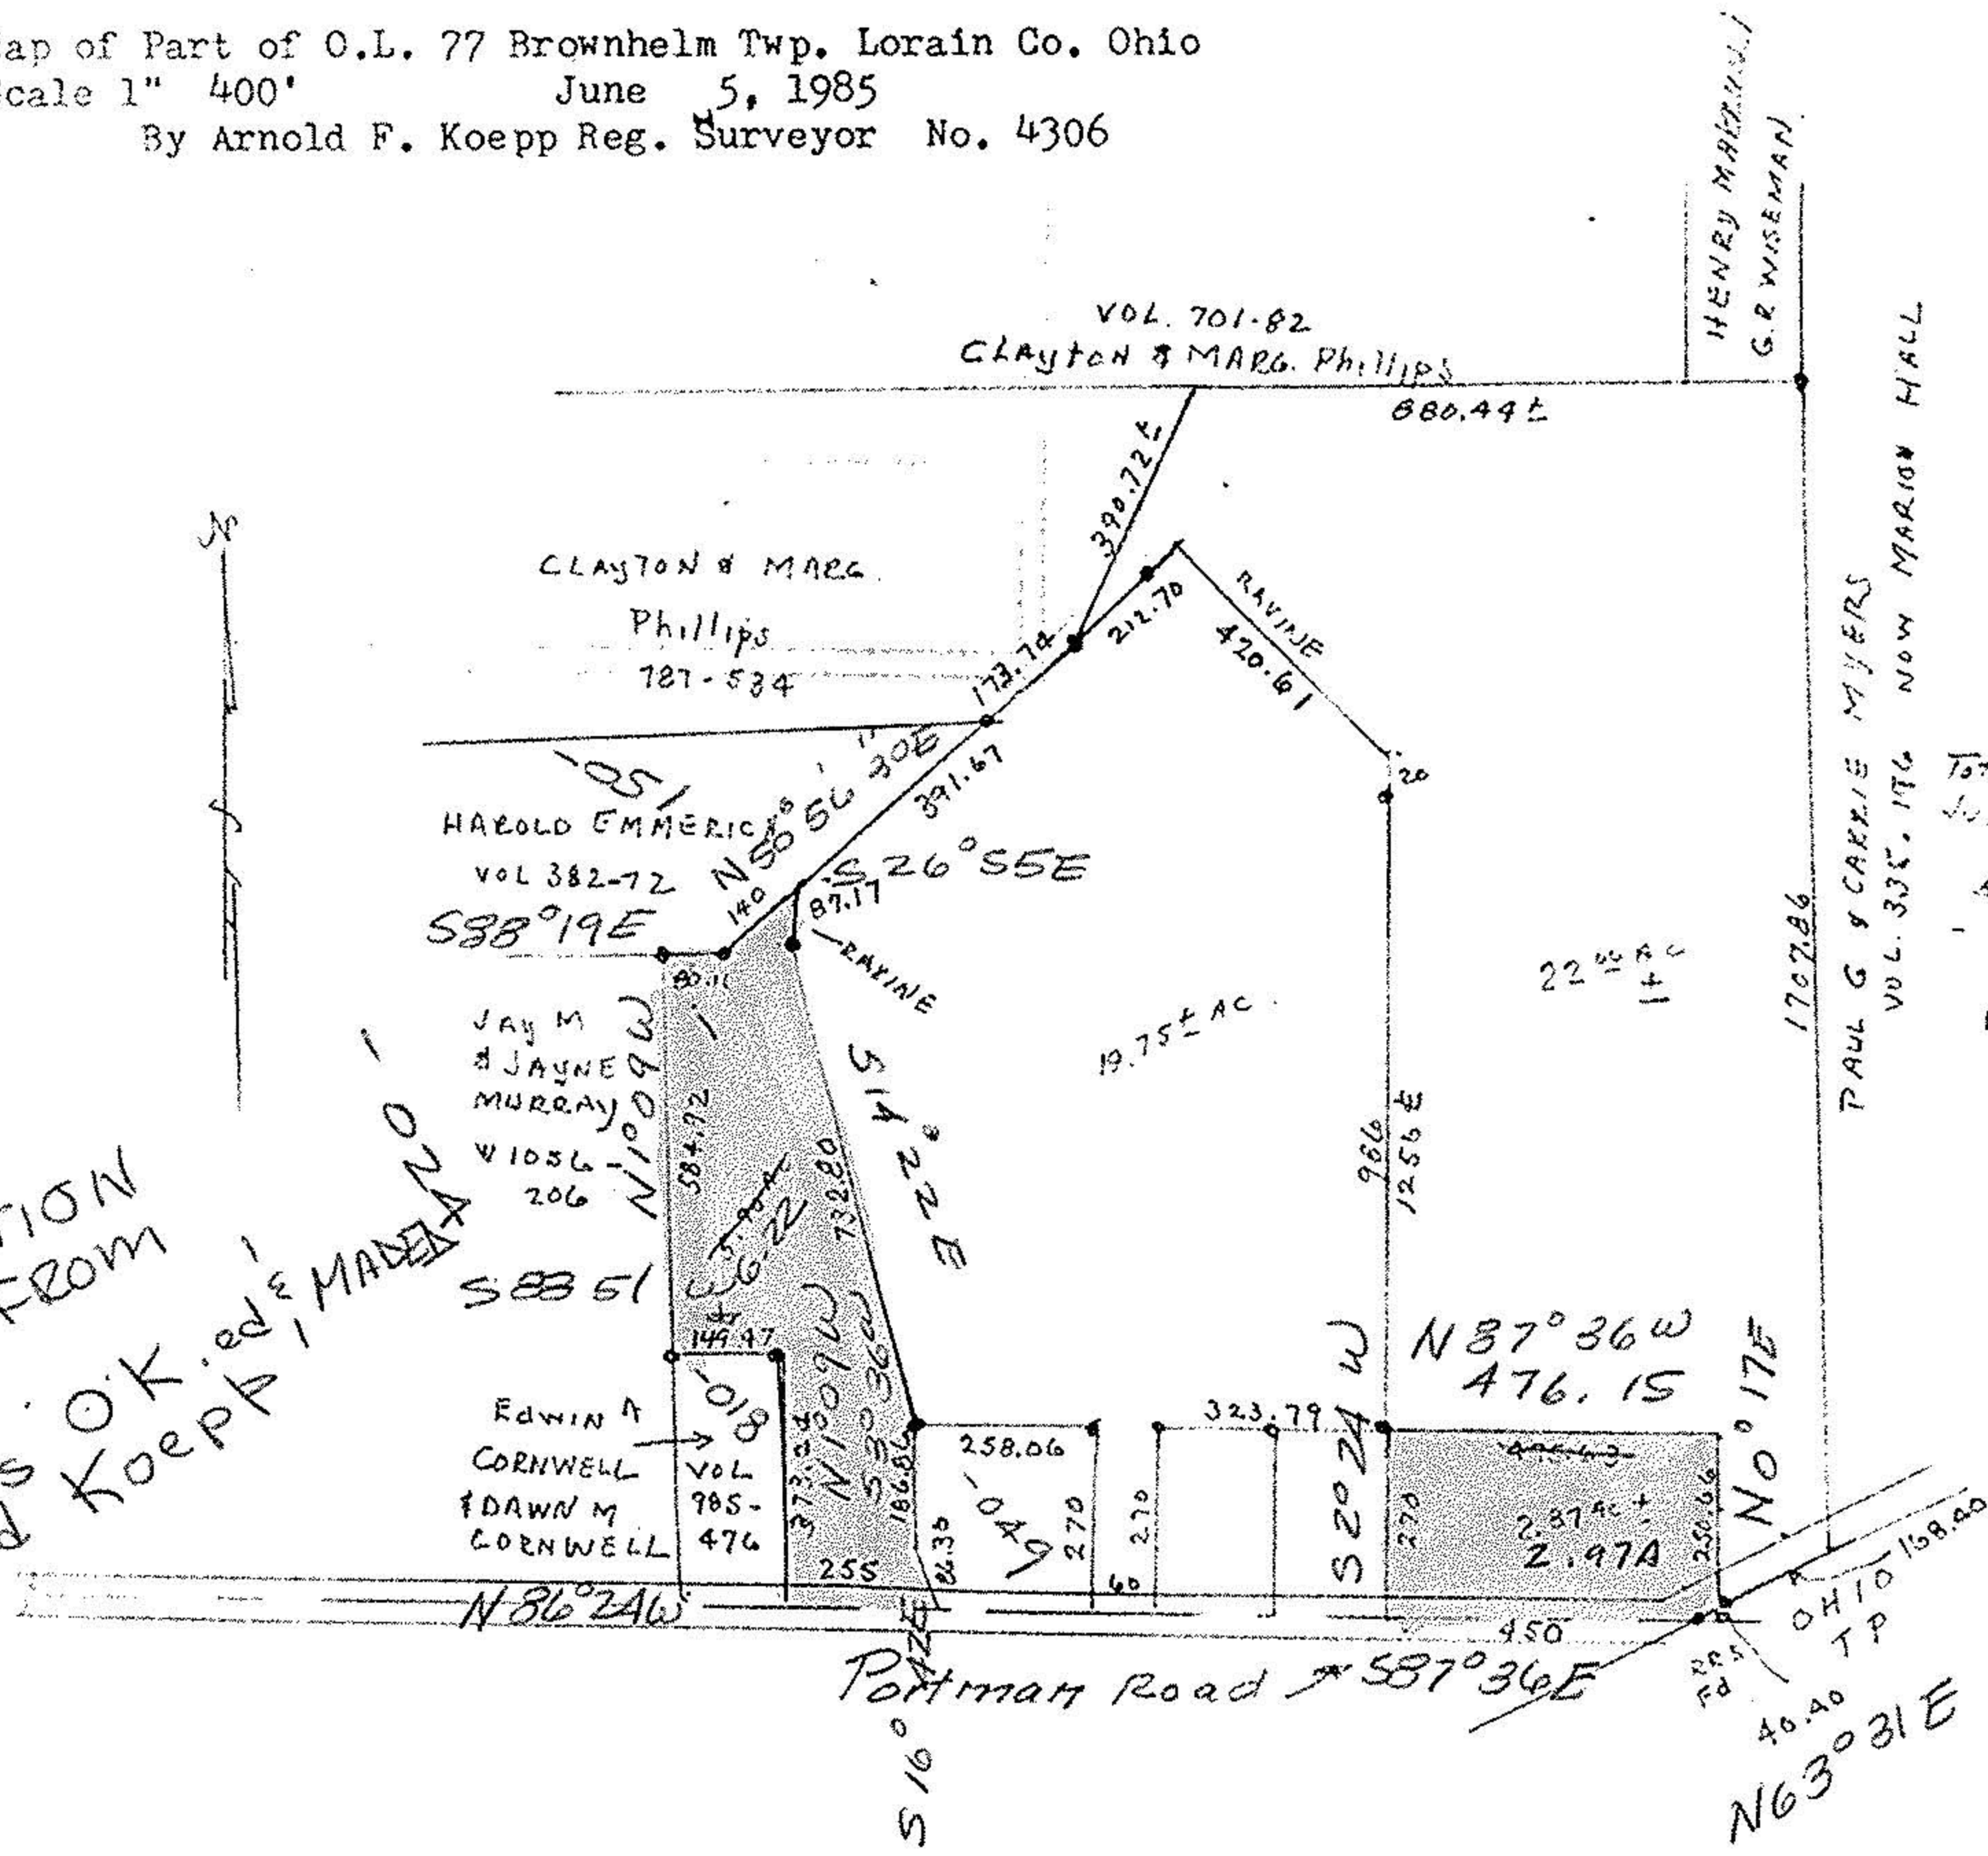

Total Acreage June 1985

50.52
2.87
19.75
1.00
2.97
6.22

INFORMATION TAKEN FROM DEEDS. O.K. ed. MADE AND CORRECTIONS BY ARNOLD KOEPF

16712

APPROVED LORAIN CO. MAP DEPT.
DATE 5-1-86
PAGE I-3
BY C. FRANCIS
VOID AFTER