


1-J


~~180~~ 17858

765 1191

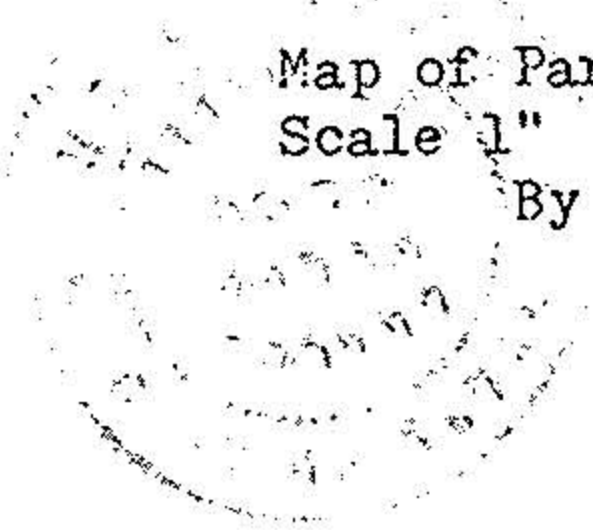

Map of Part of O.L. 77 Brownhelm Twp. Lorain Co. Ohio
Scale 1" = 400'
June 5, 1985
By Arnold F. Koepp Reg. Surveyor No. 4306

01-00-

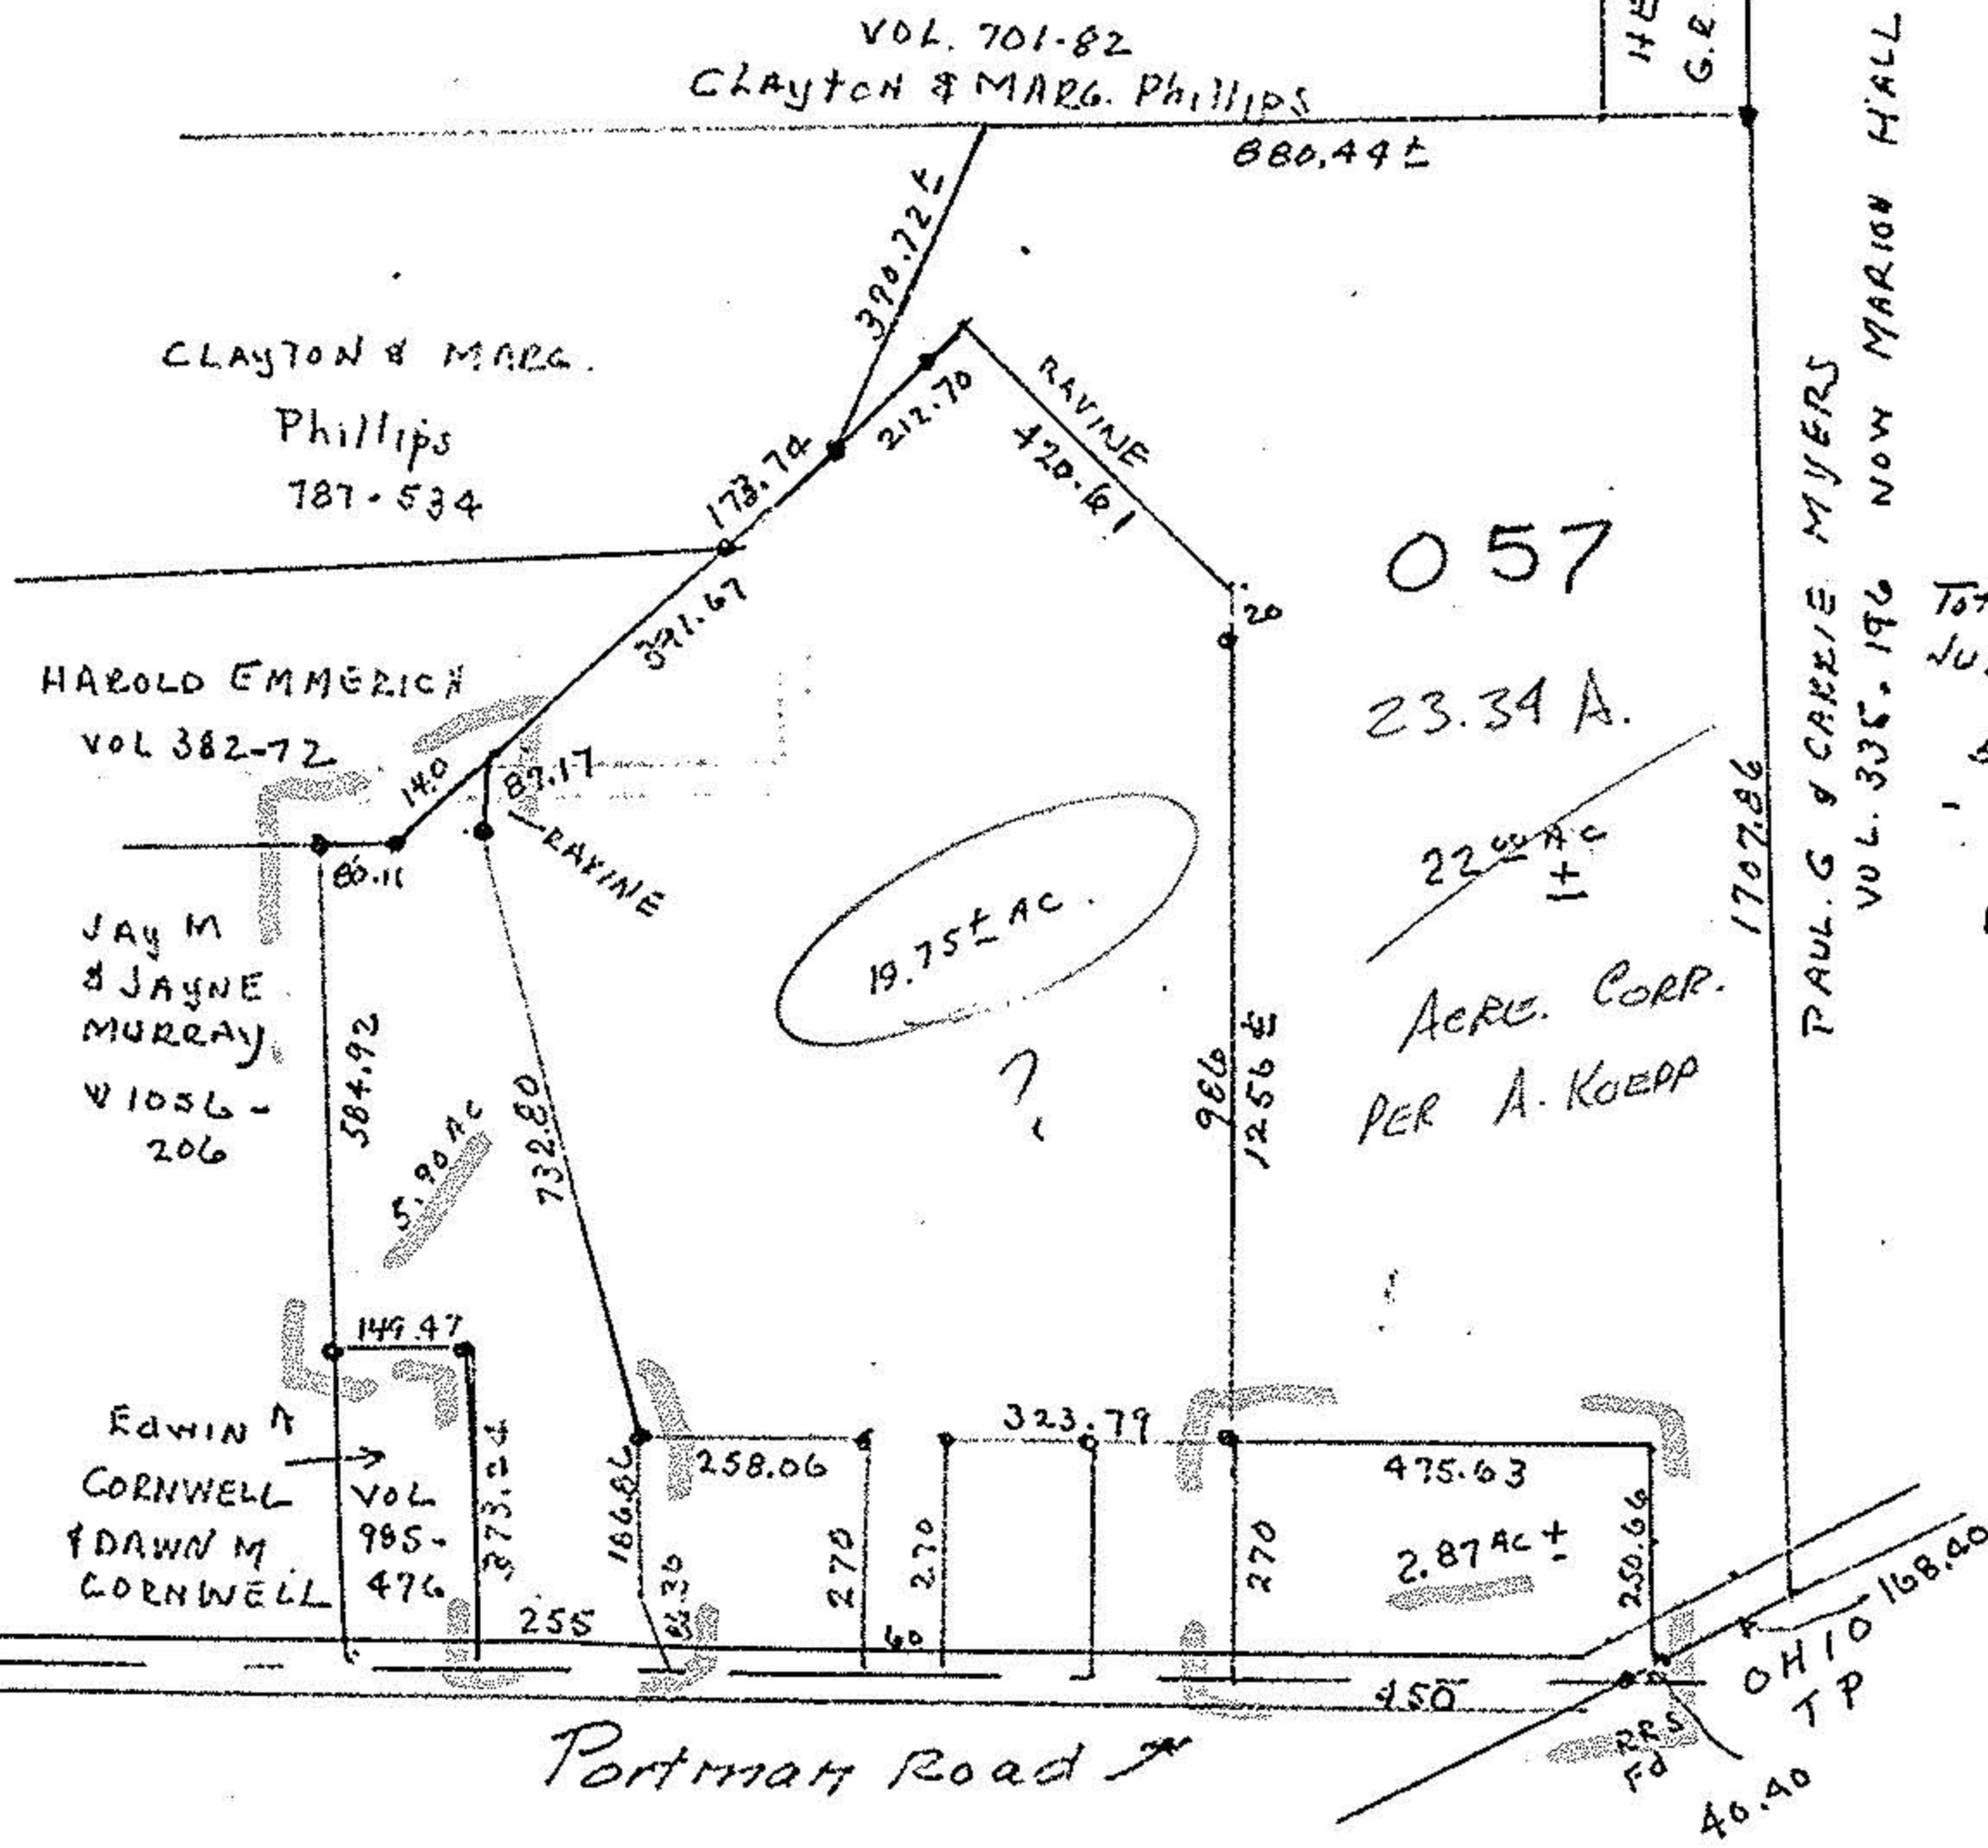

057
23.34 A.
22.00 AC ±
Acres. Corp.
PER A. KOEPP

Total Acreage
June 1985
50.52
2.87
19.75
5.90

#17858

APPROVED
LORAIN CO.
MAP DEPT.
DATE 7-5-88
PAGE 1-J
BY T. McMain
VOID AFTER 17858

01-00 - 077 - 000 - 057