


Map of Part of Lot 26 Gore Strip Brownhelm Twp. Lorain Co. Ohio  
 Scale 1" 200' March 31, 1979

By Arnold F. Koepp Reg. Surveyor No 4306

*Arnold F. Koepp*  
 revised Aug. 3, 1979 easement  
 Schmalz property

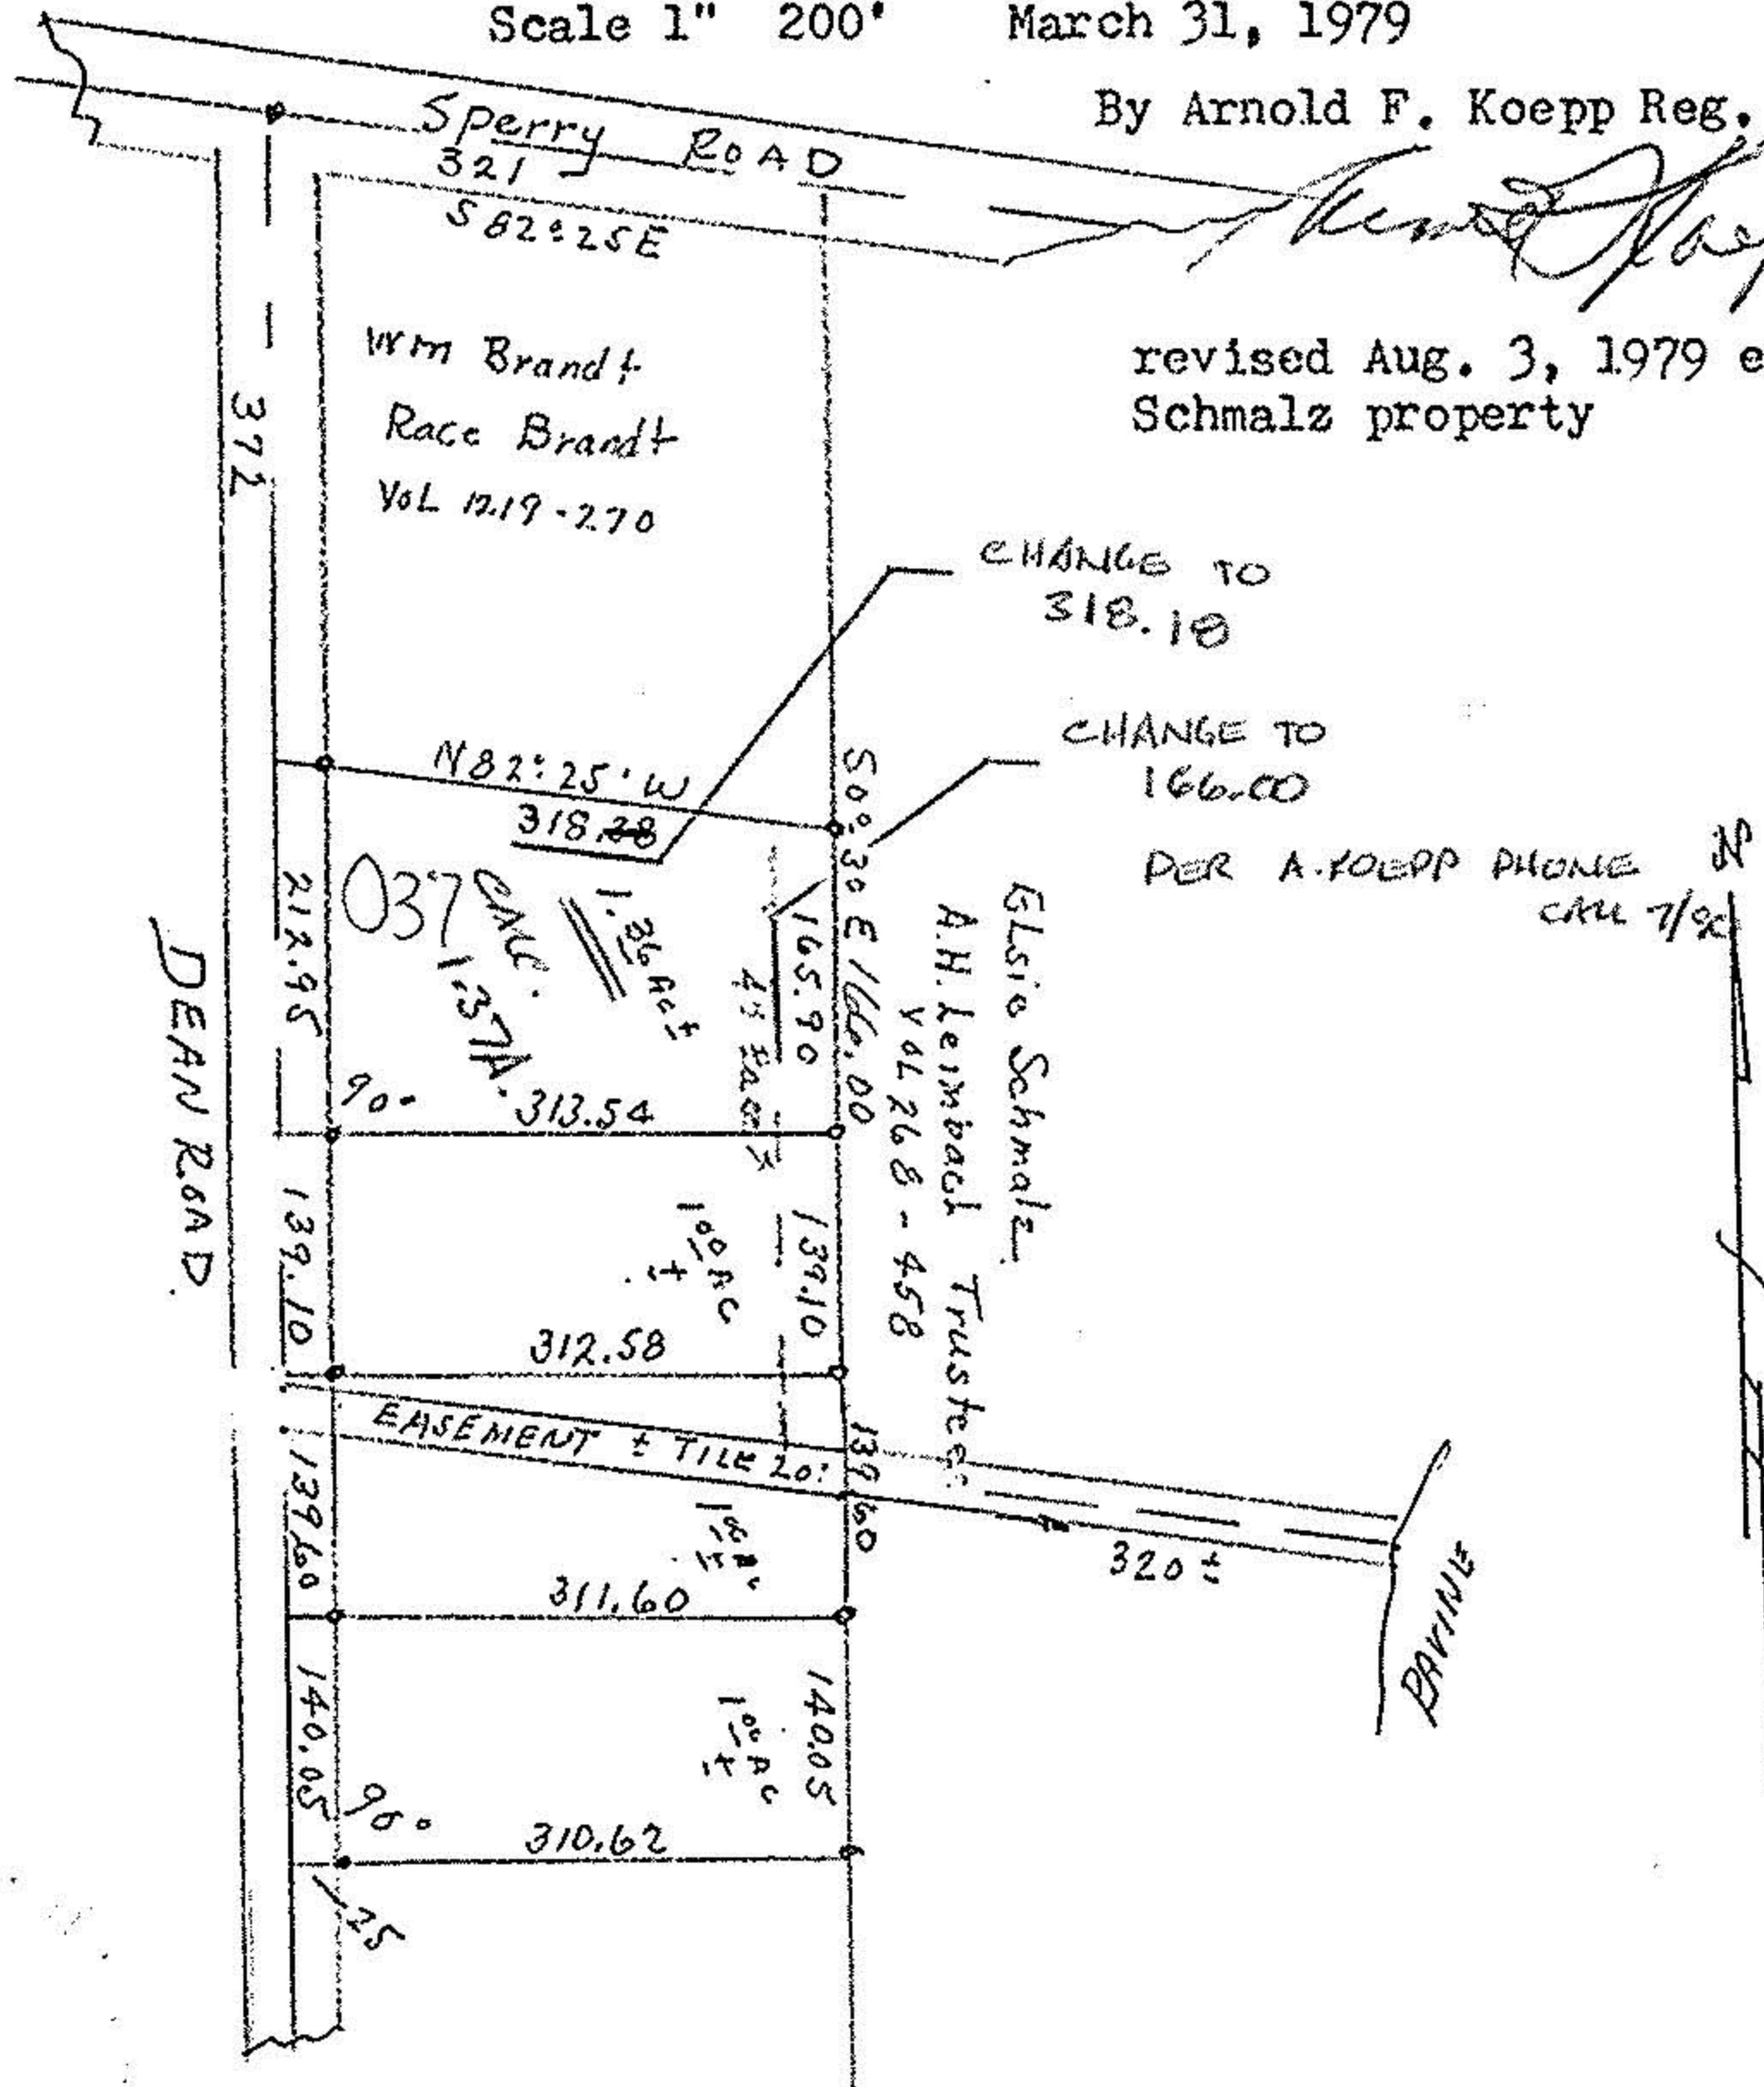

● Indicated iron pins set

# 19060

APPROVED LORAIN CO. MAP DEPT.	
DATE 7-30-90	
PAGE 1-I	
BY CAROLYN FRANCIS	
VOID AFTER #	19060

REDONE  
 7-31-90  
 1-I  
 T. McMain