

# 10000

Map of Part of Surplus Lot 26 Brownhels Exp. Lorain Co. Ohio  
Scale 1" 100' Aug. 8, 1978  
By Arnold F. Koepf, Registered Surveyor No. 4206


01-20-026-000-013

Goes with Map to be  
Drawn - 12-13-78




# 12329

APPROVED  
LORAIN CO.  
MAP 2001.  
DEC 12-13-78  
1-I  
Carolynd  
12329

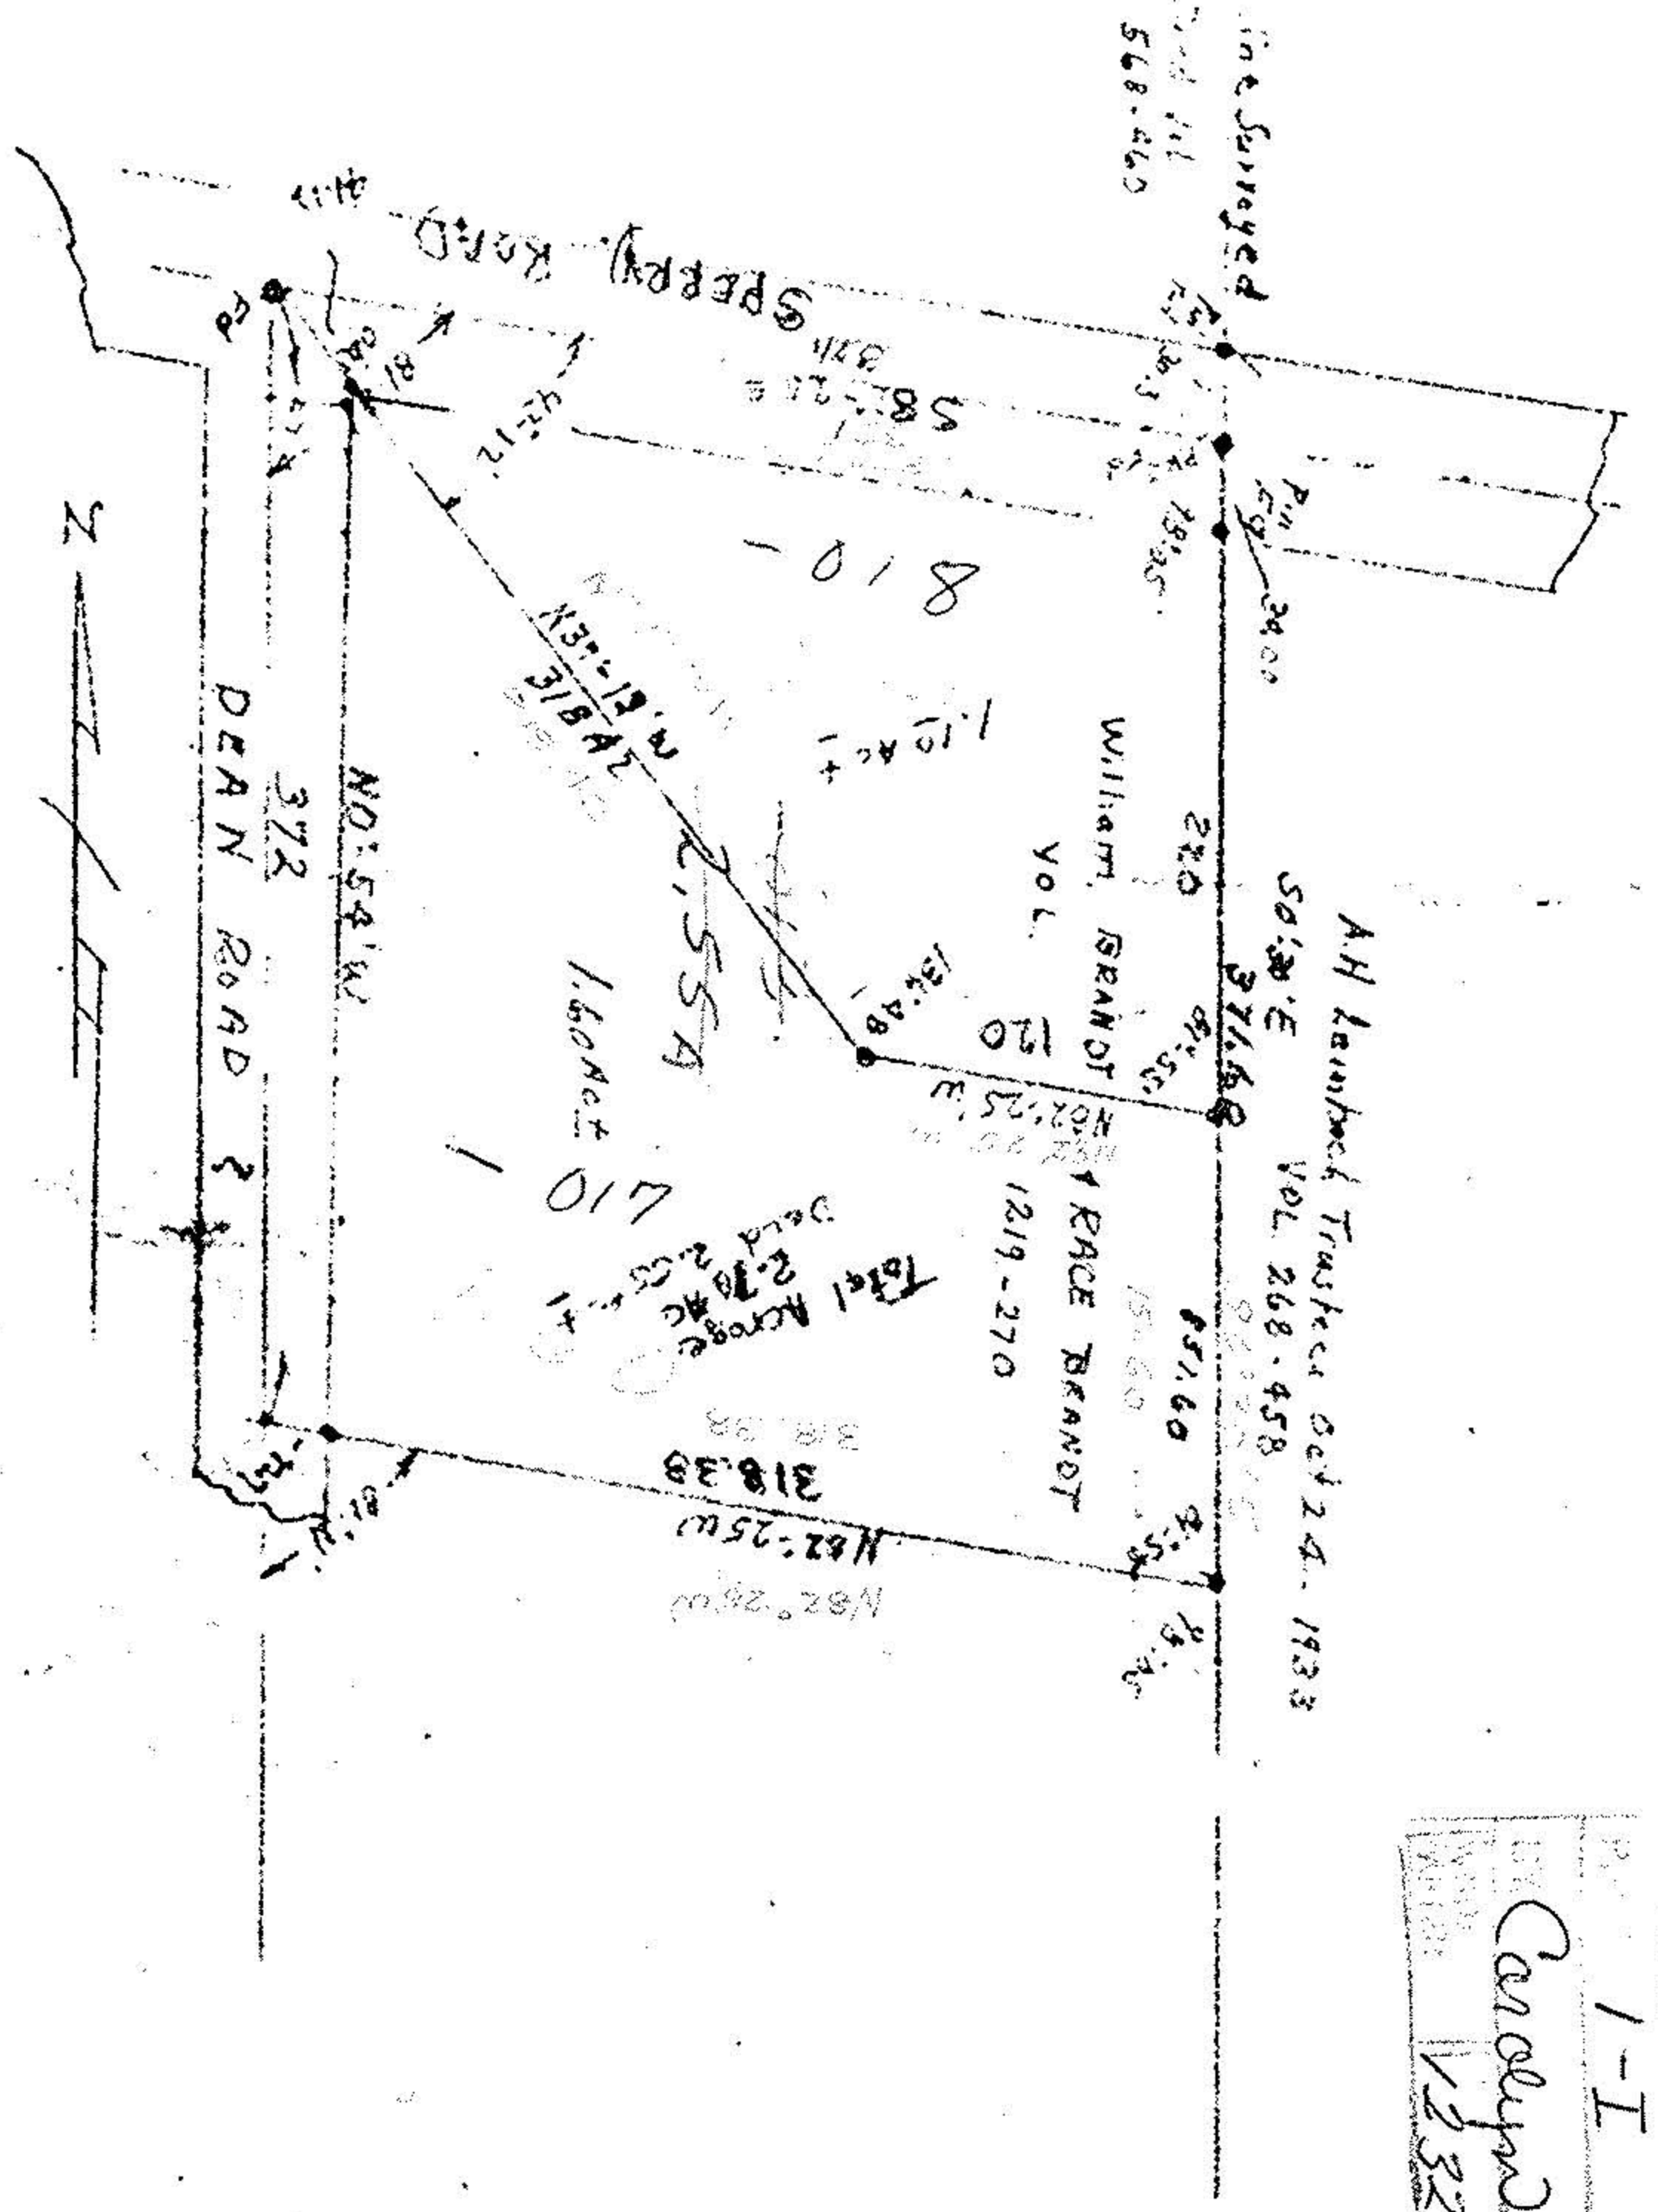


1/LOT 26  
01-20-026-000-017  
-018

Part of Part of Surplus Lot 26 Brownhels Exp. Lorain Co. Ohio  
Scale 1" 100' Aug. 8, 1978  
By Arnold F. Koepf, Registered Surveyor No. 4206

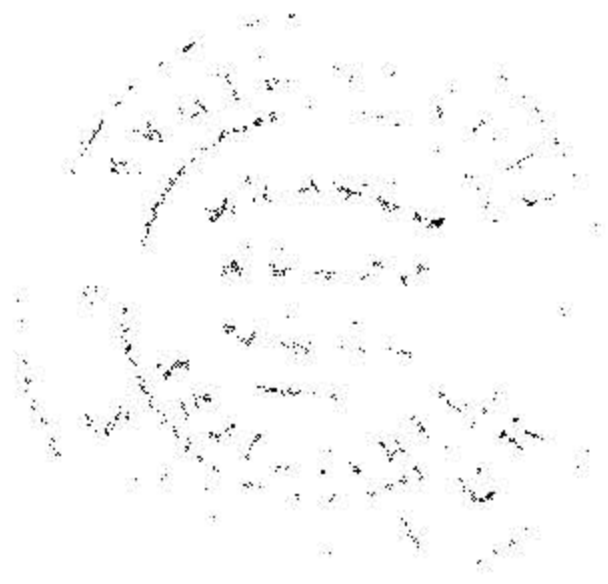

1-I

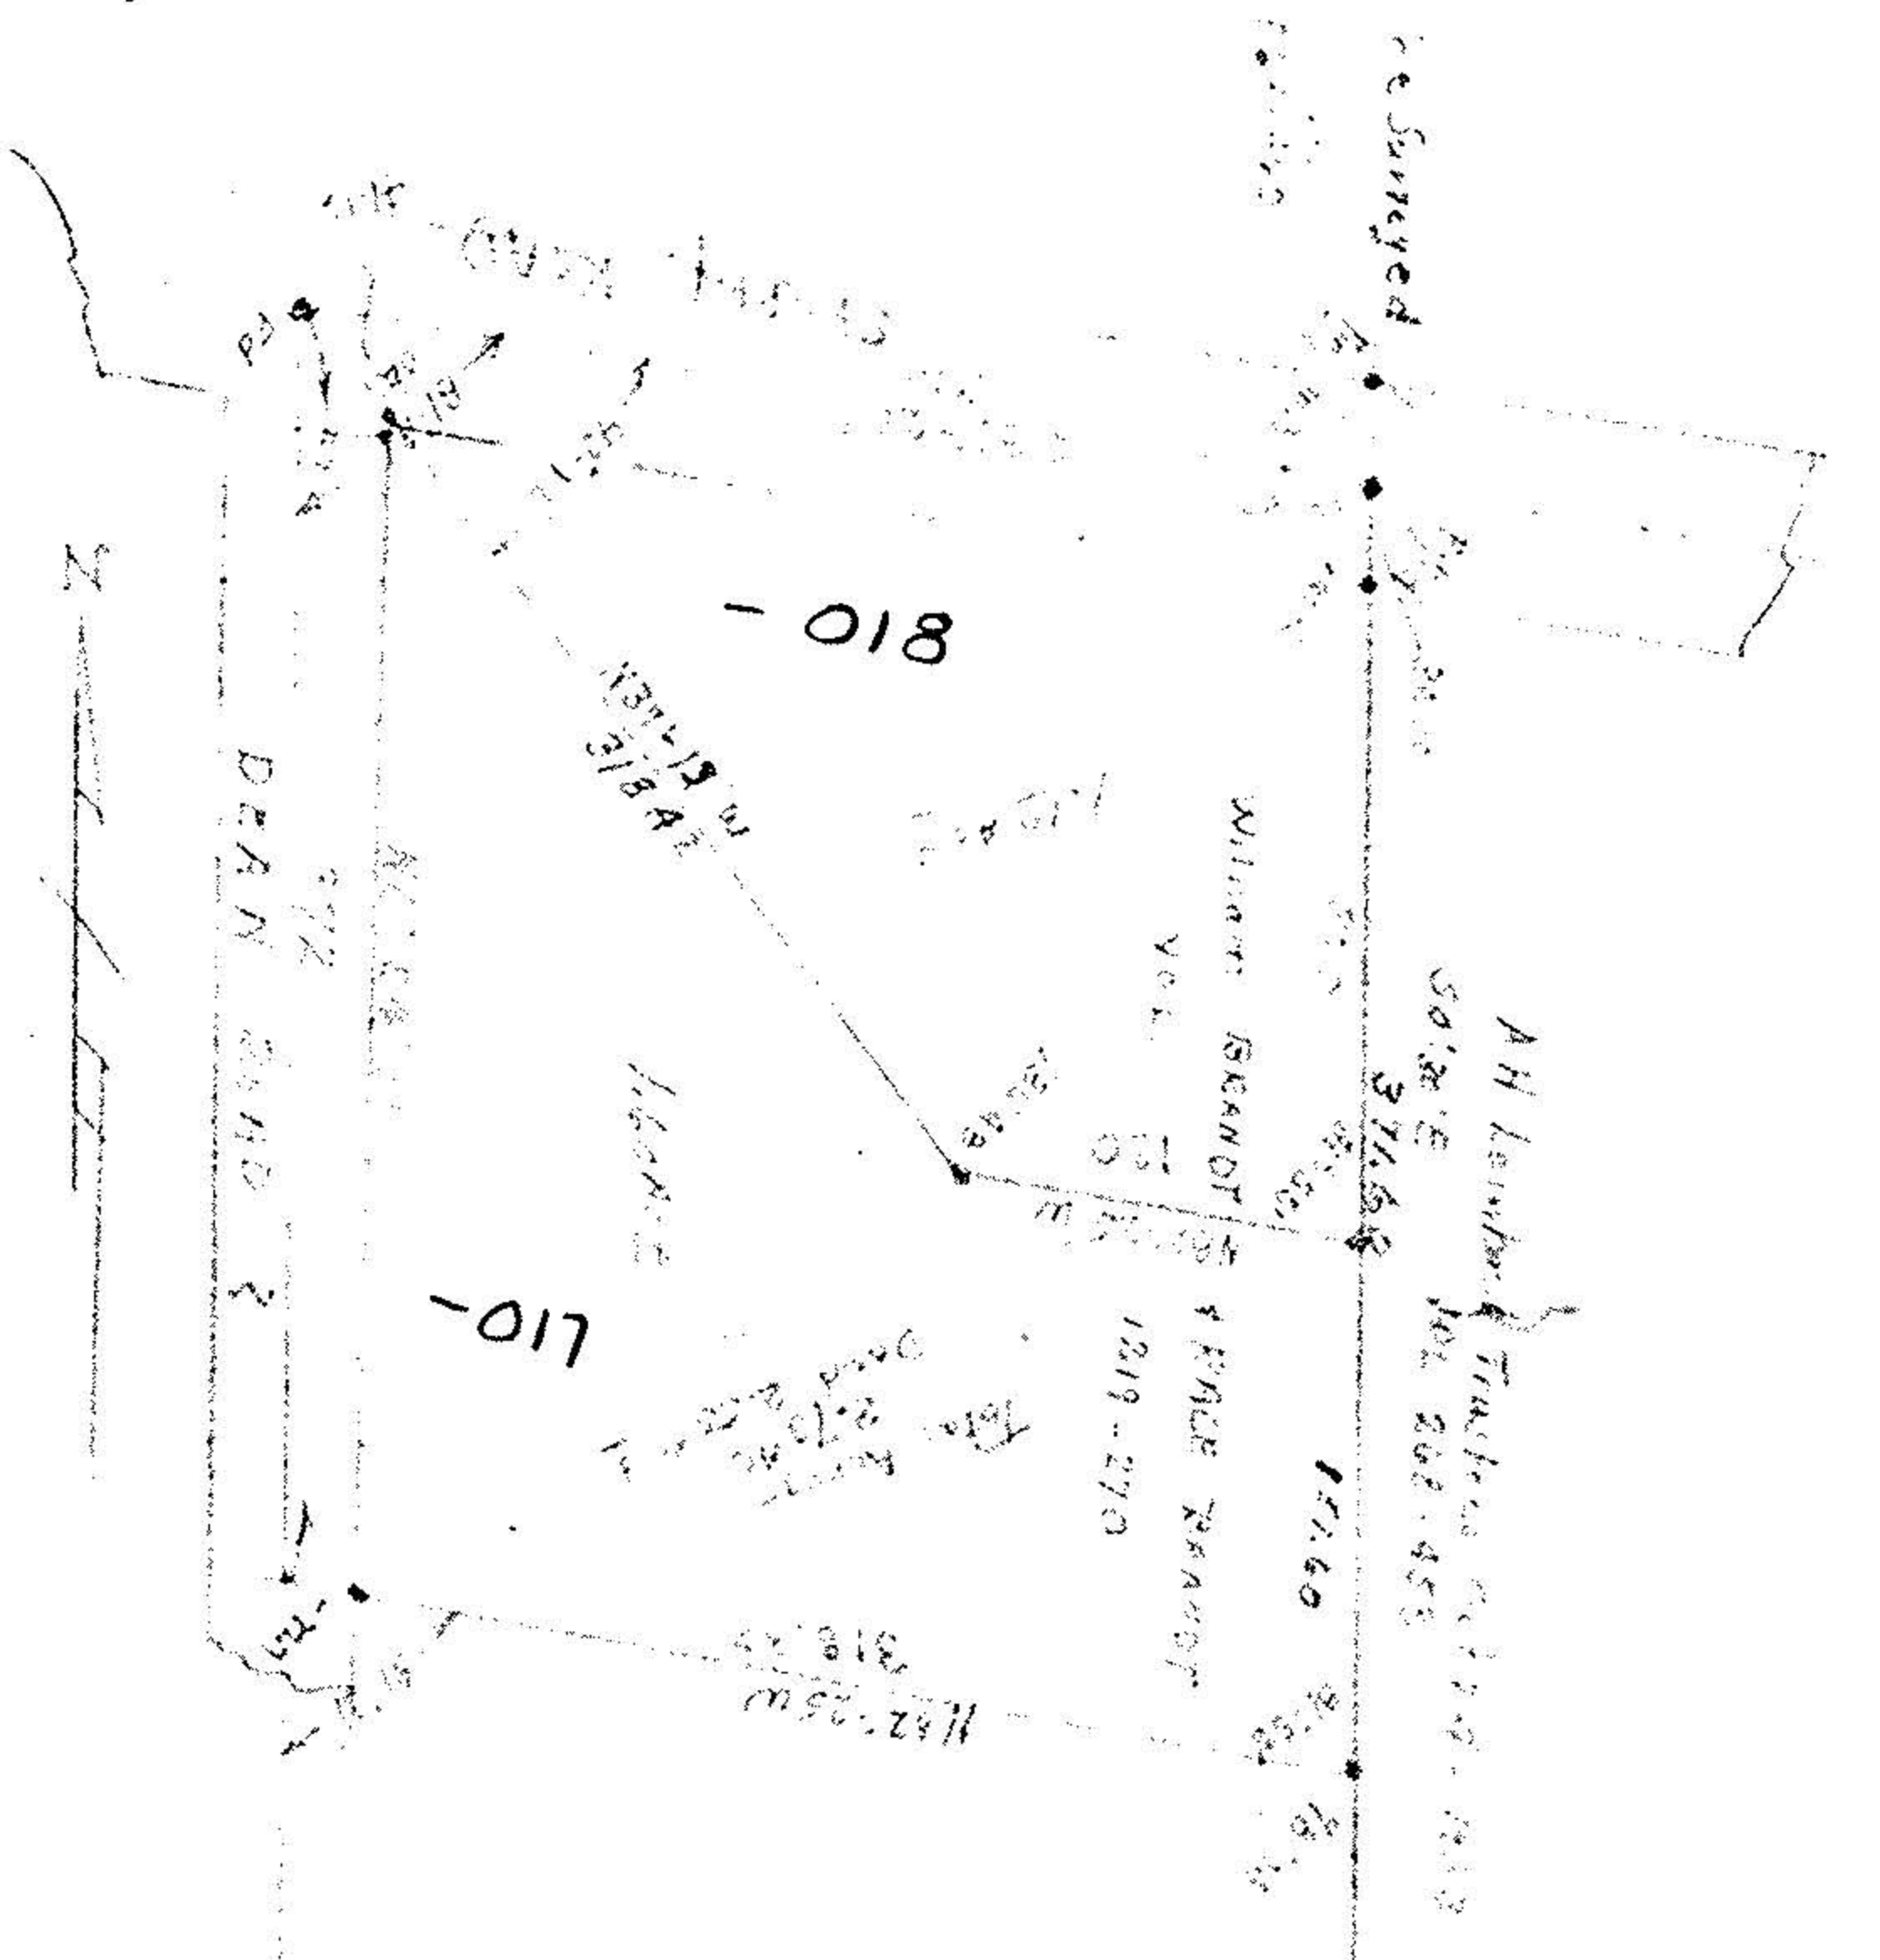

12329  
01-20-026-78  
1-I  
Carolynd