


MAP OF SURVEY OF 1.05 AC. DEED
 FOR BUD GARFIELD
 BLACK RIVER TWP. - TRACT 1 S.E. 83
 CITY OF LORAIN
 JOHN R. HAMILTON - REG. SURV. #6861
 MAY 1988 SCALE 1"=100'

NORTH
 SCALE 1"=100'

OBERLIN AVE.

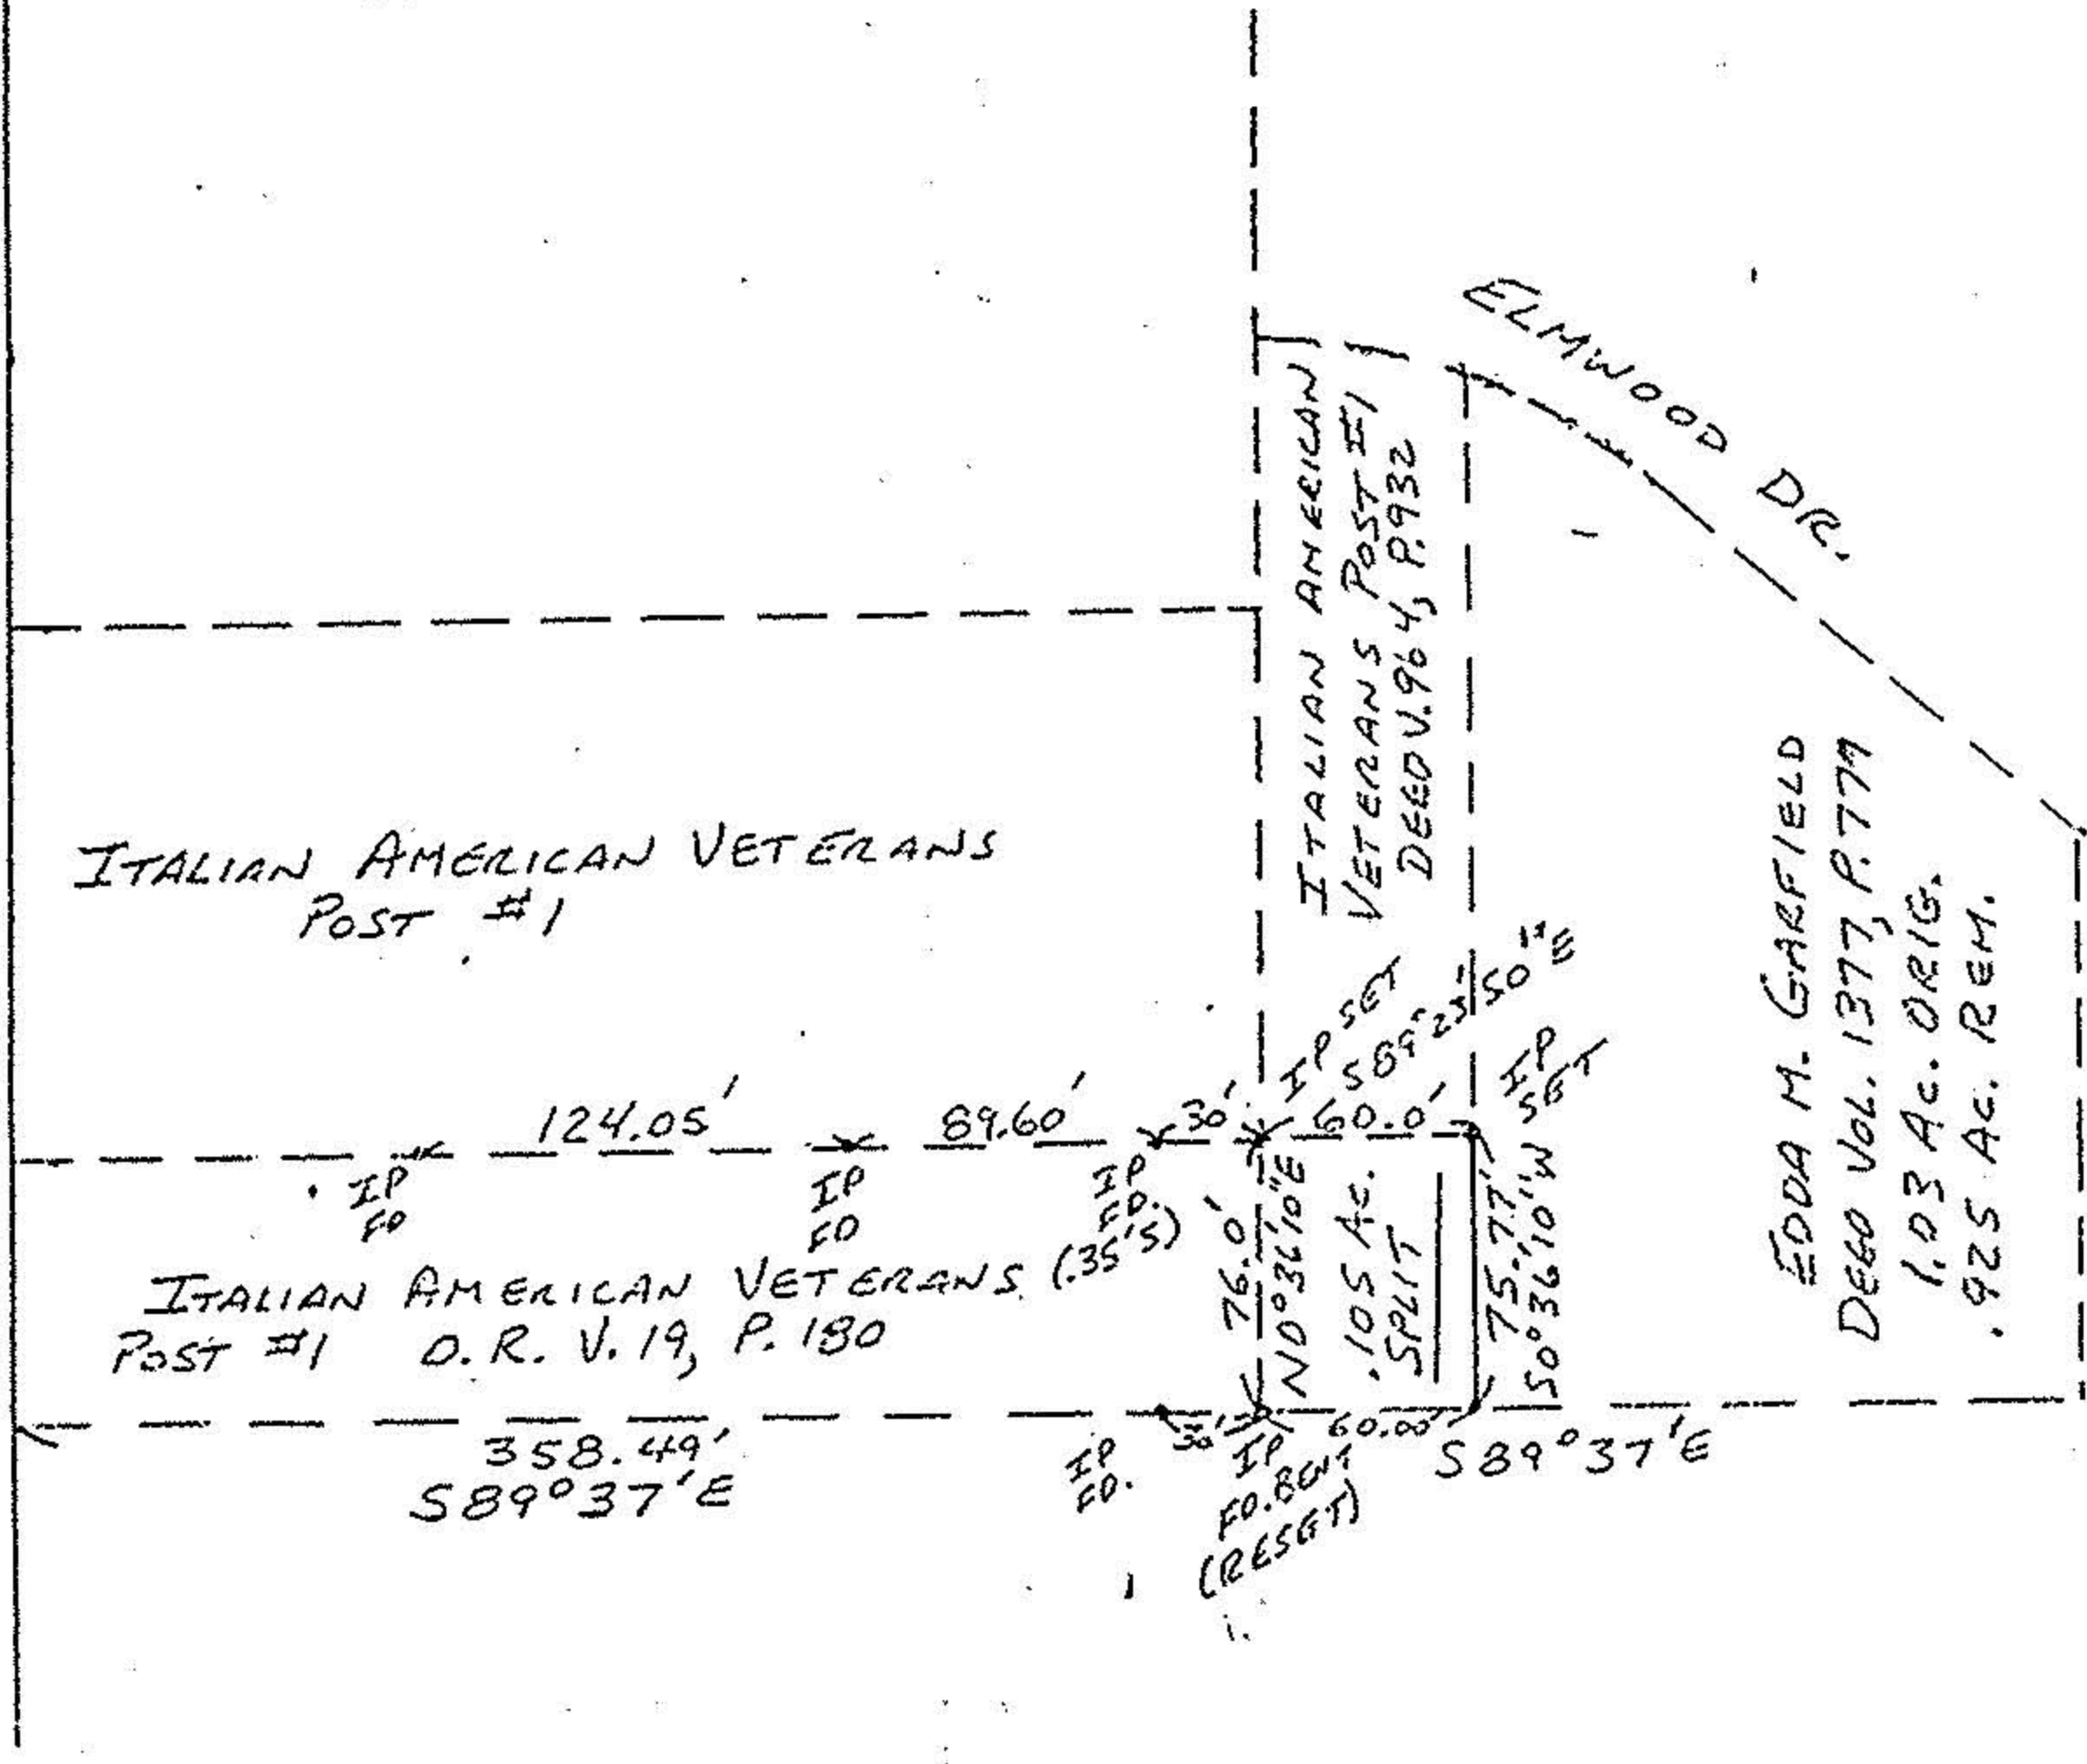

69092

APPROVED

AS TO DESCRIPTION ONLY

Date 16-June-1988

City of Lorain

Per Patrick M. Gannon
 Engineering Dept.

#17994



APPROVED
 LORAIN CO.
 MAP DEPT.

DATE 6-20-88

PAGE 2-01-008-A

BY Carol Francis

VOID AFTER #17994

02-01-008-101-