


WARREN
MANUEL
ETAL

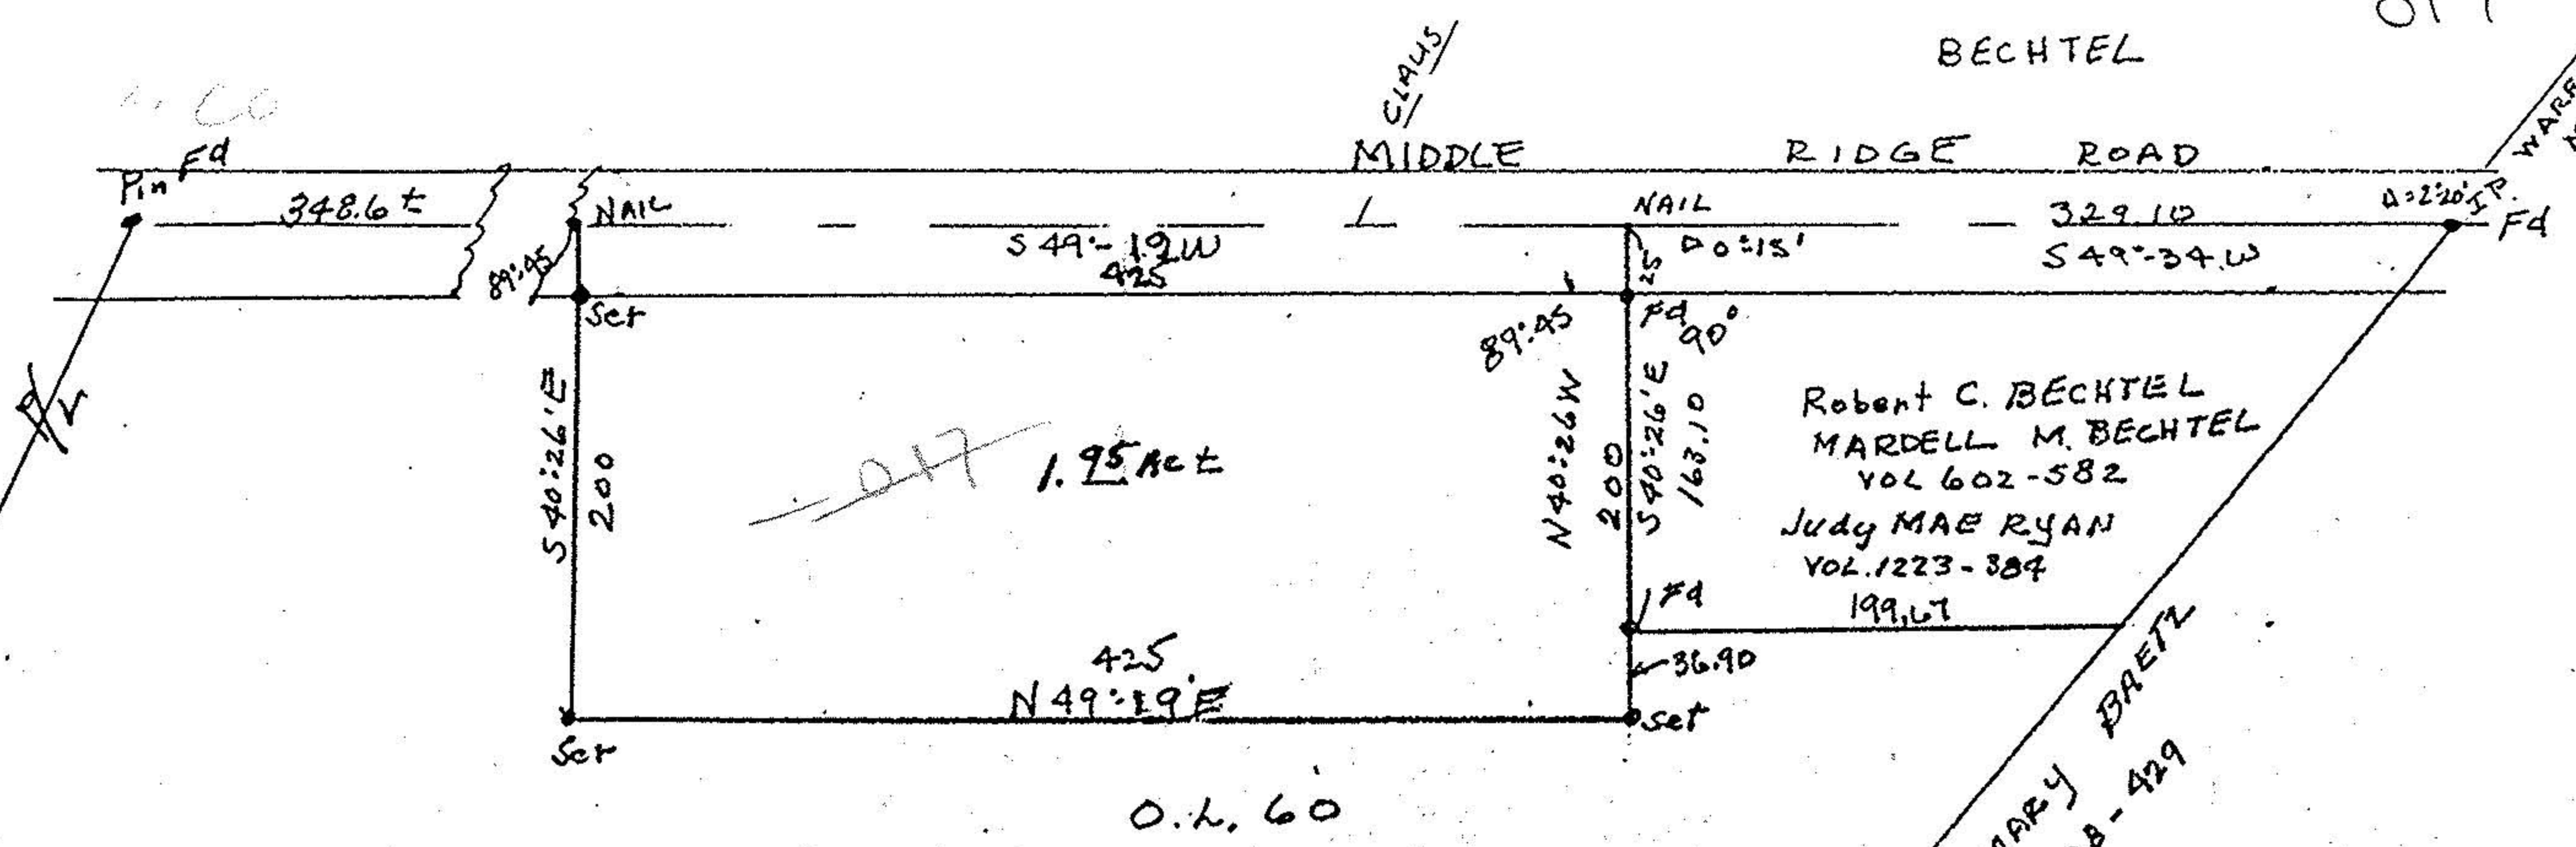

Map of Part of O.L. 60 Brownhelm Twp. Lorain Co. Ohio
 Scale 1" = 100'
 Aug. 7, 1984
 By Arnold F. Kepp Reg. Surveyor No. 4306

15915
~~010~~
 1-K

