


STATE OF OHIO
REGISTERED } PROFESSIONAL ENG. NO. 1586
SURVEYOR NO. 885

RAY E. HOLLIS
CIVIL ENGINEER & SURVEYOR
900 COLORADO AVENUE
LORAIN, OHIO 44052

LORAIN PHONE
ATLANTIC 8-4123
ELYRIA PHONE
FAIRFAX 2-5117

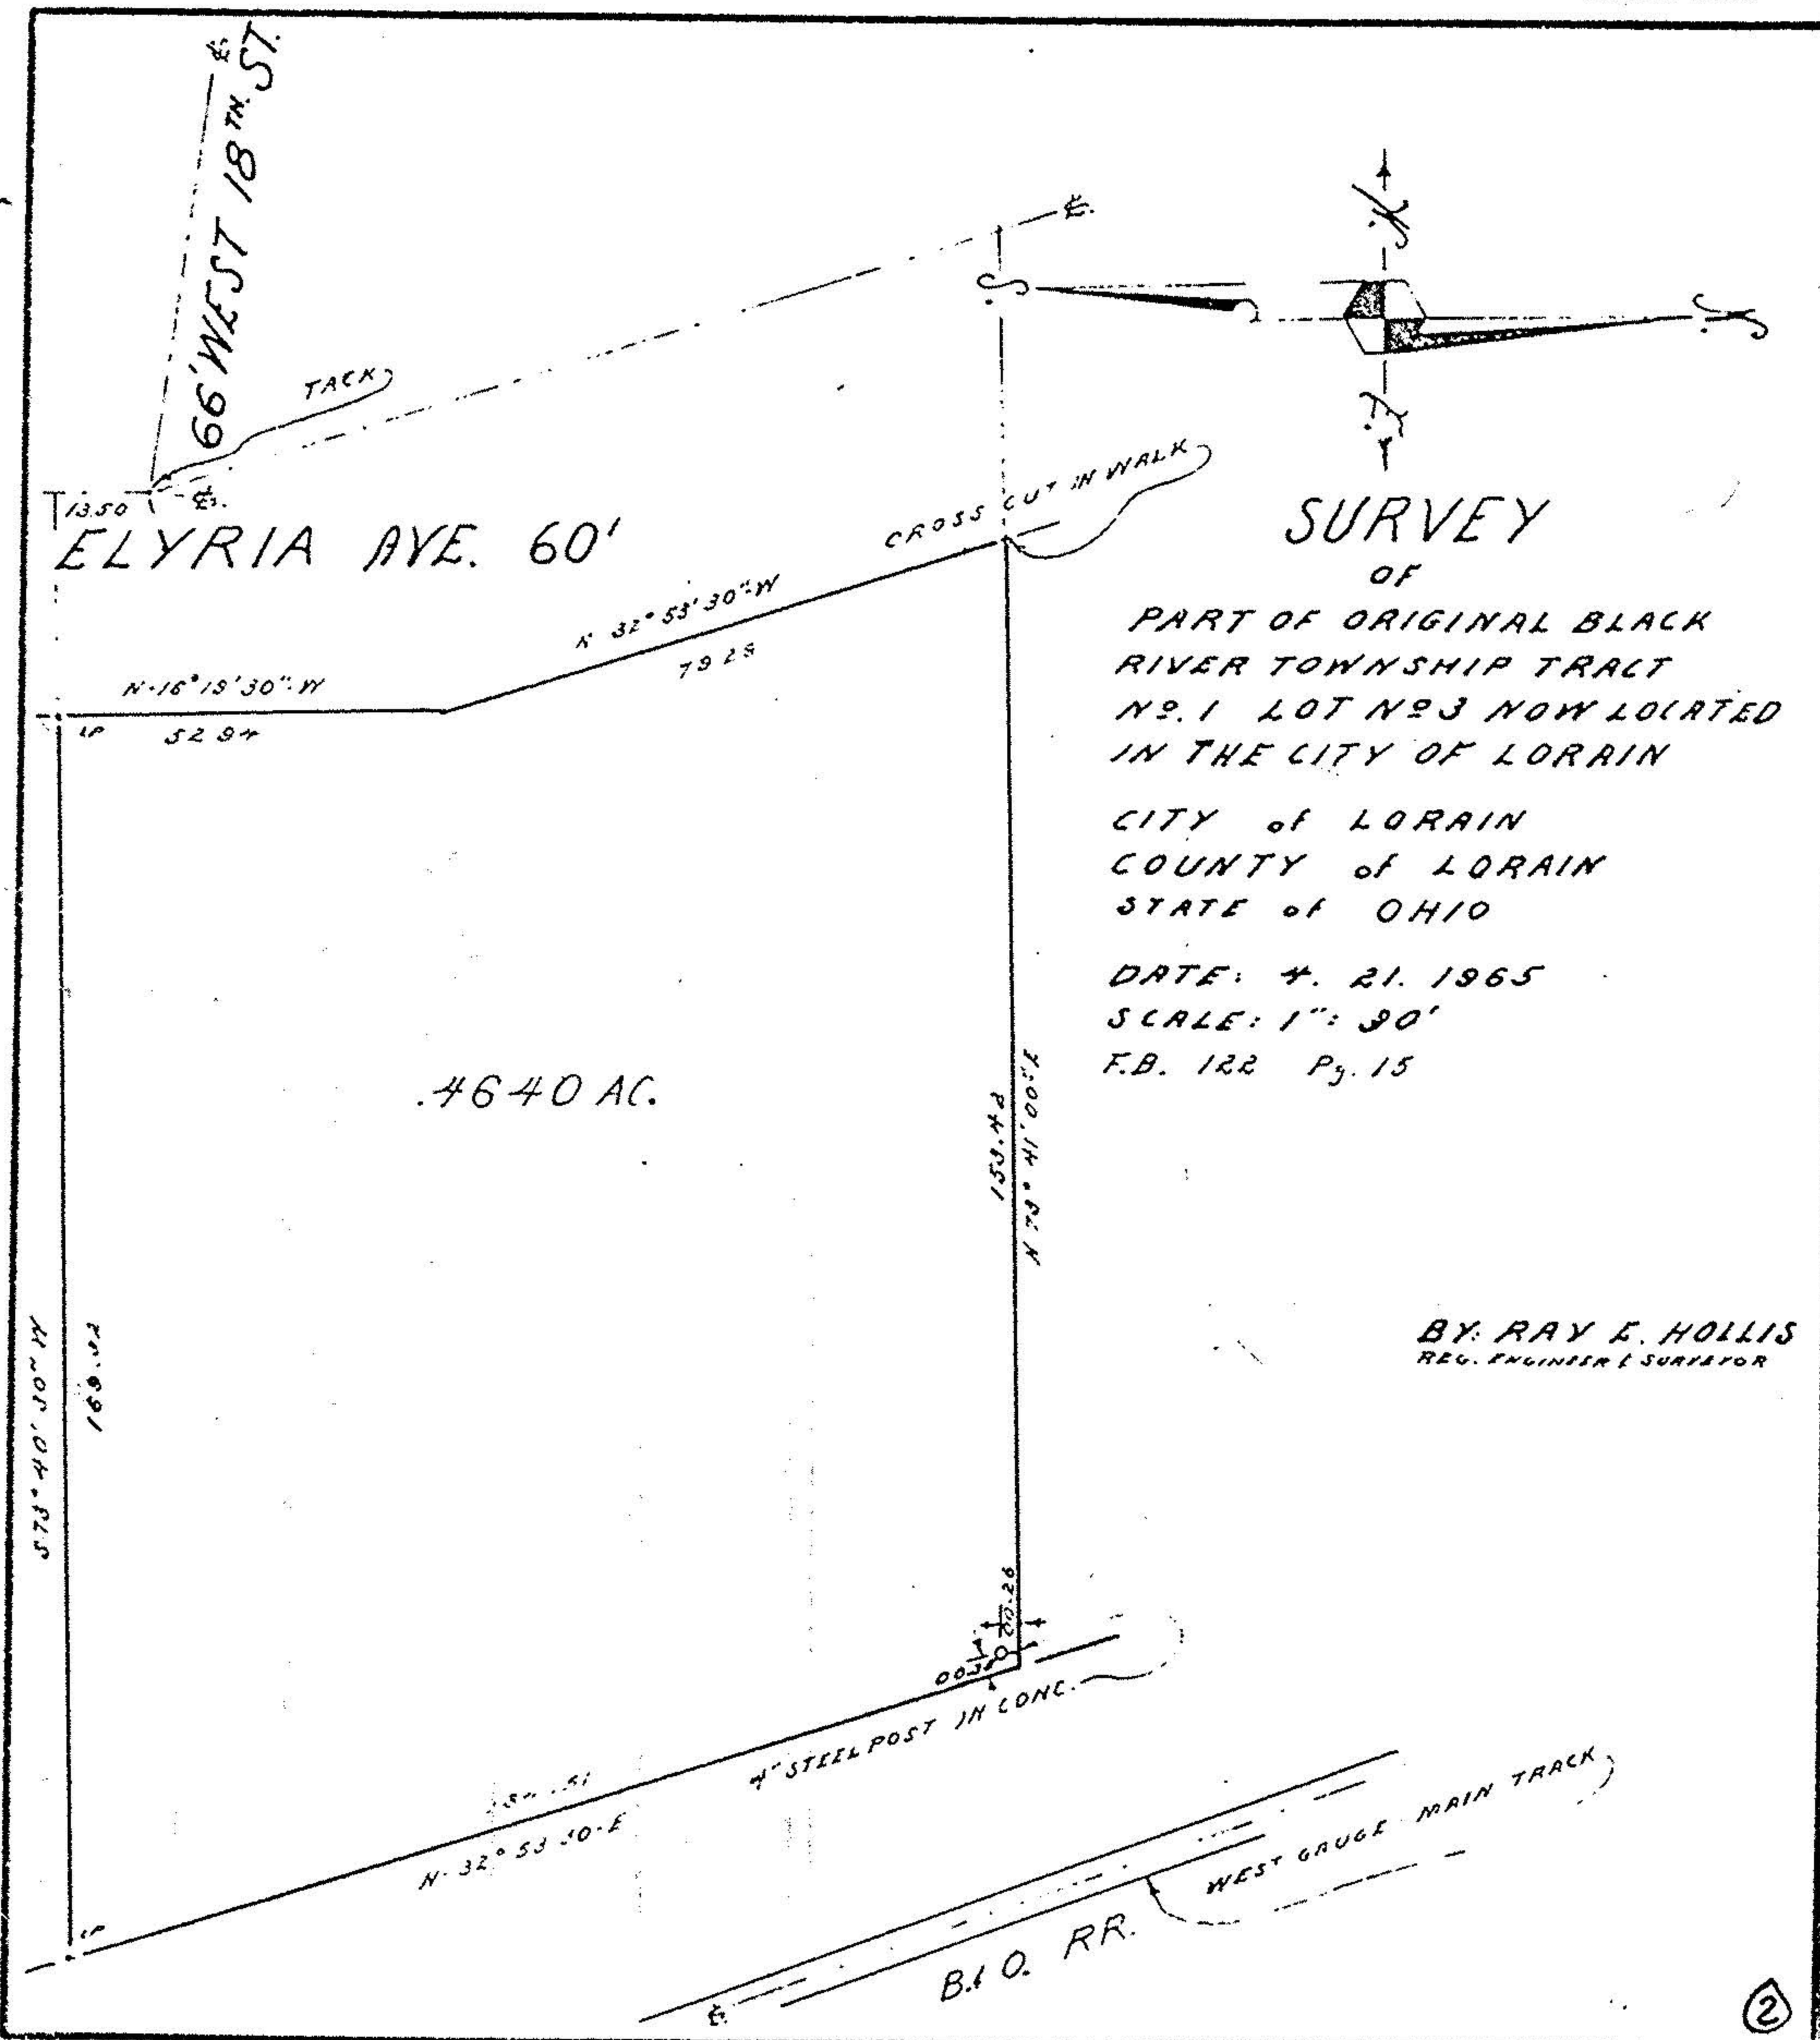

STATE OF OHIO
REGISTERED } PROFESSIONAL ENG. NO. 1586
SURVEYOR NO. 885

RAY E. HOLLIS
CIVIL ENGINEER & SURVEYOR
900 COLORADO AVENUE
LORAIN, OHIO 44052

2-01-003-F

LORAIN PHONE
ATLANTIC 8-4123
ELYRIA PHONE
FAIRFAX 2-5117

