



LAUNDON • SIMON • CAHL & ASSOC., INC.
 PROFESSIONAL LAND SURVEYORS
 110 MIDDLE AVE., ELYRIA, O. 44035

SURVEY FOR:

LORAIN COUNTY HABITAT
 FOR HUMANITY, INC.


Orig. Lot No. 3	City of LORAIN	Date 3-28-97 Scale 1" = 40'
Orig. Sec No.	Village of	Dwn. by R.G.S. Chkd. by R.C.
Tract 1	County of LORAIN	Job No. 97-2938 F.B. 240/51
Township of BLACK RIVER	State of Ohio	Printed

SURVEY of PART of S/L 210 plus S/L's 211, 212 & 213 of
 LORAIN STONE CO'S. 2ND SUBN. P.V. 6 P. 38

REV. 5-6-97 - SUBN. NAME

DAPTON AVE. 60'

DUE NORTH

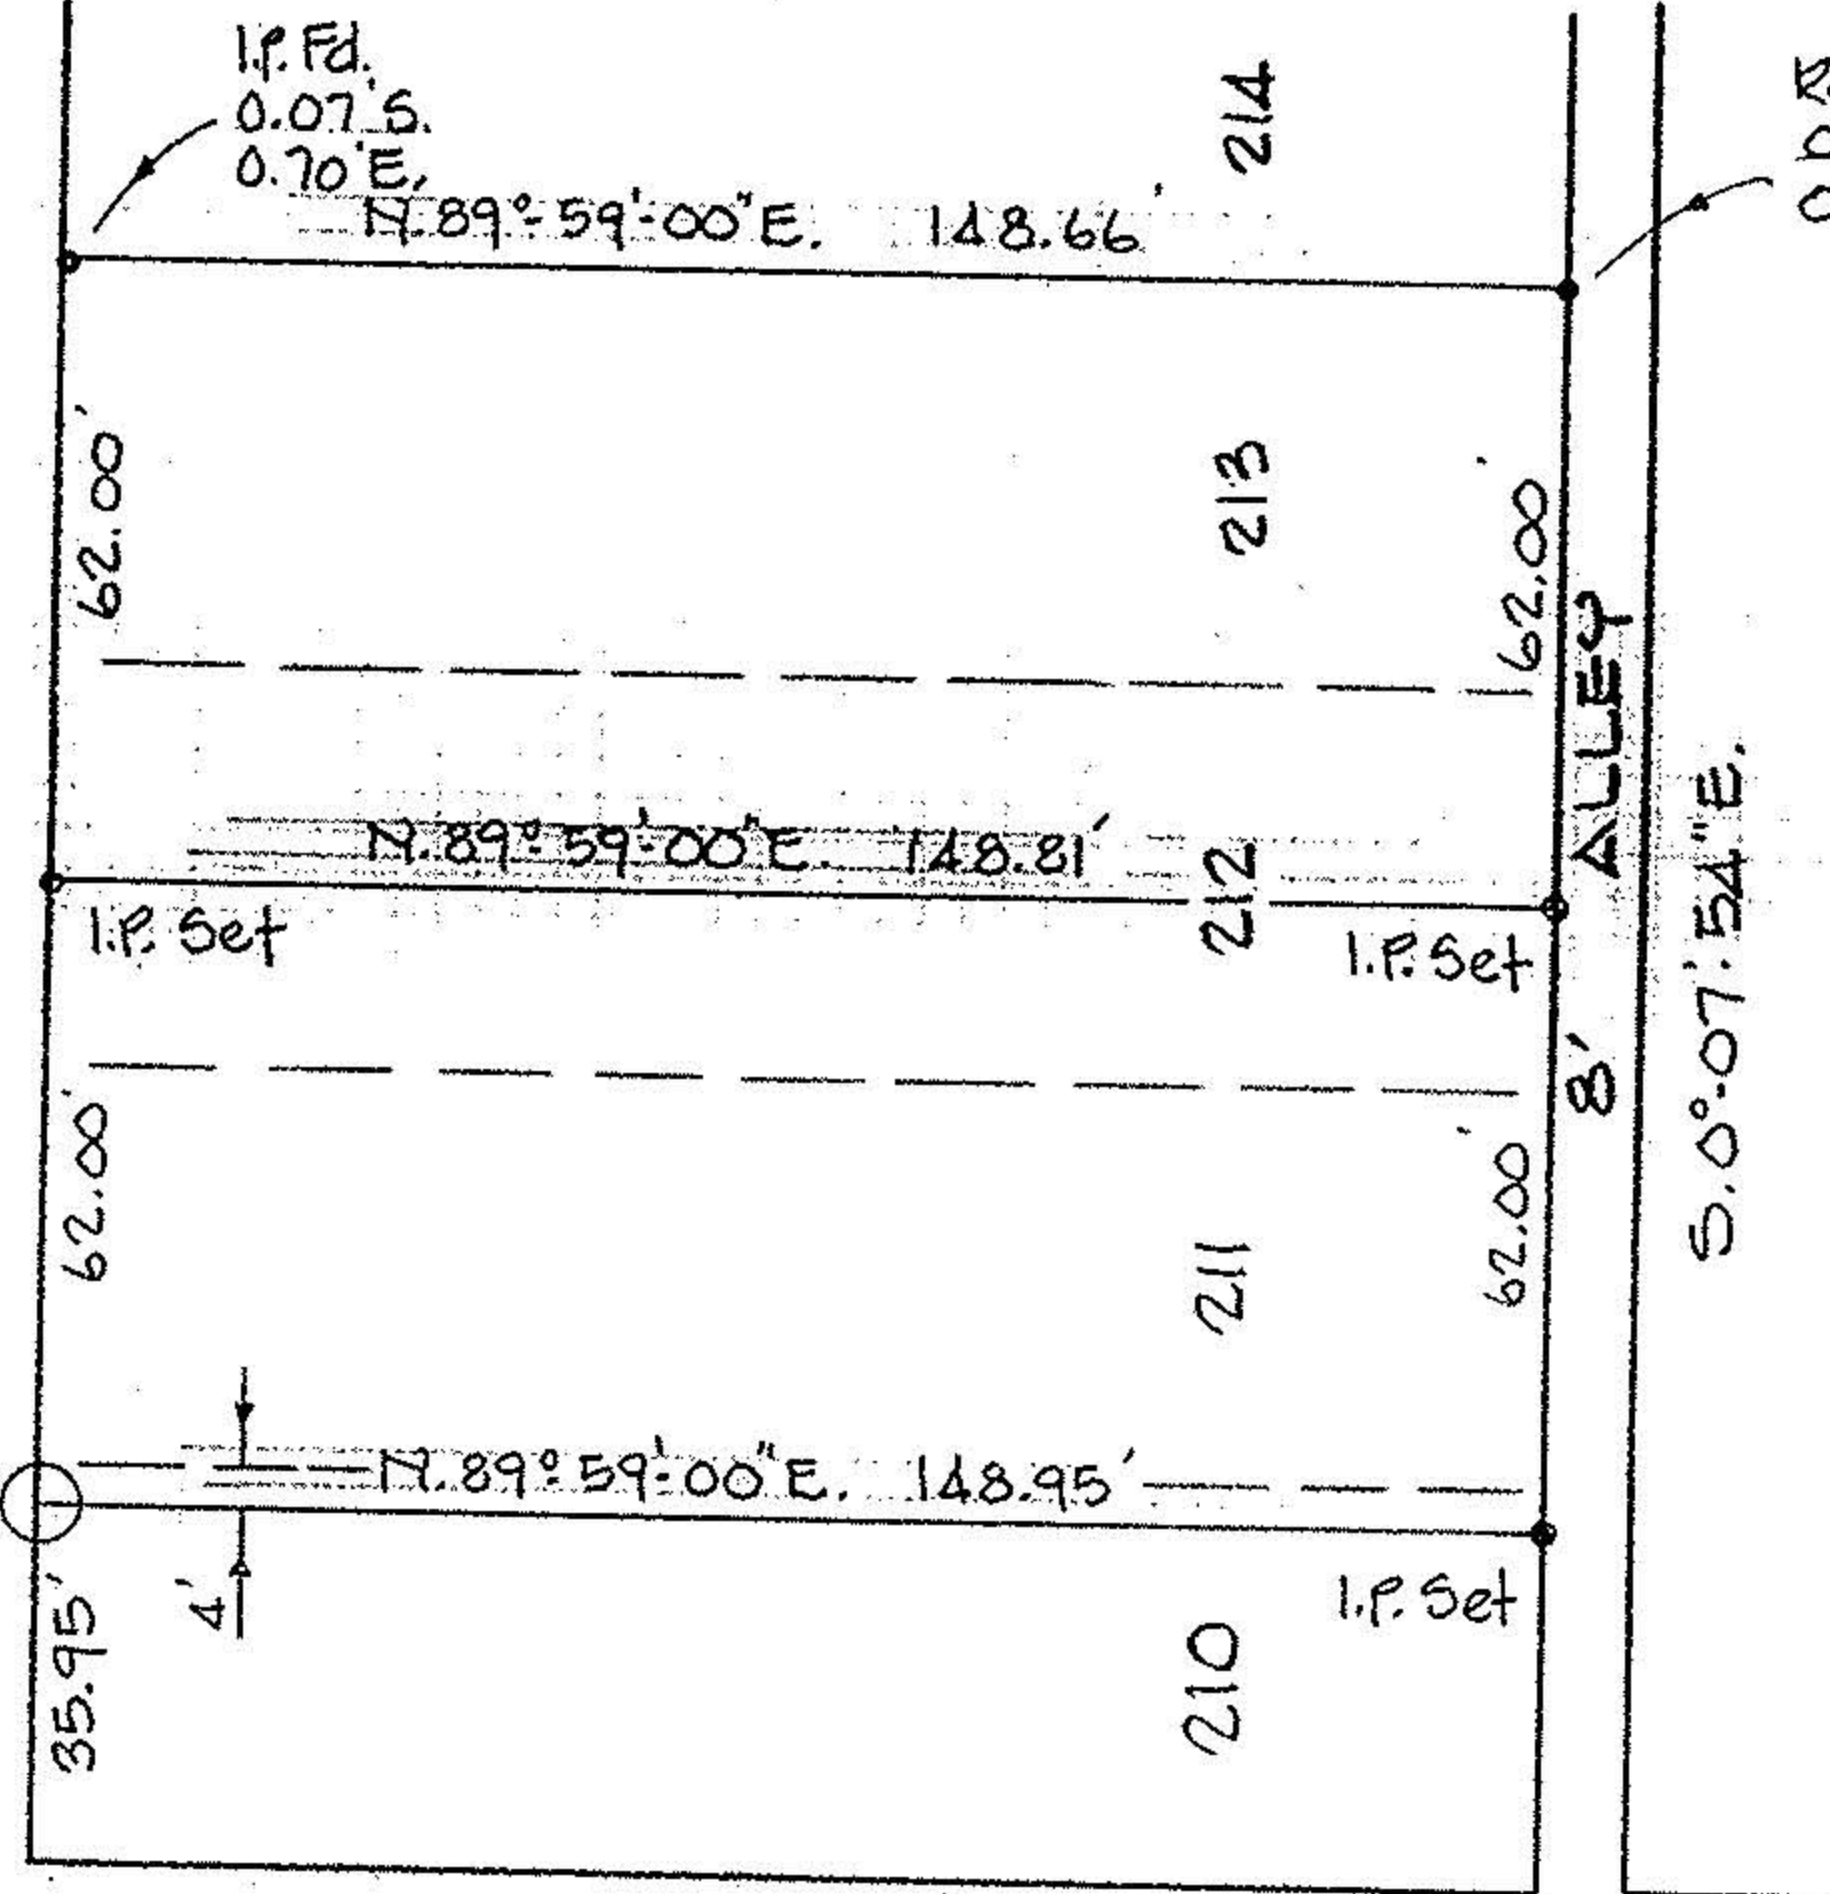

2 I.P.s Fd. at this cor.
 1 Fd. bent 0.2'S
 & 1 Fd. 0.27'S - 0.4'E.

WEST 38TH ST. 60'

N



I.P. Fd. 1' deep Used

347.00' R. & M.

I.P. Fd. - Used

SLY. LINE S/L 201

NOTE:

BEARINGS ARE TO AN ASSUMED MER-
 IDIAN AND ARE USED FOR DESCRIPTIVE
 PURPOSES ONLY.

02-01-003