




LAUNDON • SIMON • CAHL & ASSOC. INC.
 CONSULTING ENGINEERS & SURVEYORS
 504 MIDDLE AVENUE ELYRIA, OHIO 44035

SURVEY FOR
KAZIMIERZ G. & DIXIE O. KSIĄZEK

Orig. Lot 3	City of LORAIN	Date 5-11-84	Scale 1"=40'
Orig. Sec	Village of	Dwn. by R.G.S.	Chkd. by J.C.
Tract 1	County of LORAIN	Job No. 84-1283	F.B. 98 P. 36
Township of BLACK RIVER	State of OHIO	Printed	

NOTE:

BEARINGS SHOWN ARE ASSUMED
 AND ARE USED TO DESCRIBE
 ANGLES ONLY.

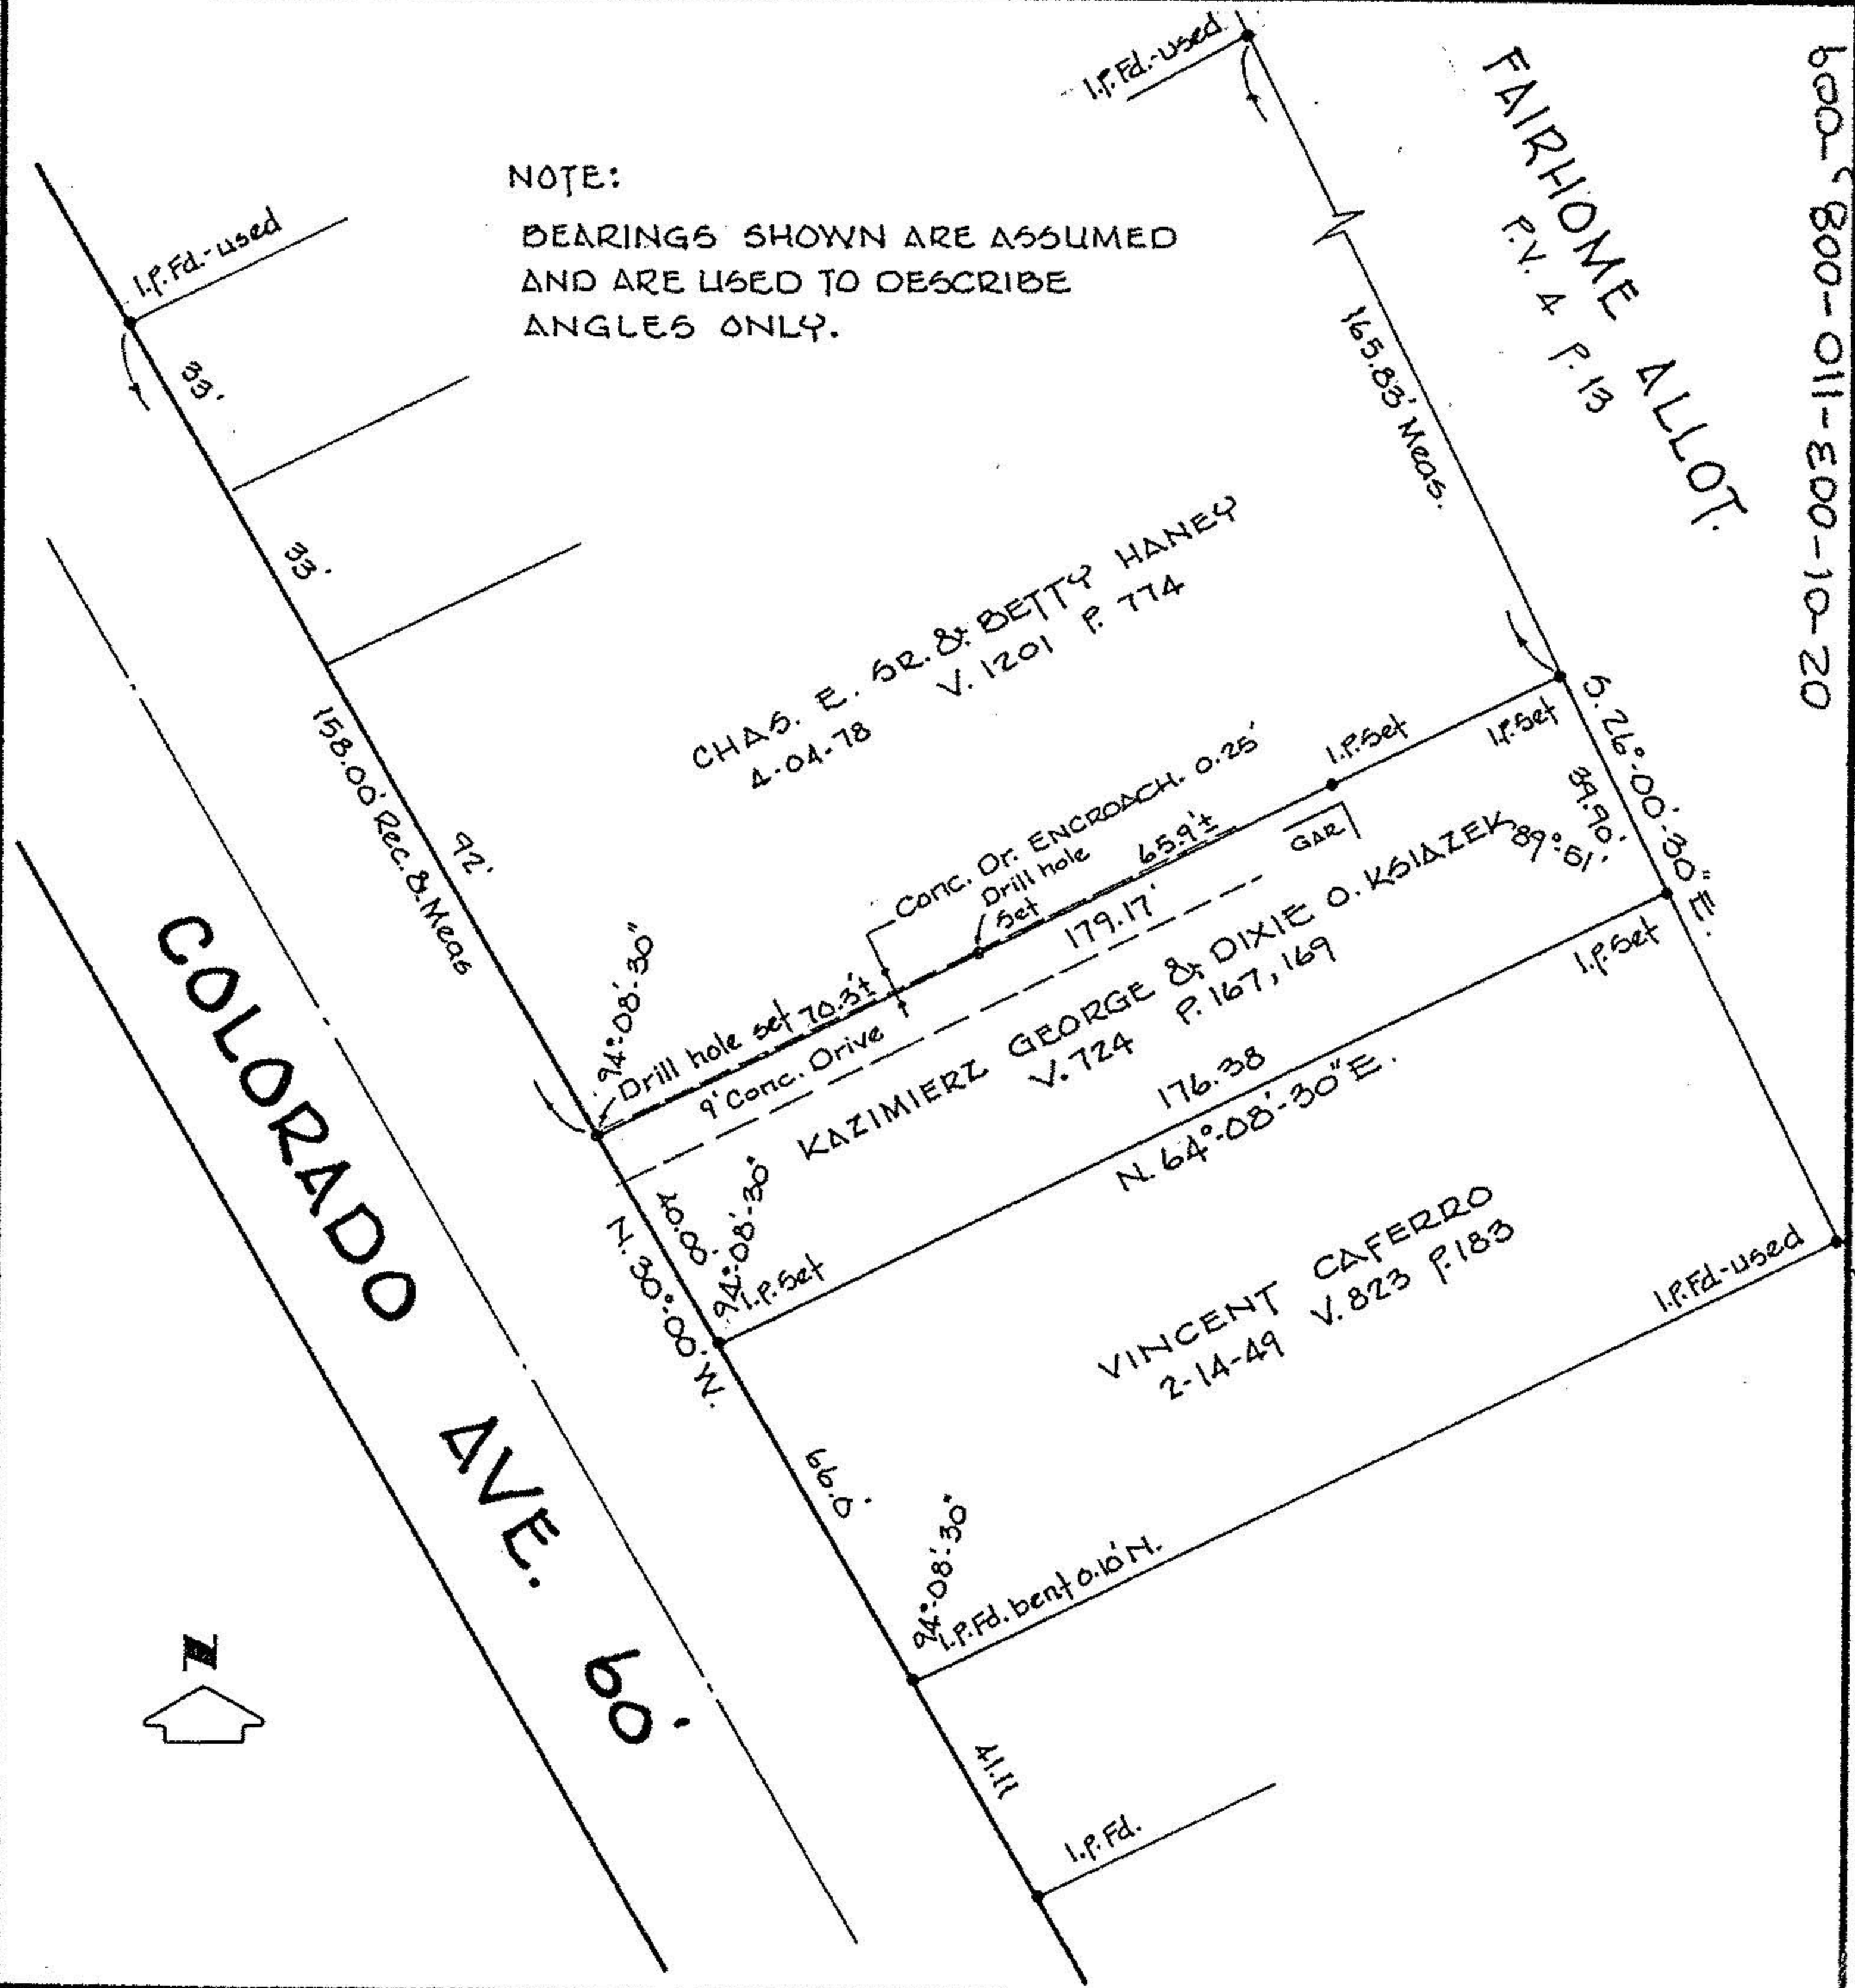

600-800-011-300-10-20