


Situated in the Township of Black River Lot No. 3, in Tract No. 1, County of Lorain and State of Ohio. Surveyed by Howard E. Smith P.S. No. 4403 (Ohio) May 1975

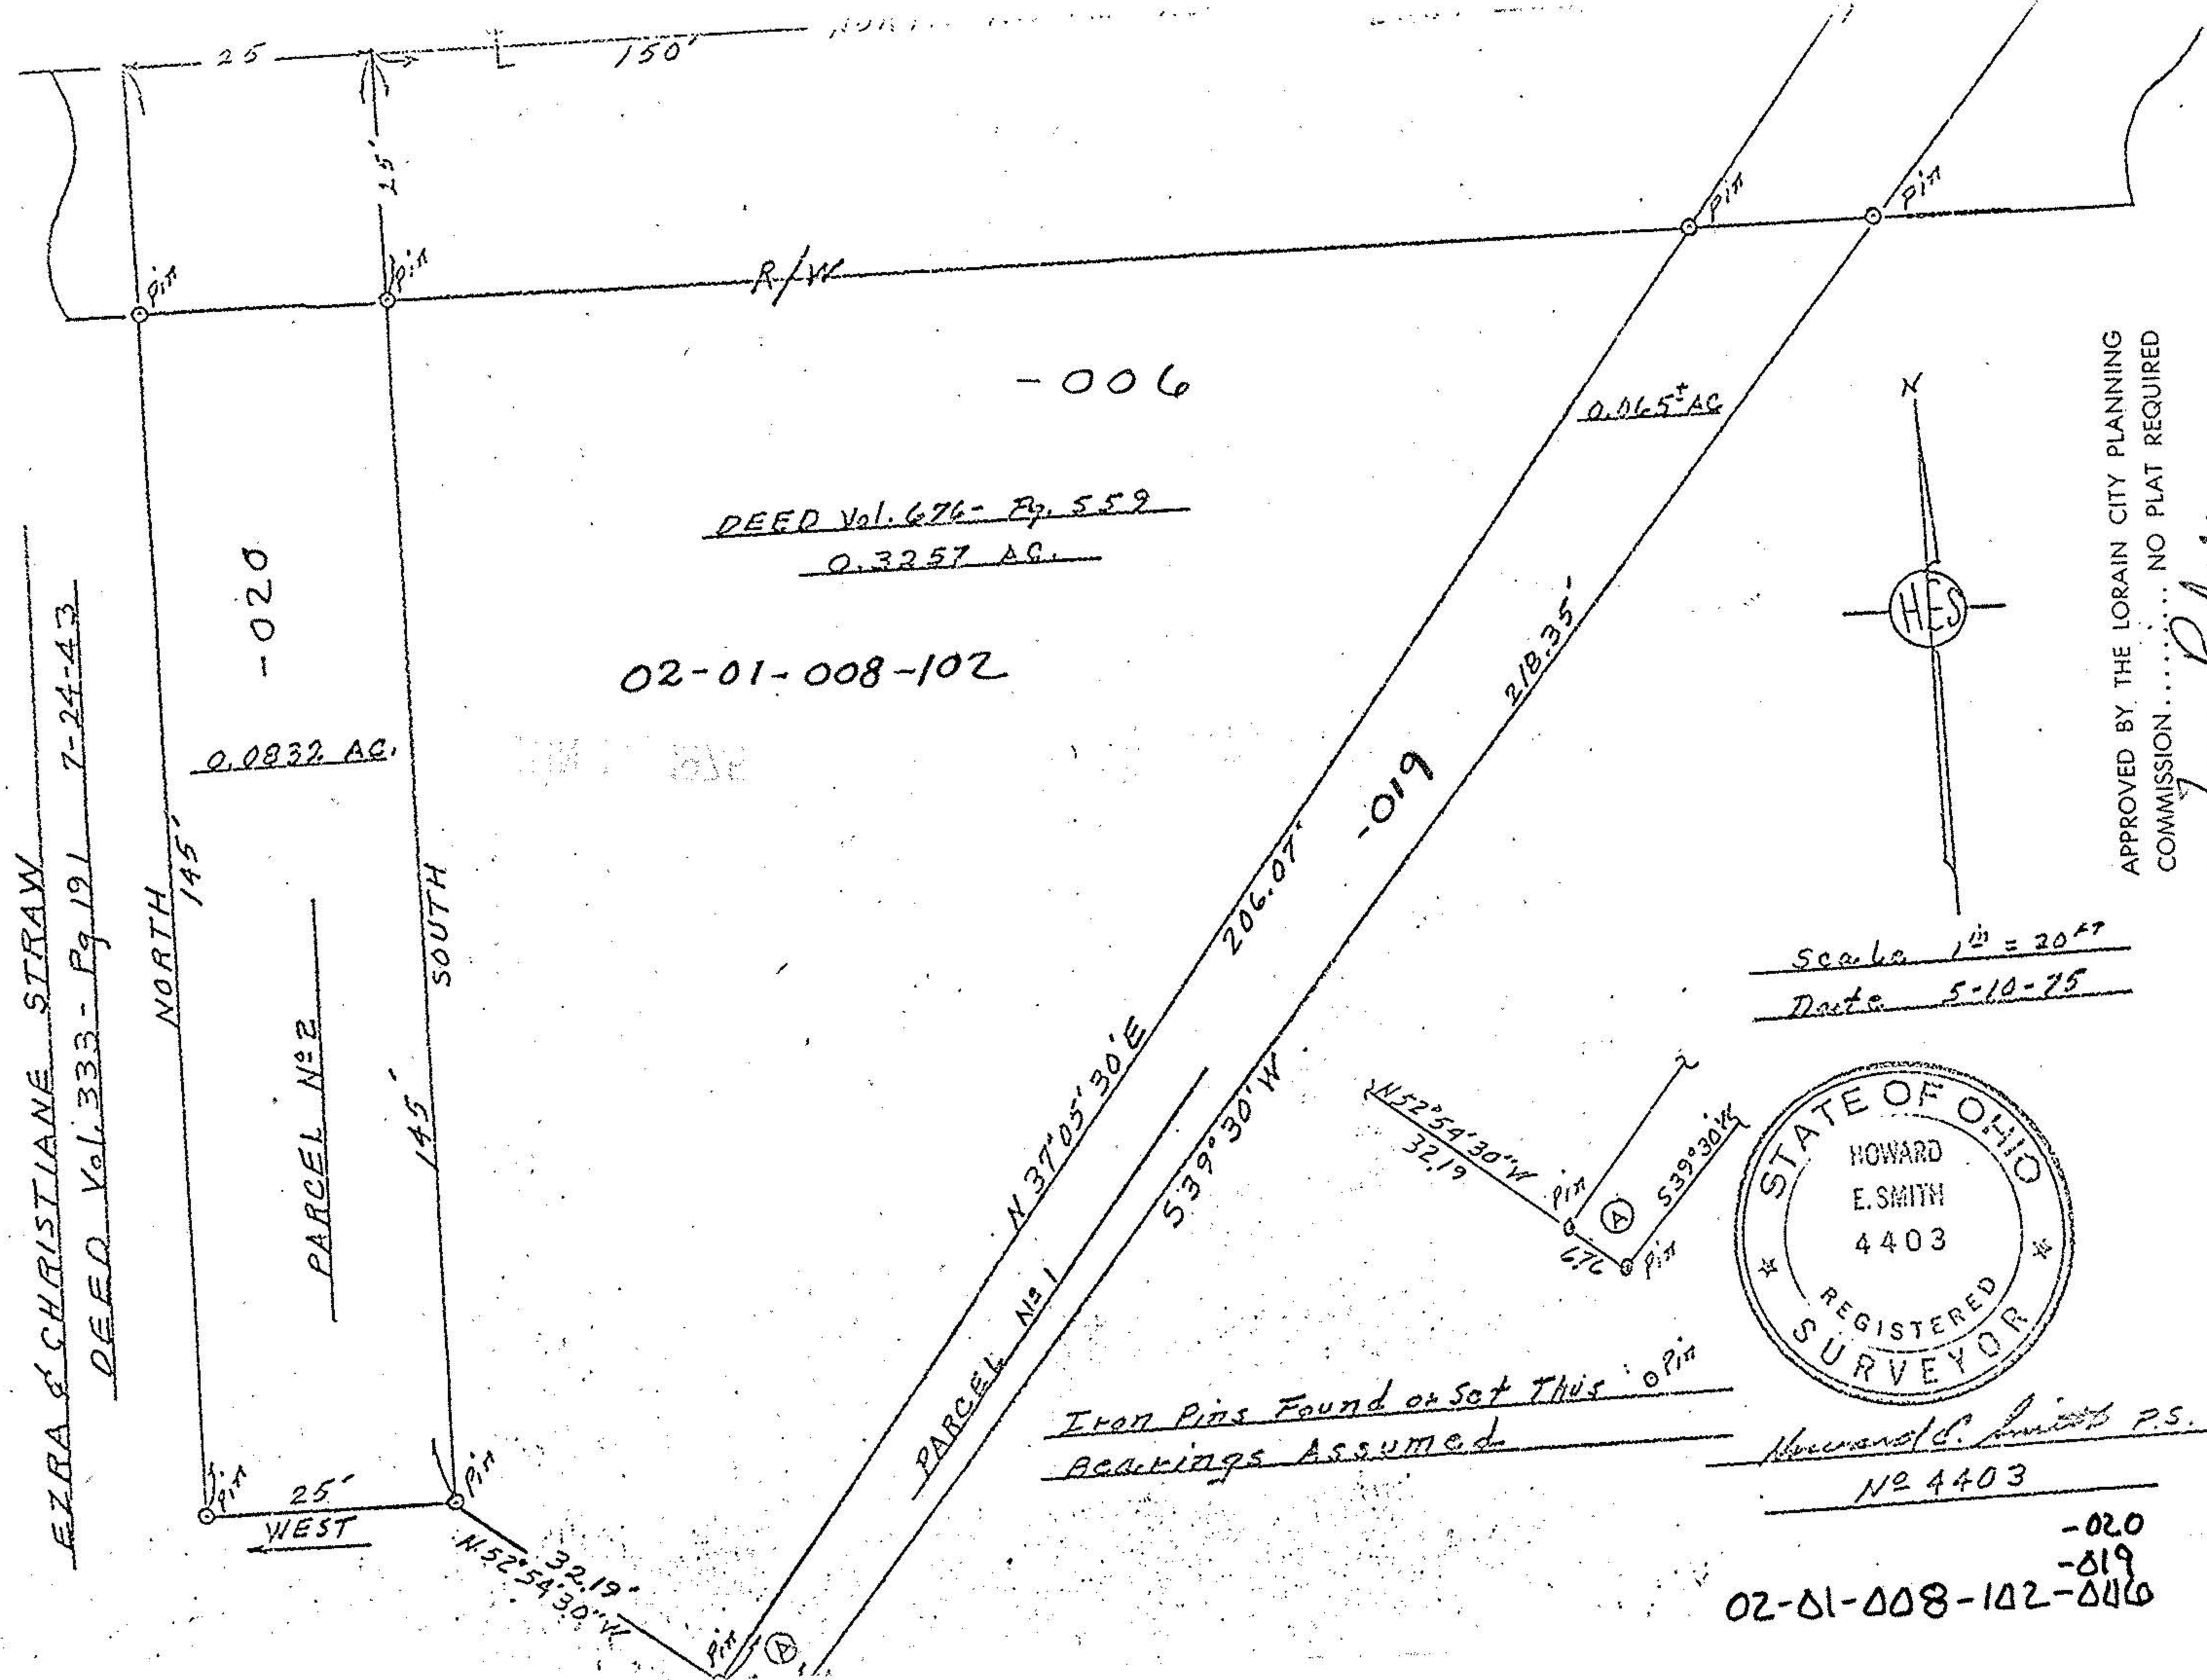

02-01-008-102-019
-020