

MAP OF SURVEY OF LAND
 FOR BUD GARFIELD
 BLACK RIVER TWP. - TRACT 1 S.E. 8
 CITY OF LORAIN
 JOHN R. HAMILTON - REG. SURV. #6861
 MAY 1988 SCALE 1"=100'


NORTH
 SCALE 1"=100'

OBERLIN AVE.

68092

APPROVED

AS TO DESCRIPTION ONLY
 Date 16-June-1988
 City of Lorain
 Per Patrick M. Gannon
 Engineering Dept.

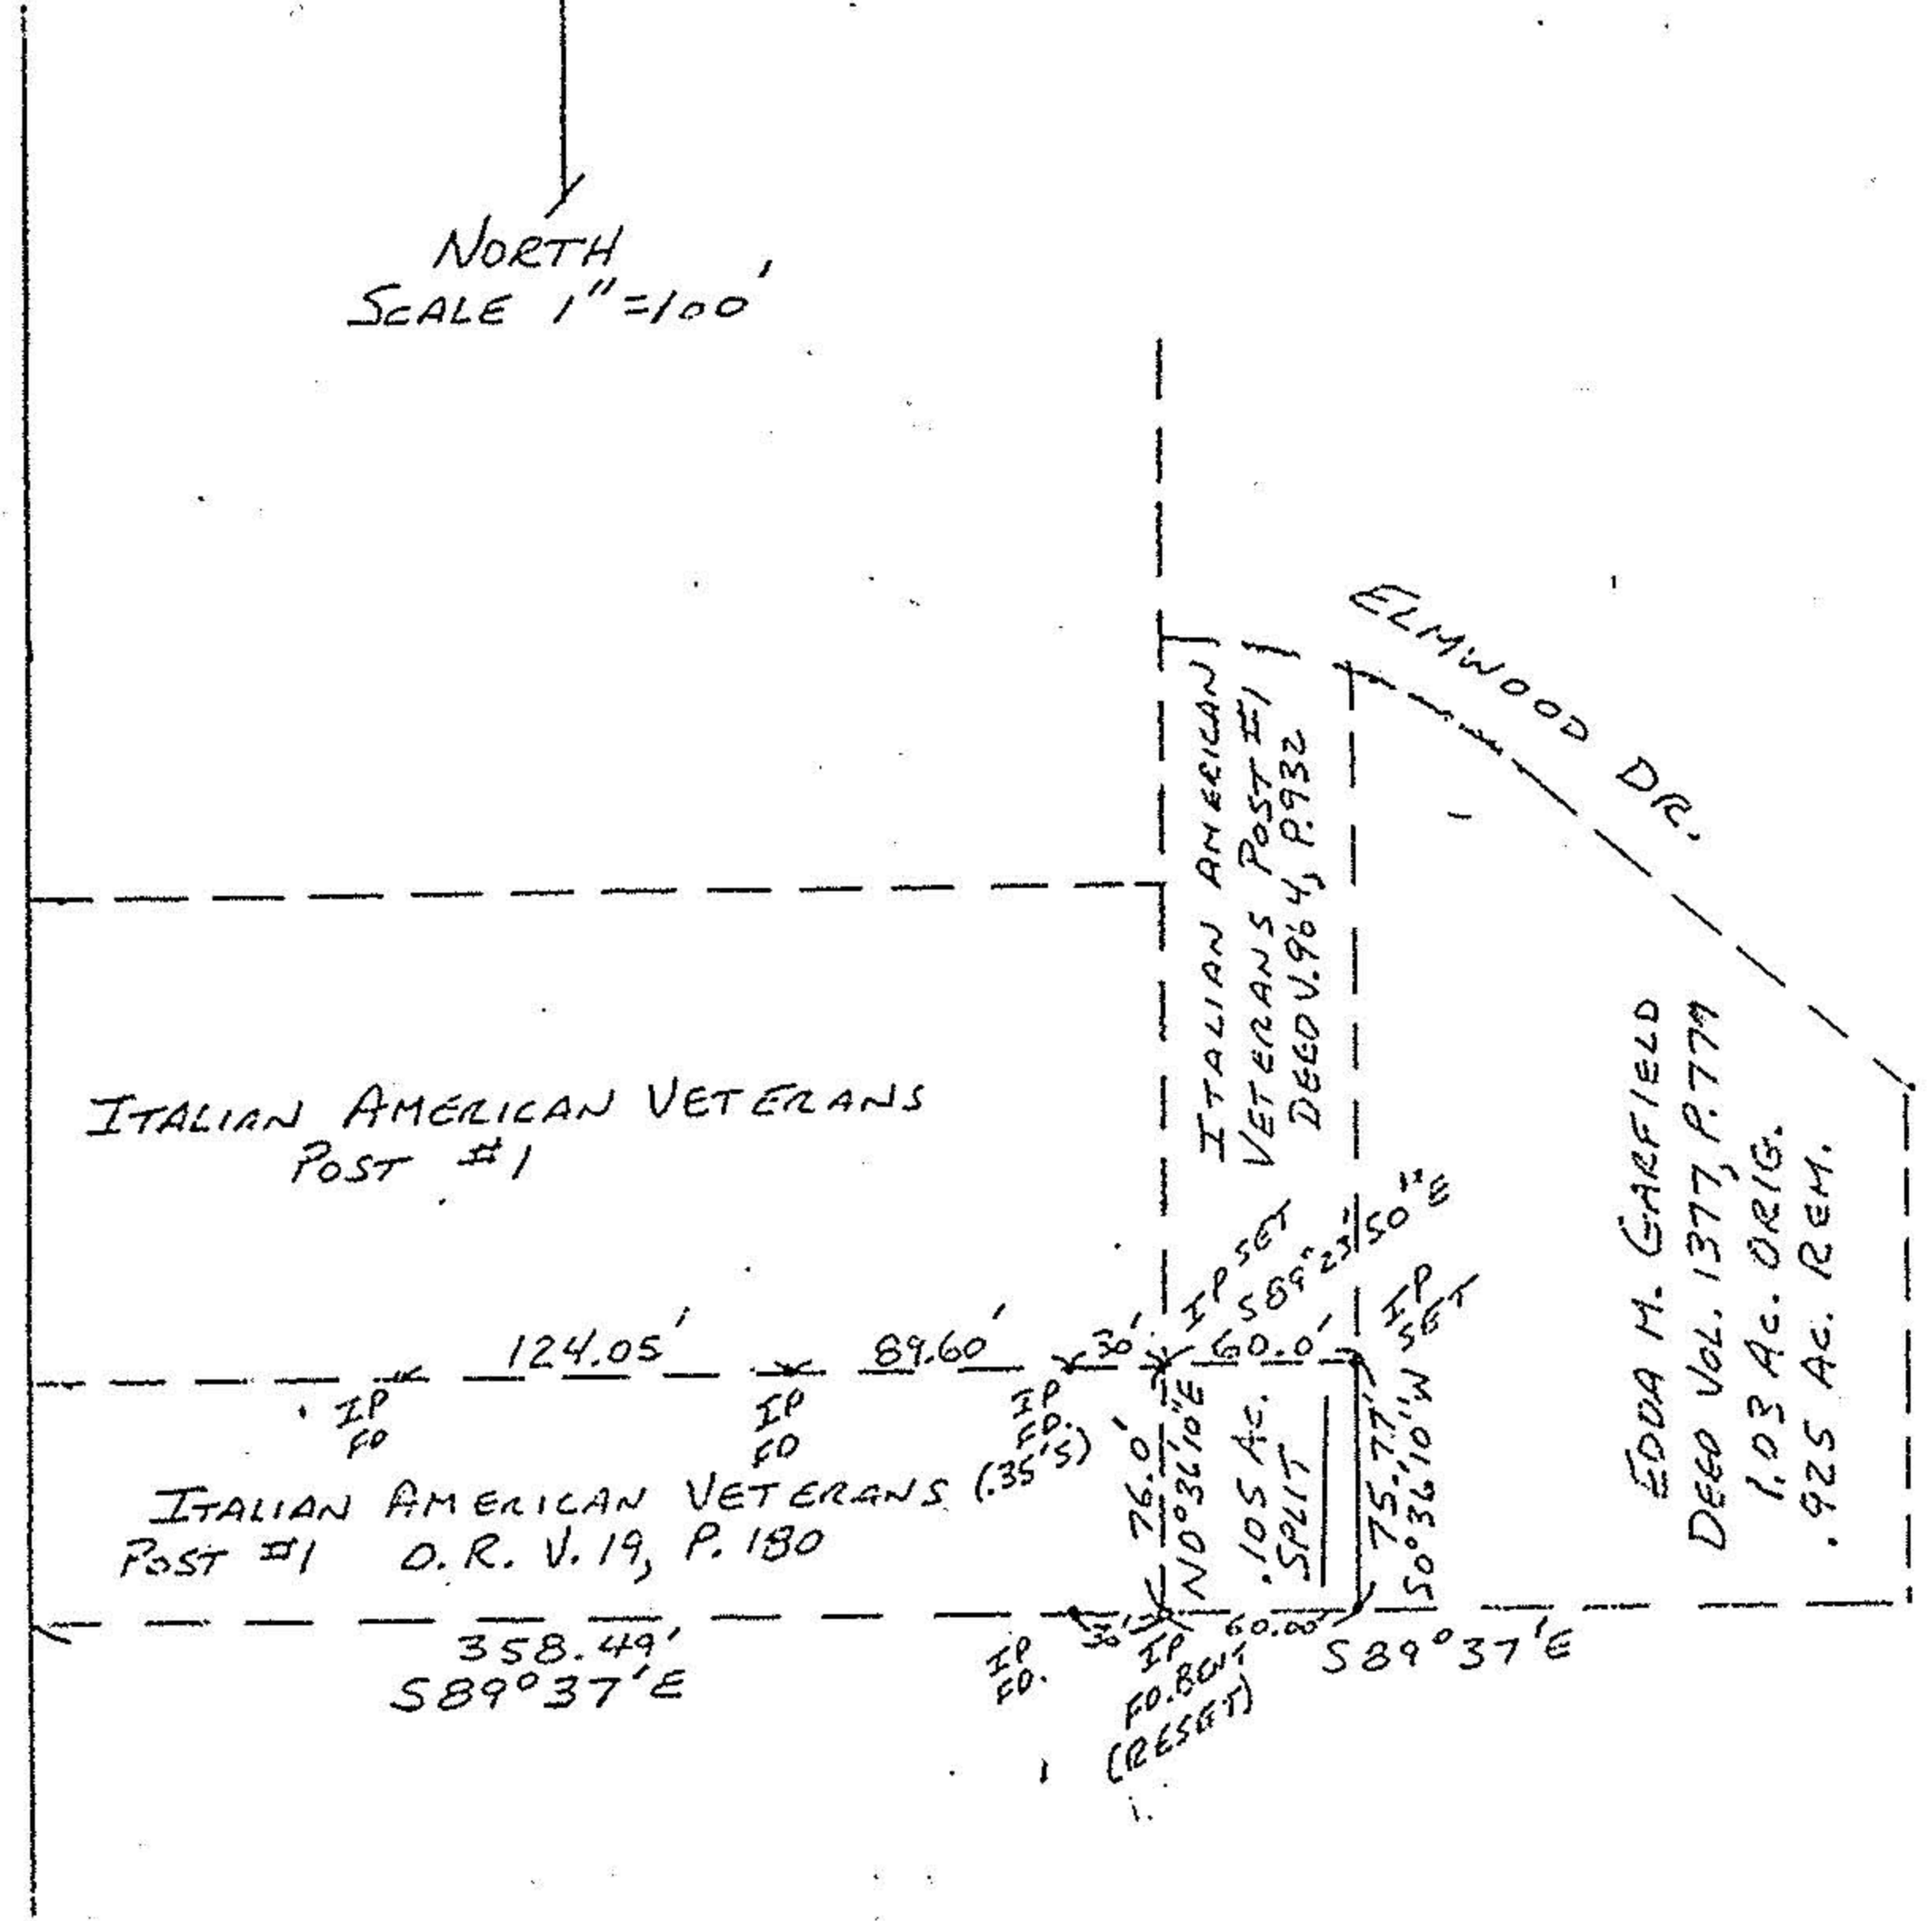

#17994

APPROVED LORAIN CO. MAP DEPT.
DATE <u>6-20-88</u>
PAGE <u>2-01-008-A</u>
BY <u>Carol Francis</u>
VOID AFTER <u>#17994</u>

02-01-008-101-