


2-01-006-47

02-01-006-190-109

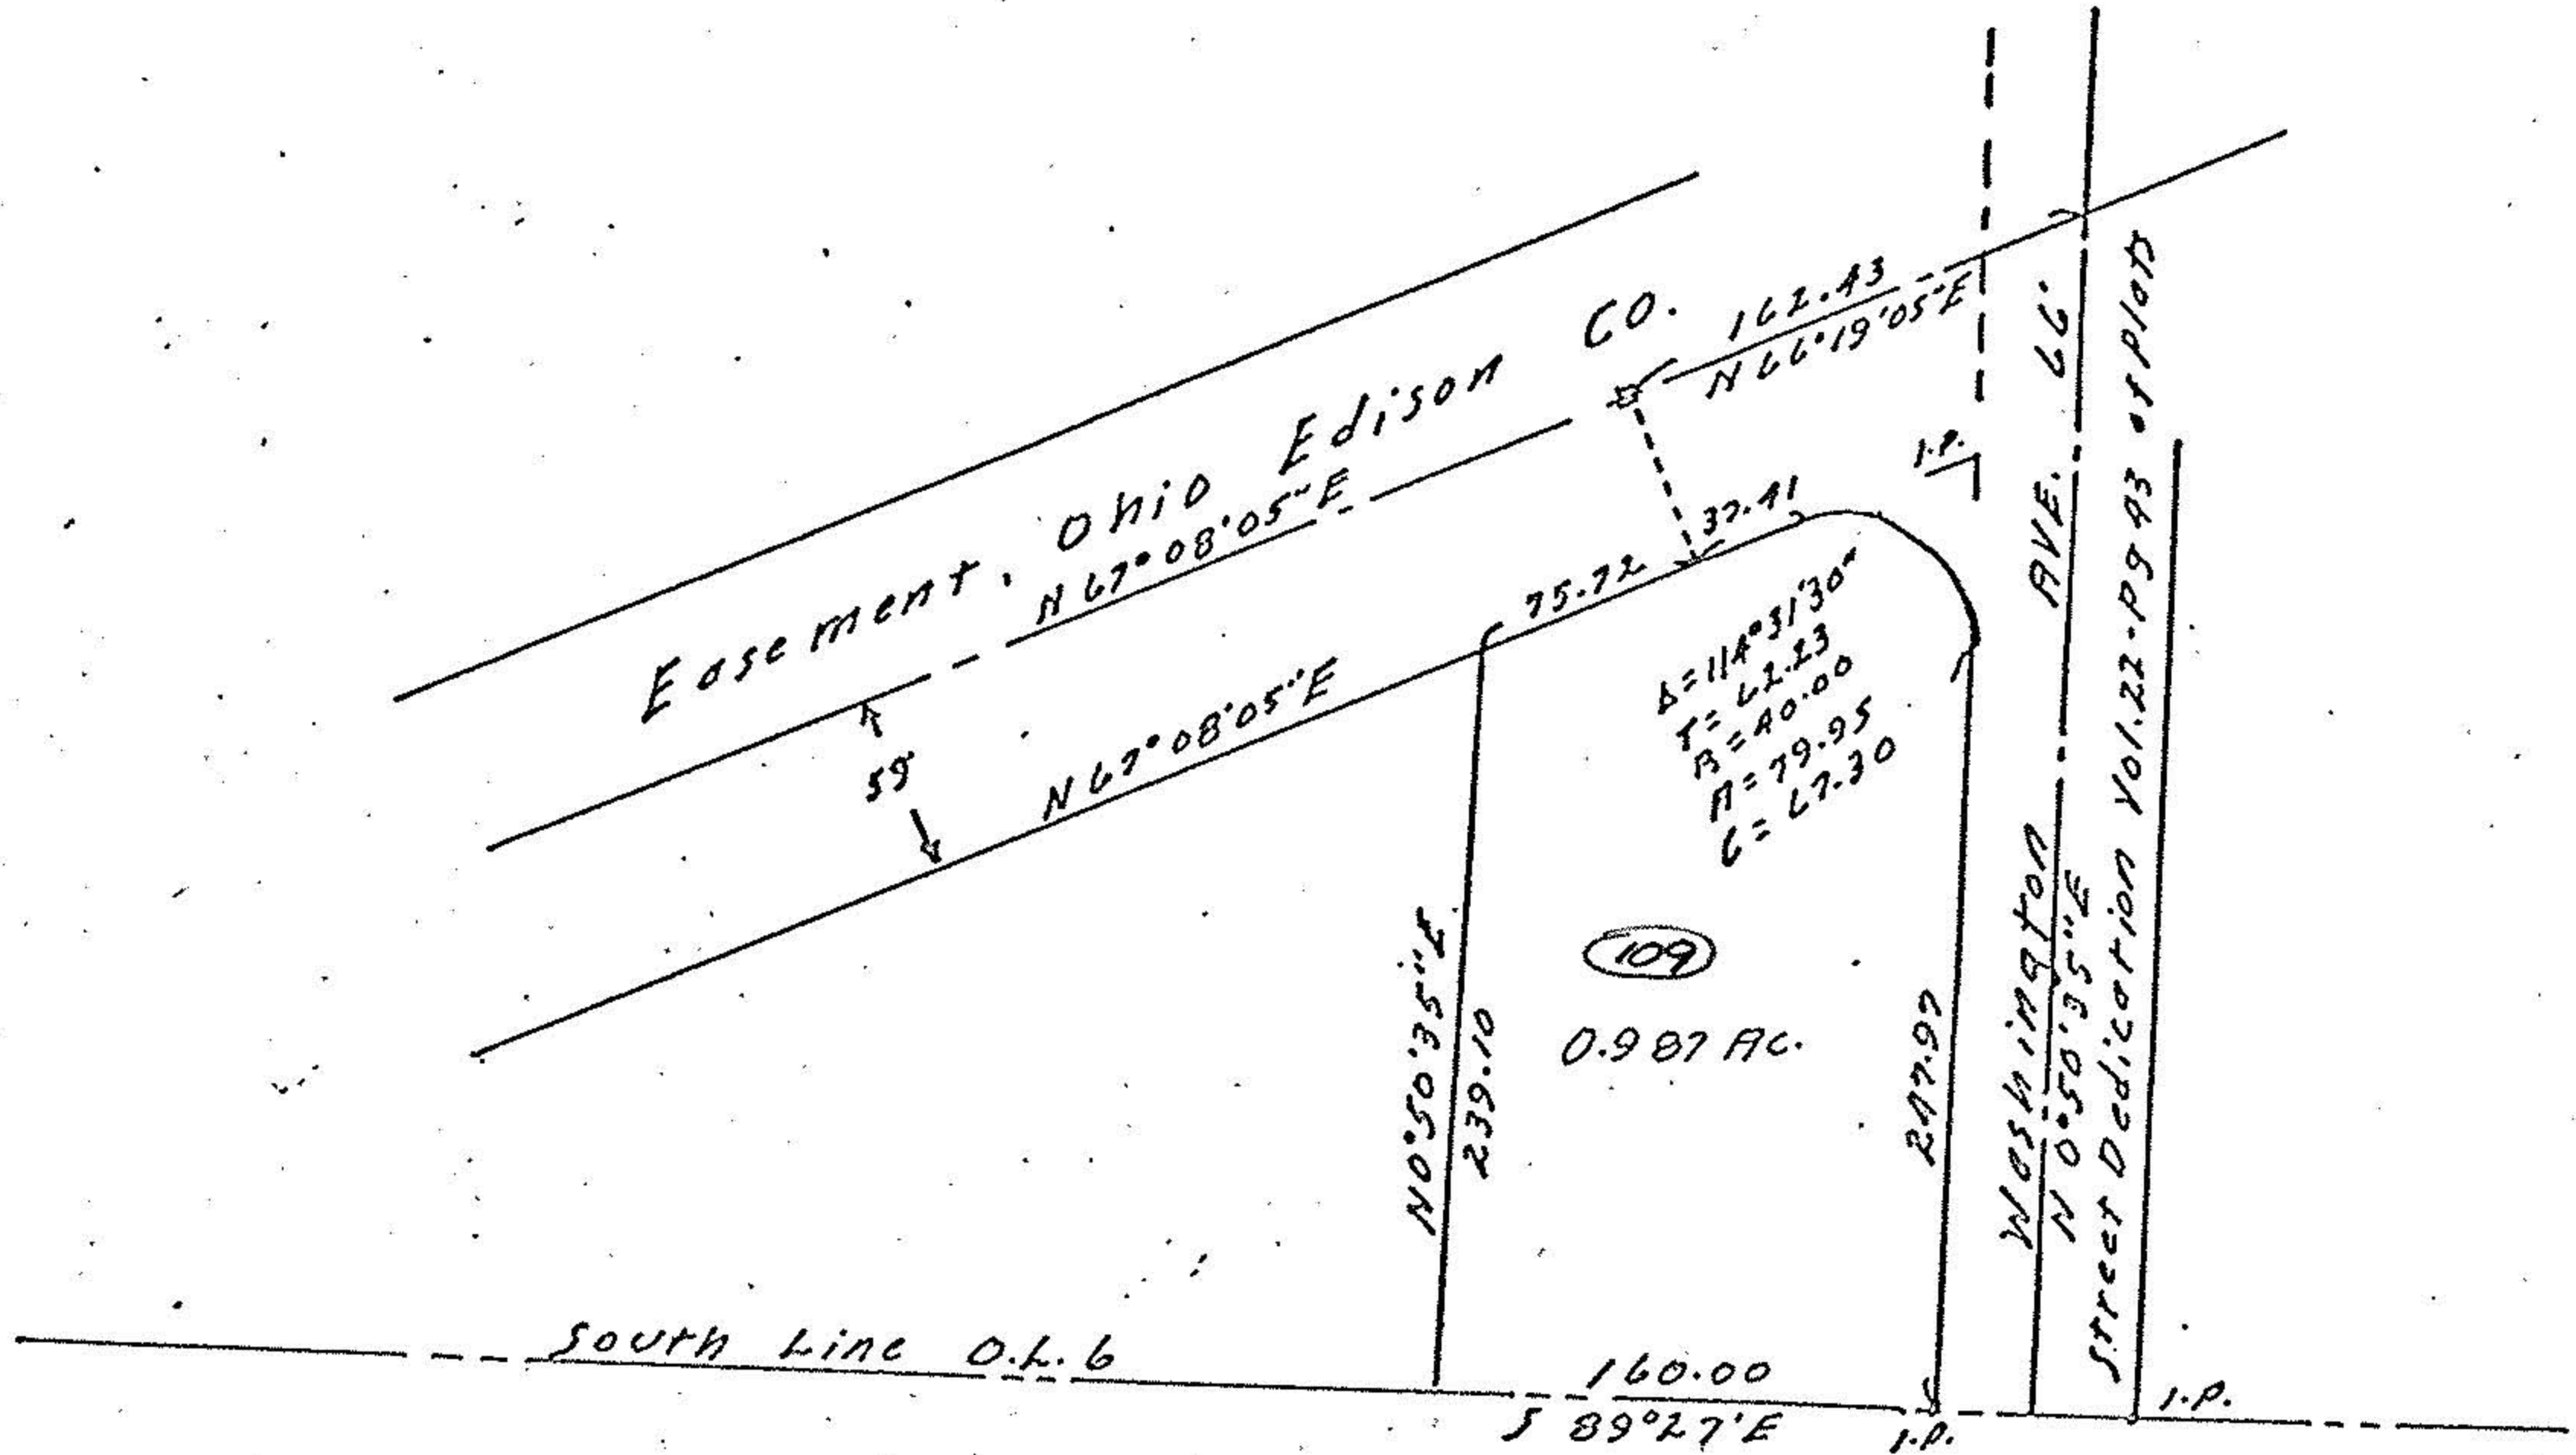

SURVEY
 Part of O.L.6 Tract 1
 Black River Township
 Lorain City, County of
 Lorain, Ohio - Nov. 1965
 William B. Barton, Reg. Surveyor
 Scale 1" = 100'

