


02-03-004-000-
02-03-005-102-

THE CROSS HATCHED LAND MUST
BE TRANSFERRED FROM
LORAIN C.C. INC. TO
F.W.12

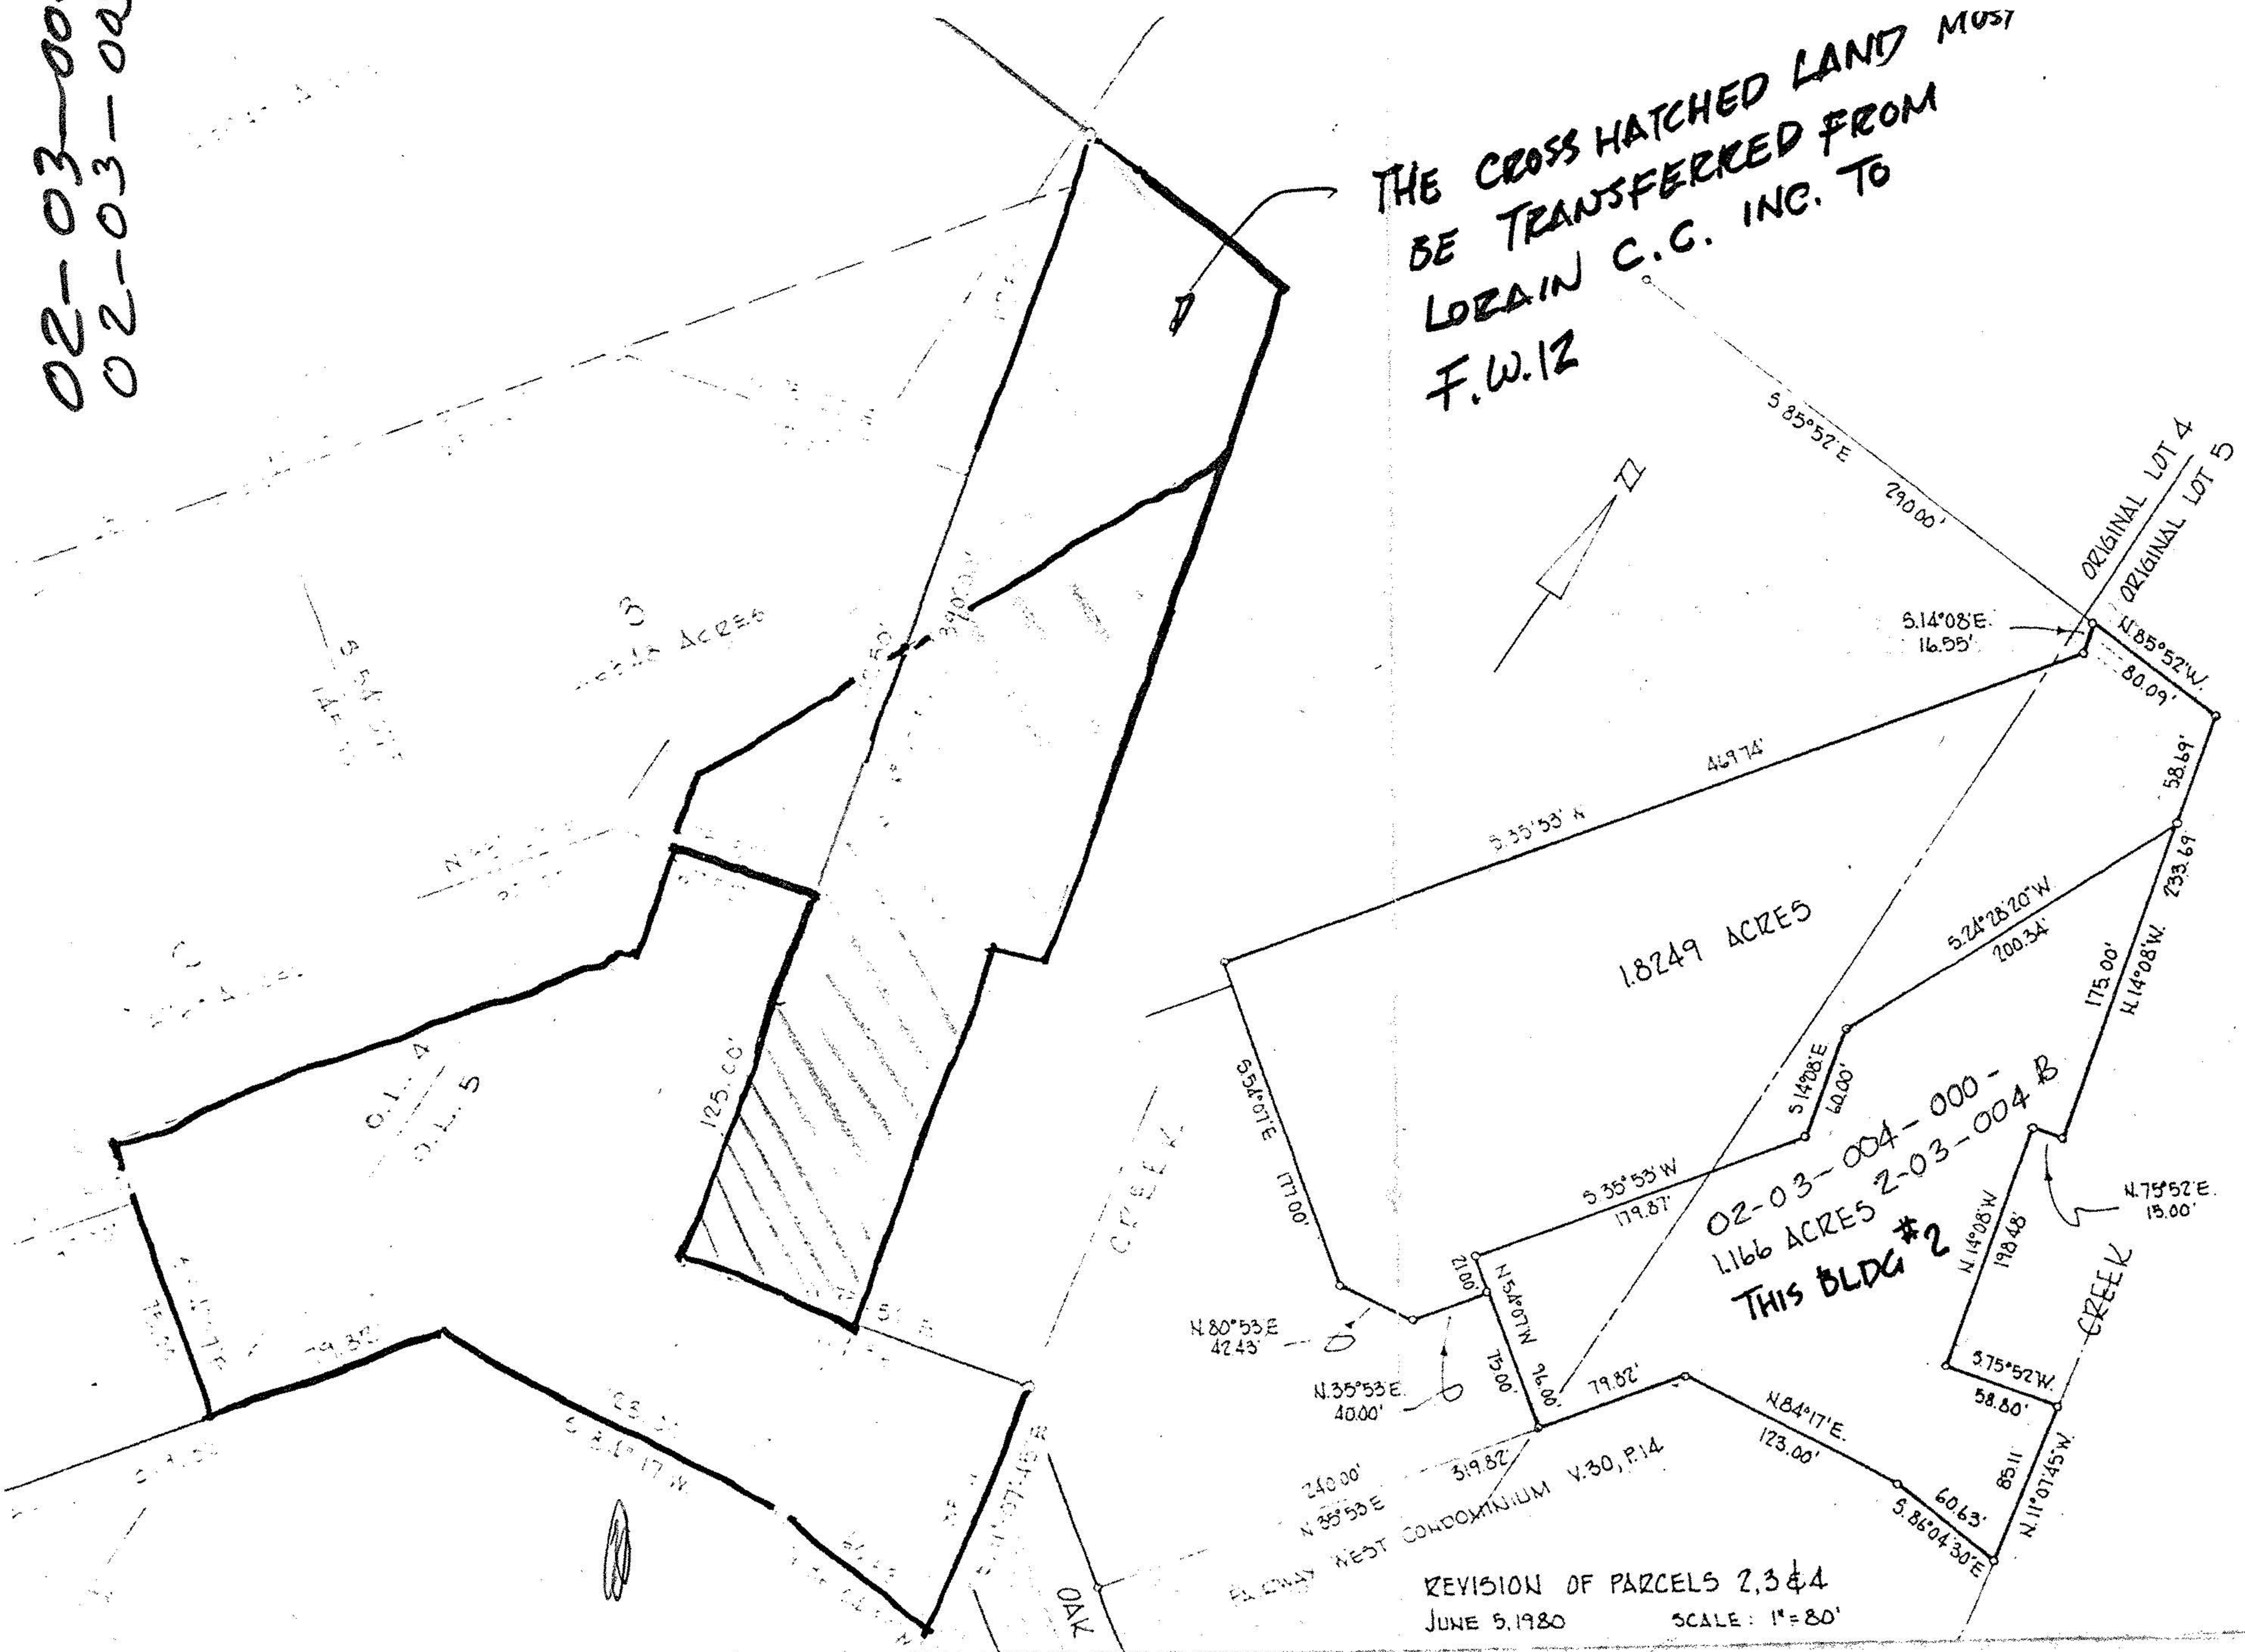

02-03-004
02-03-005

#13833

APPROVED
LORAIN CO.
MAP DEPT.
DATE 9-25-80
PAGE 02-03-004-B
BY <i>Quinn</i>
VOID AFTER 13833

5-A+B