



A-00-014-4 * 16513 04-00-014-103

WILLIAM B. BARTON
Reg. Land Surveyor No. 4438
188 PARKWOOD AVENUE
AVON LAKE, OHIO 44012
TELEPHONE (216) 933-6662

#16513
APPROVED,
LORAIN CO.
MAP DEPT.
DATE 12-27-85
PAGE 4.00.014-A
BY T. McMan
VOID:

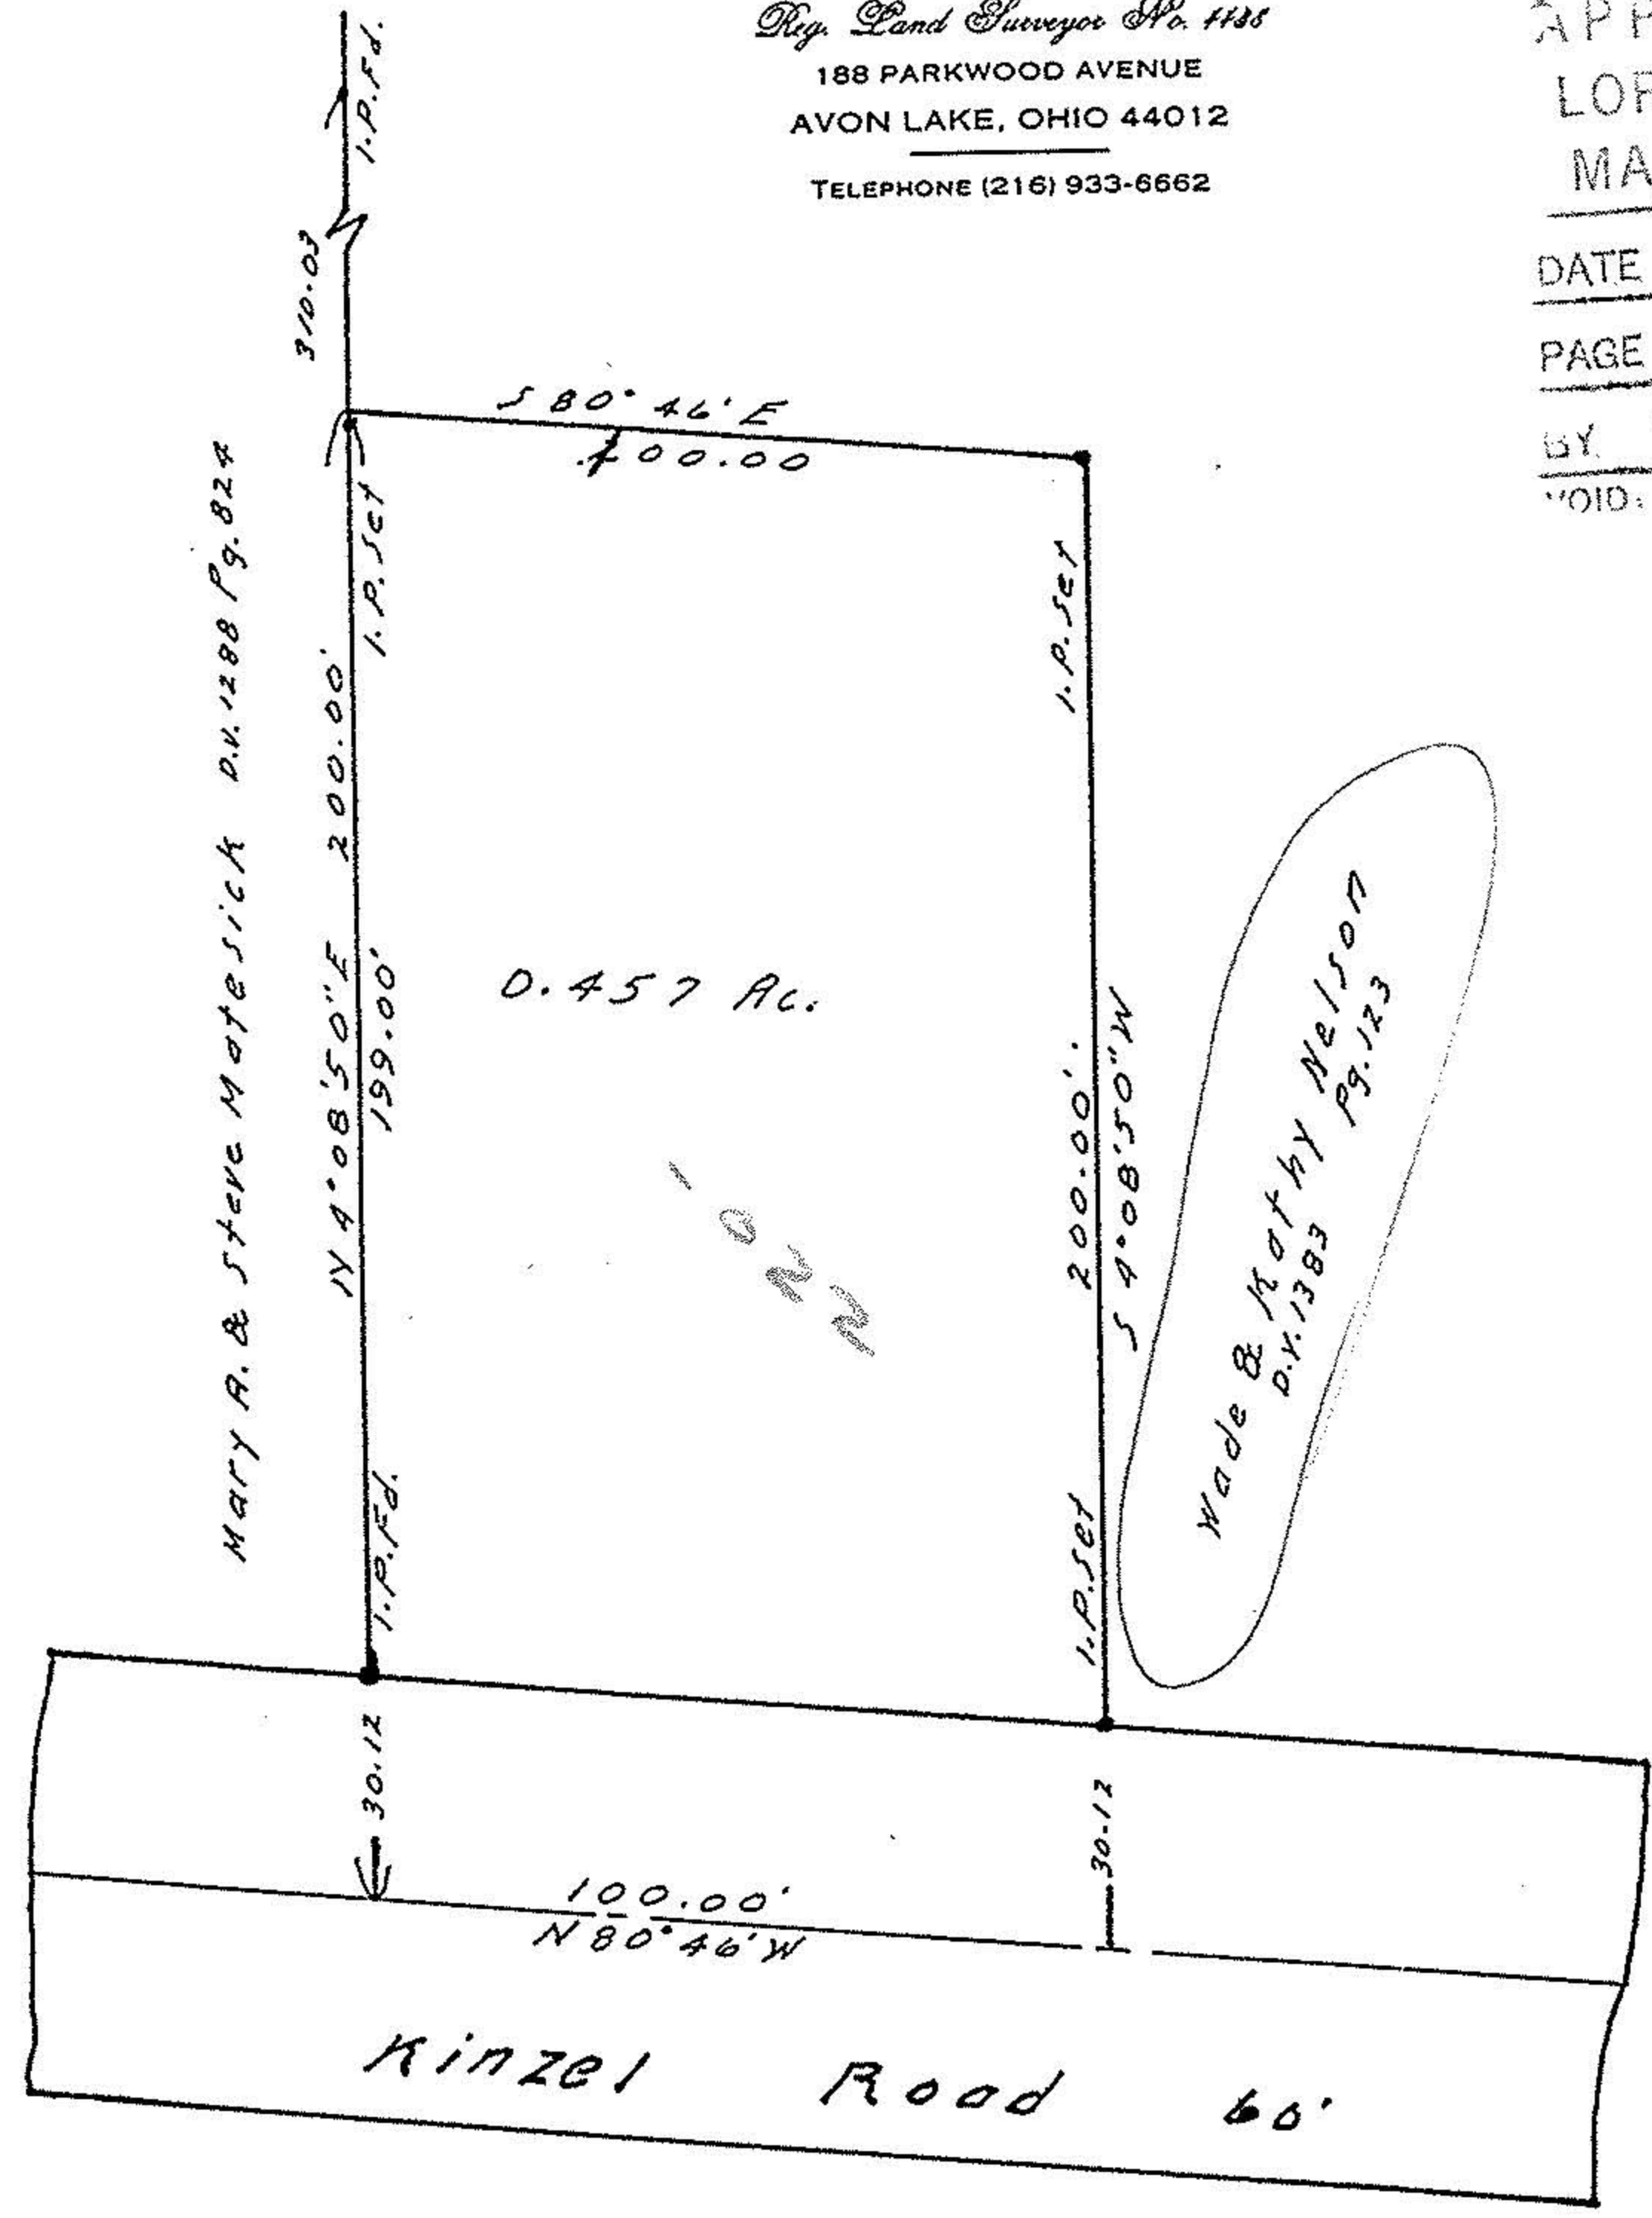


SURVEY
of
Part of Section No. 14, Avon Township,
now the city of Avon, Lorain County, Ohio.
Scale 1"=100'. December 10, 1985.

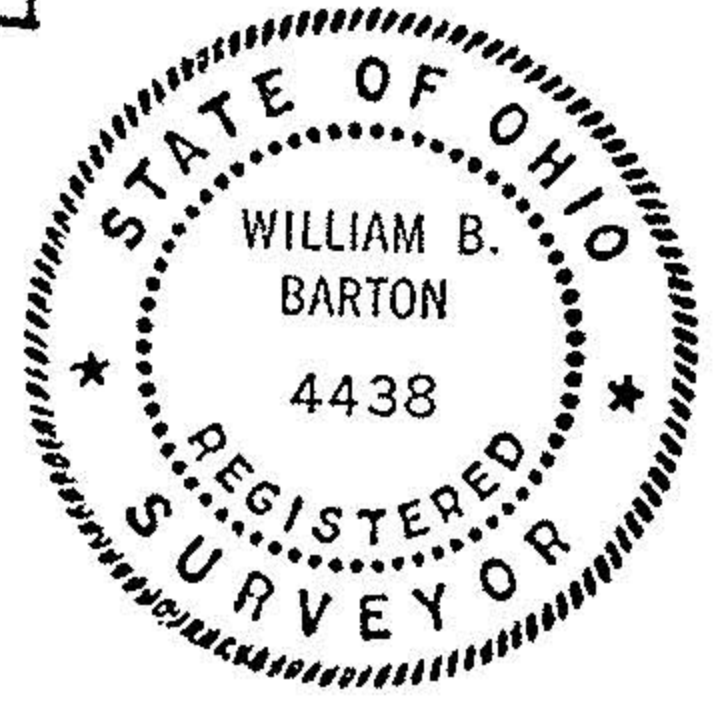

2-061

WILLIAM B. BARTON
Reg. Land Surveyor No. 4438
188 PARKWOOD AVENUE
AVON LAKE, OHIO 44012
TELEPHONE (216) 933-6662

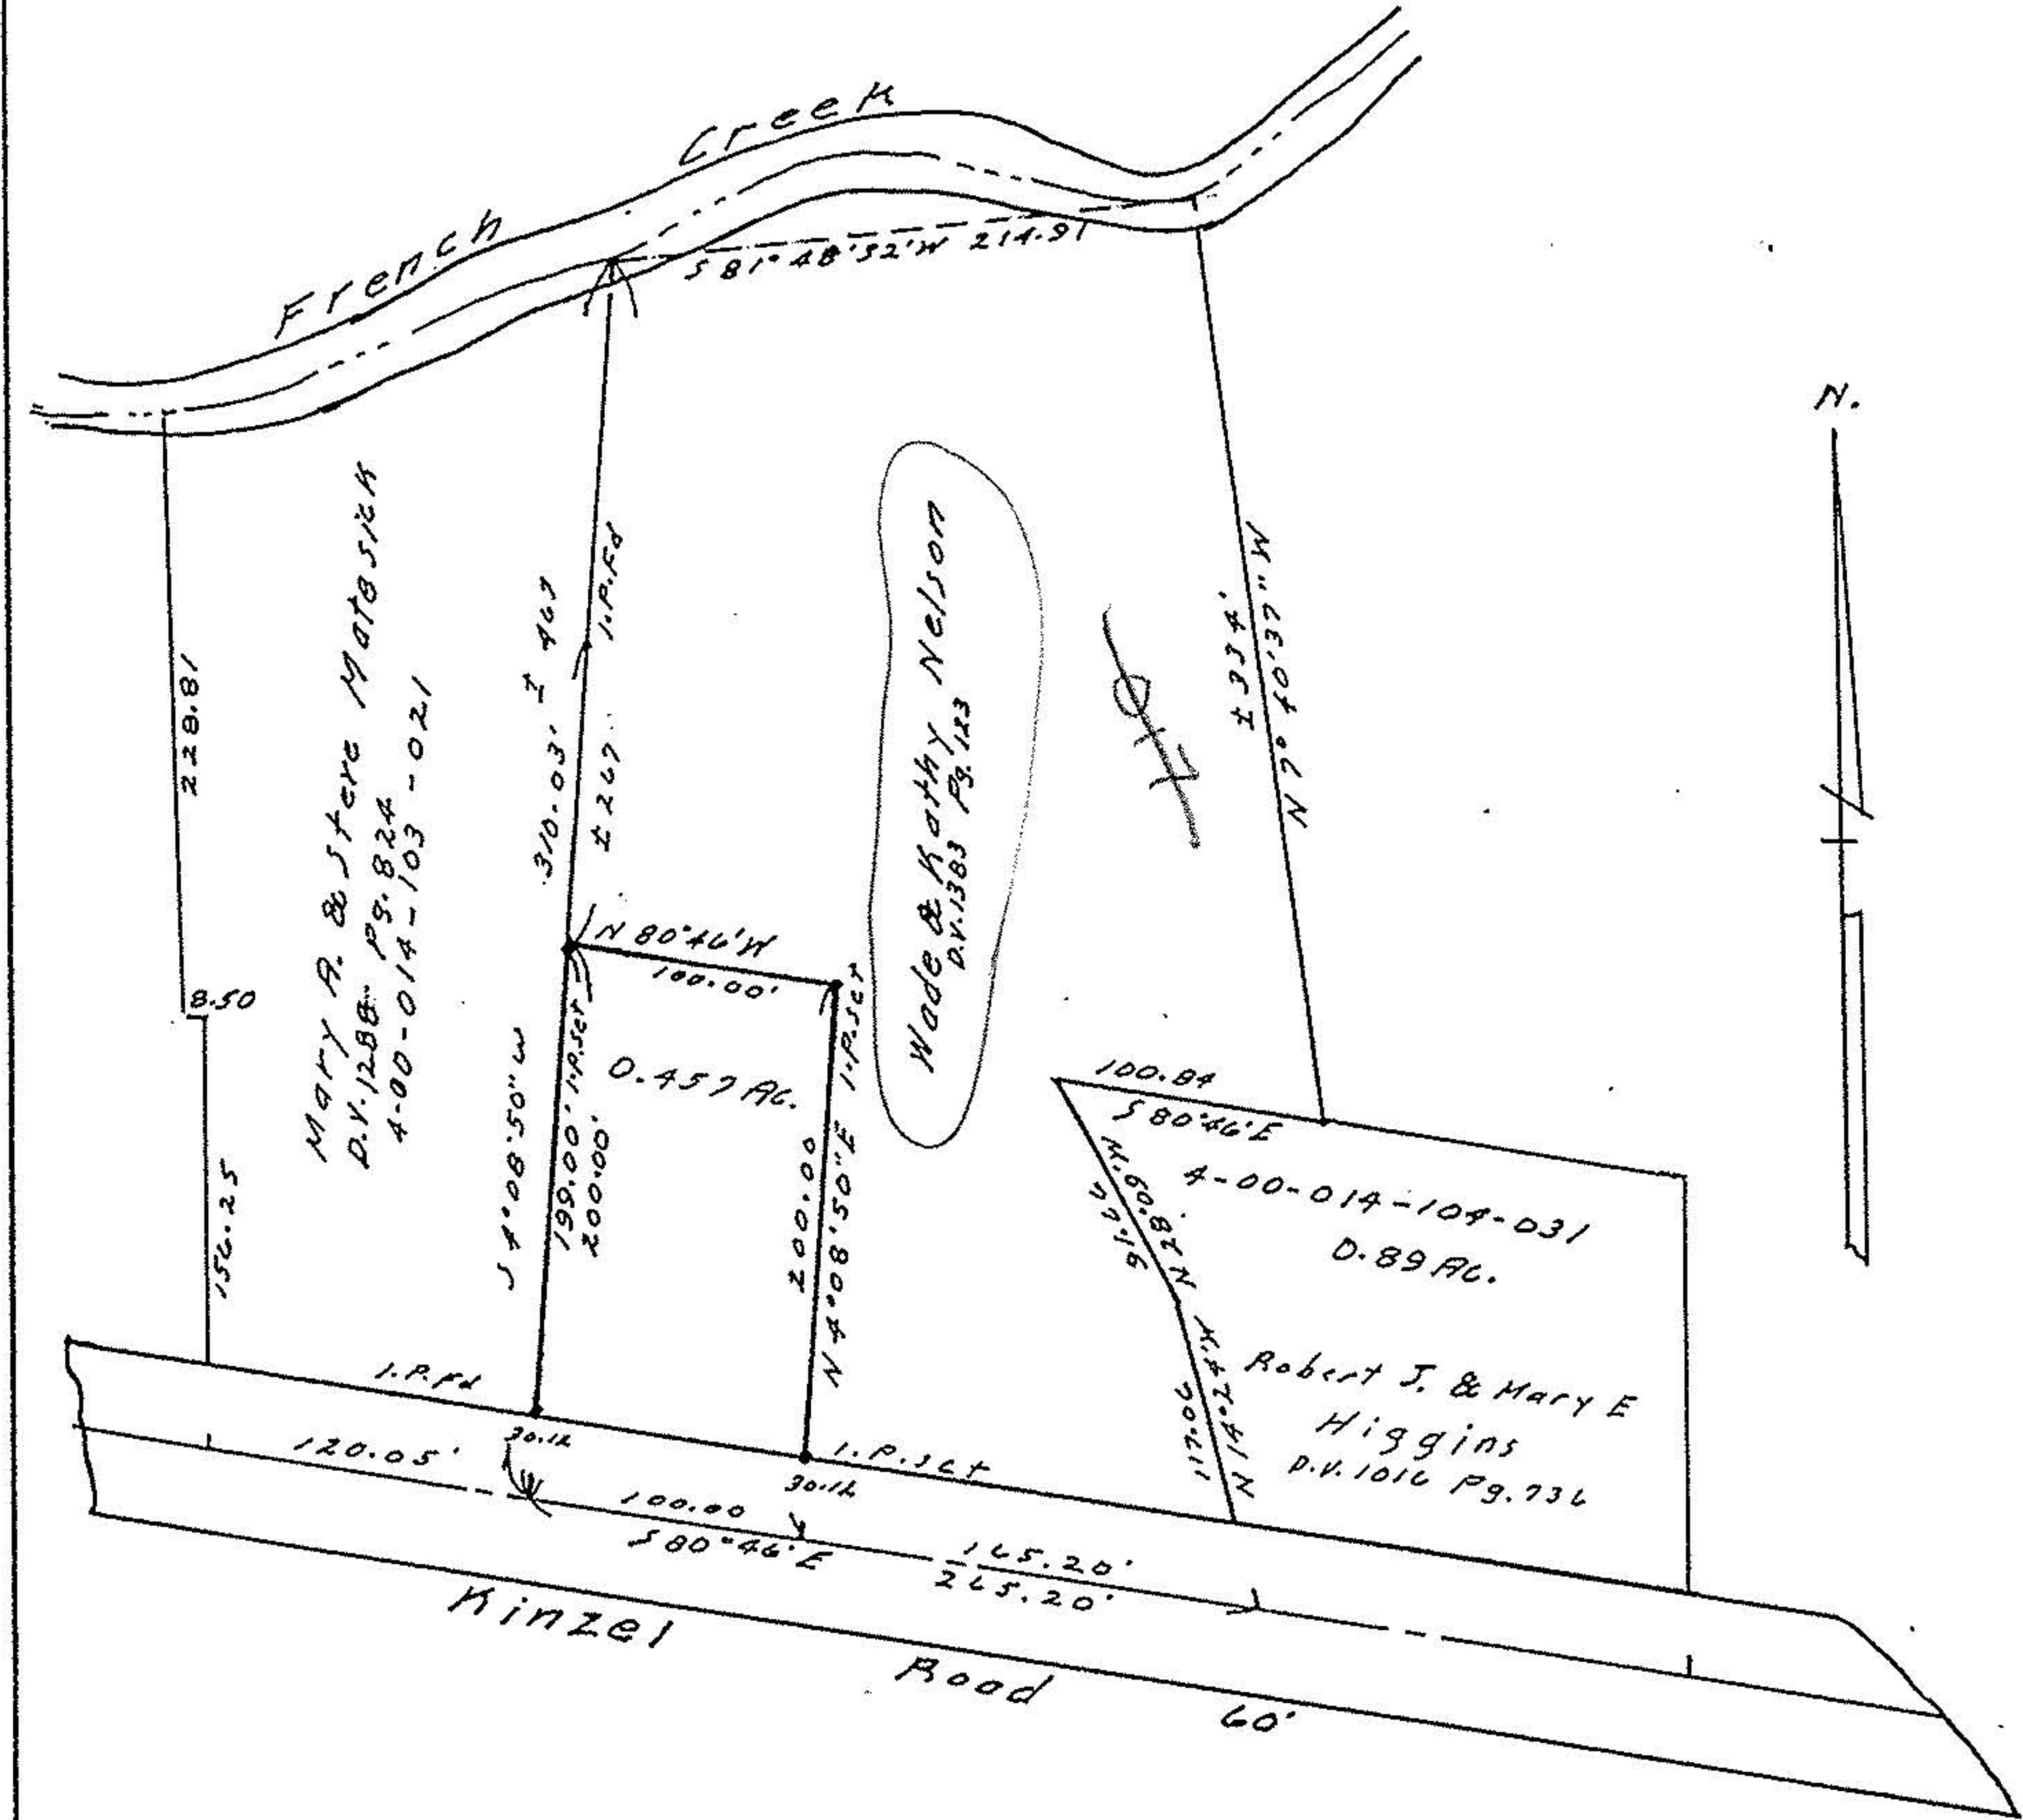

SURVEY
of
Part of Section No. 14 Avon Township
now the City of Avon, Lorain County Ohio.
Scale 1"=100'. November 23, 1985.
Revised-December 10, 1985



2-061