

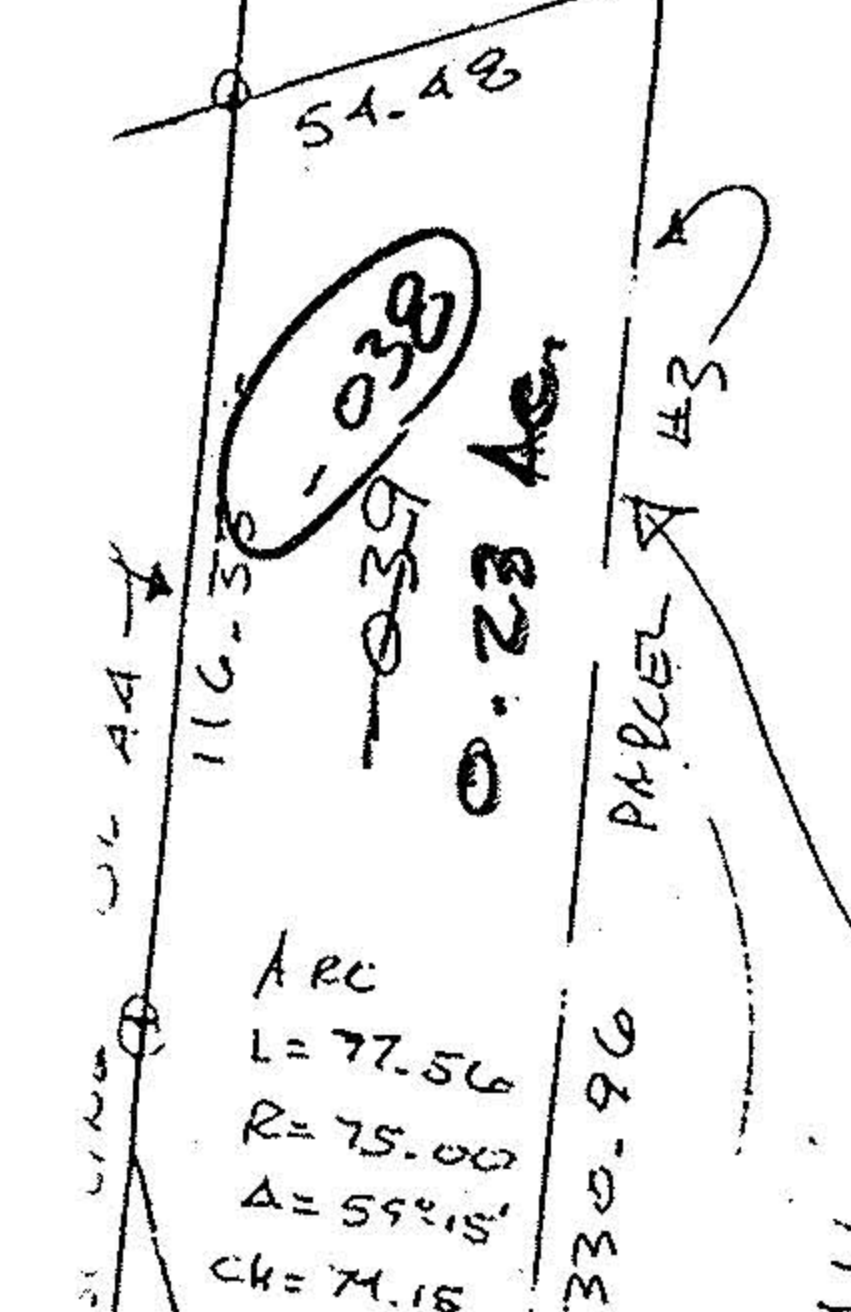


PER ABOVE CALL W/ D. ELMWELL
5/12/99 @ 3:20 HE WILL
SEND US NEW MAP W/ RECORDED/USED
DIMENSIONS & NOTIFY FRANK OF DEED REVISIONS
SEE OR 599, P. 195

SEE 4-00-015-B

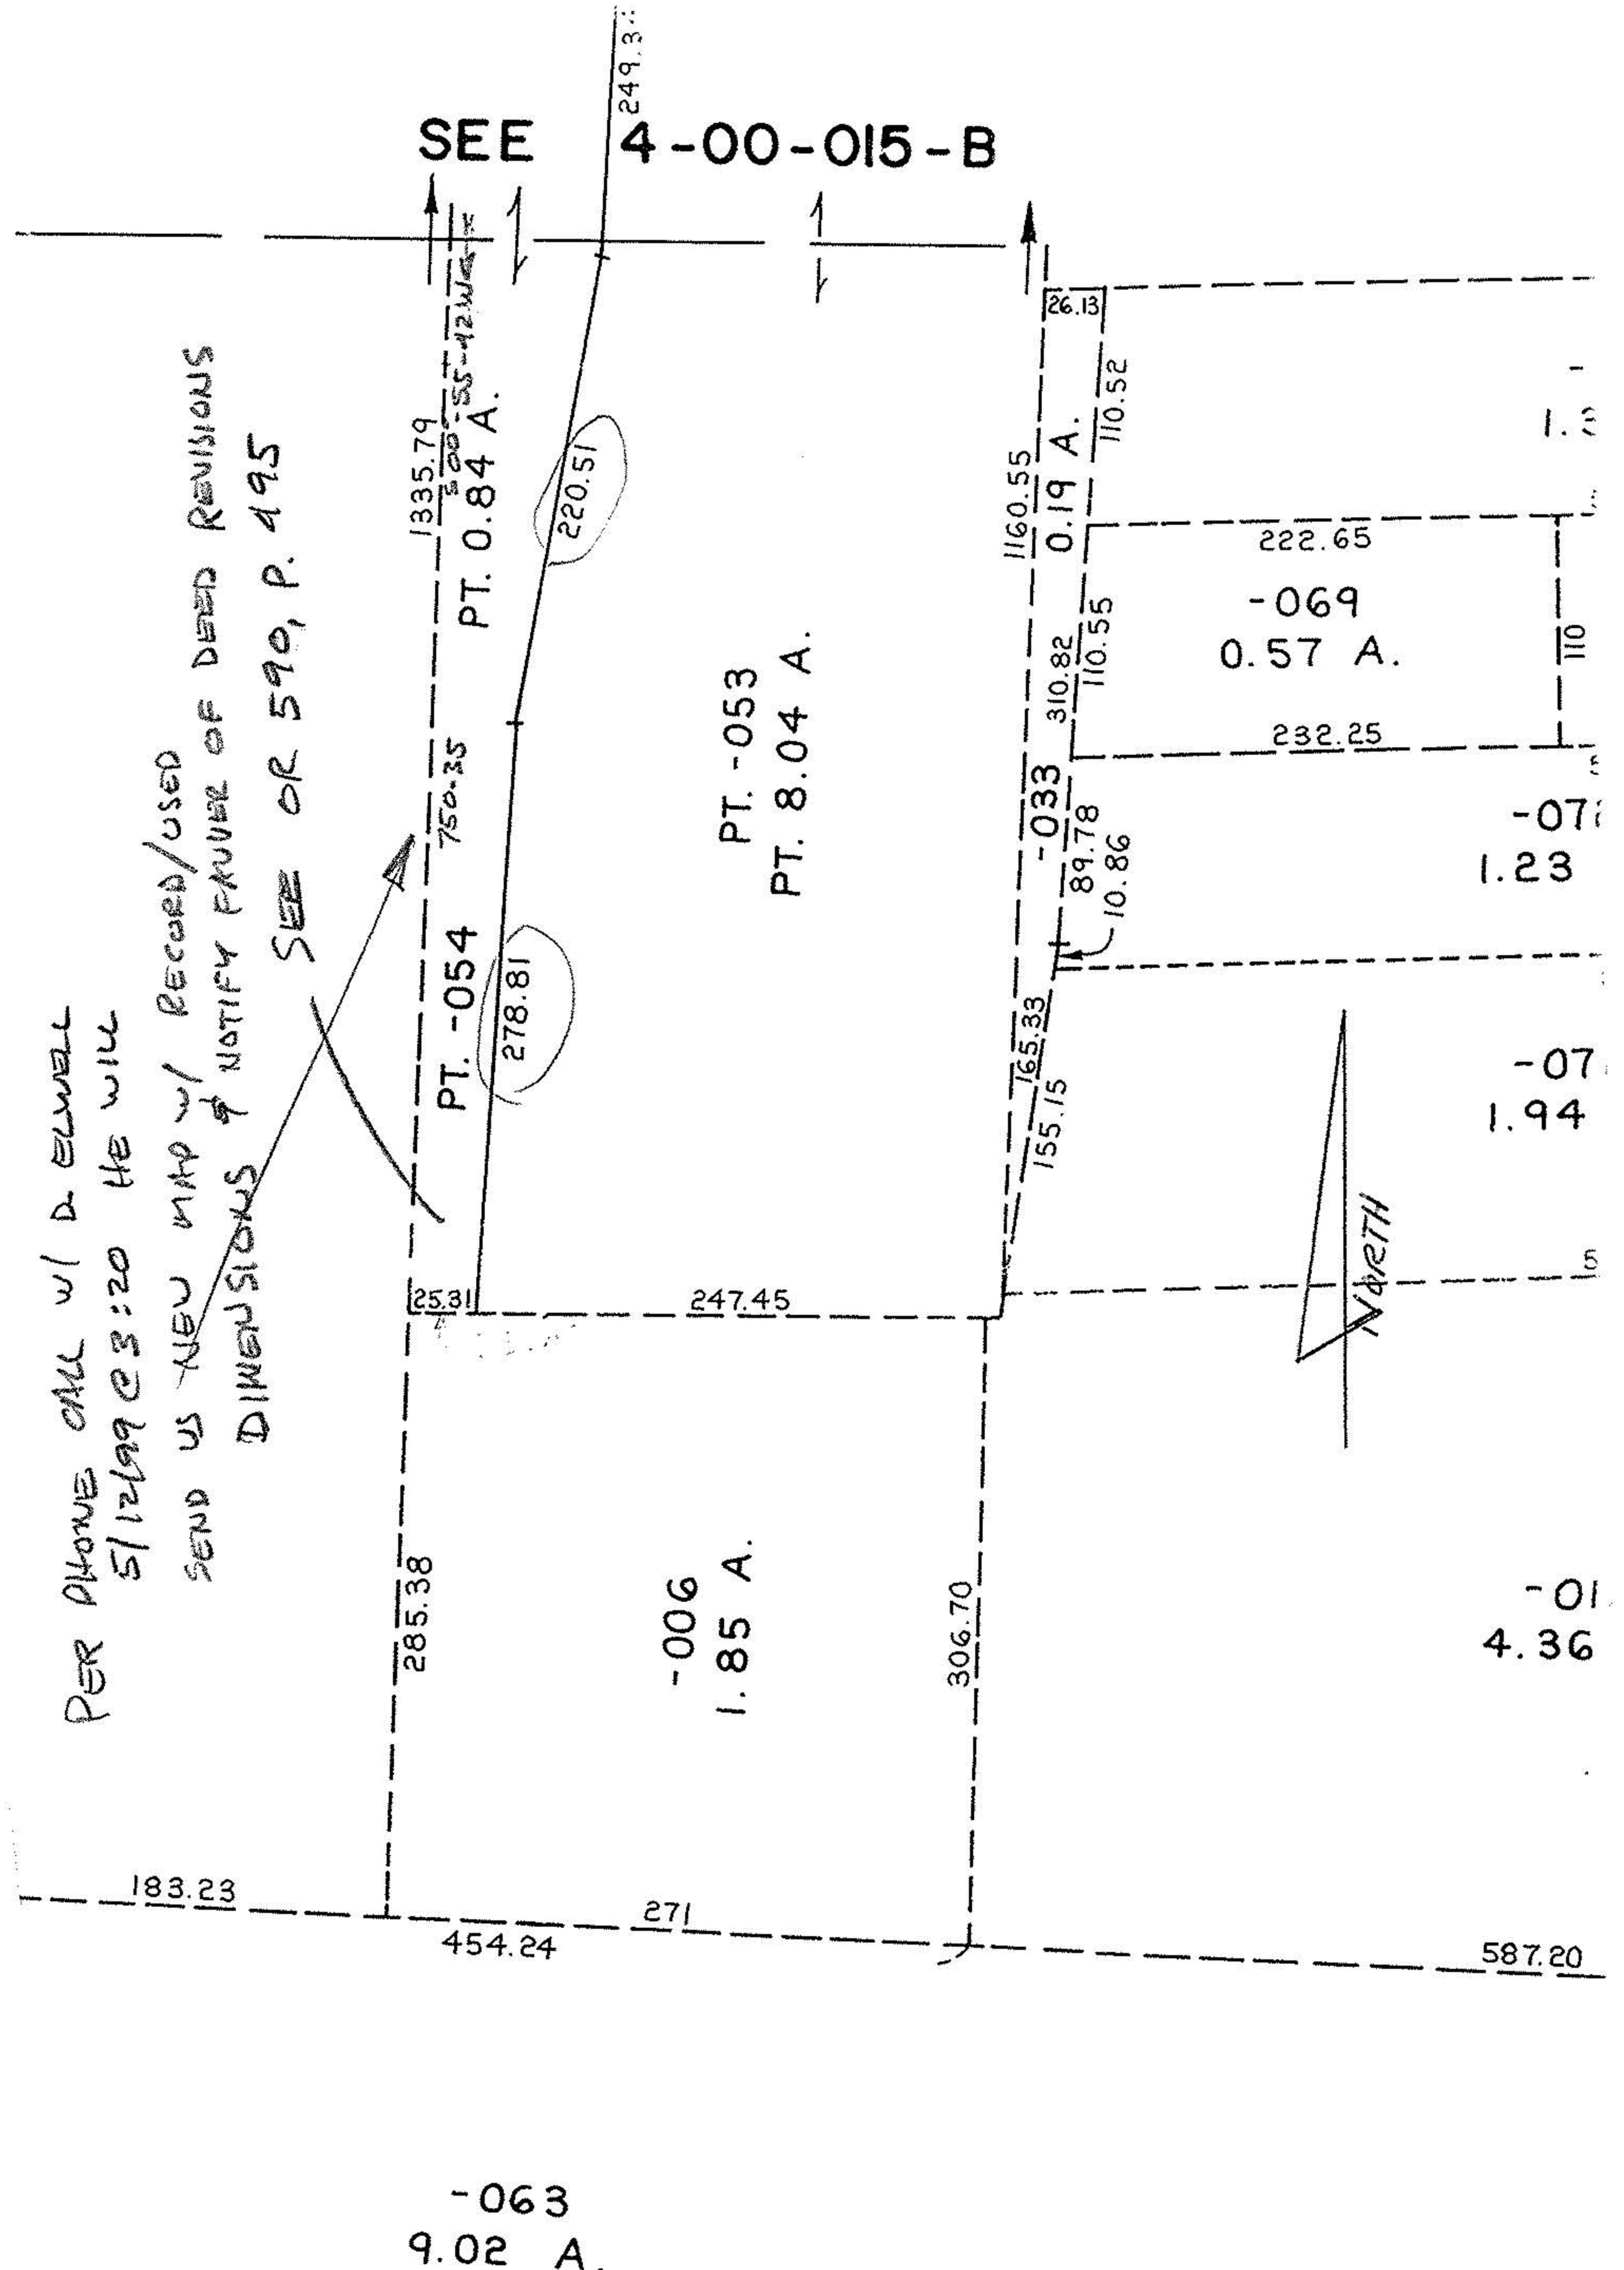


THIS NEEDS MAP CORRECTION

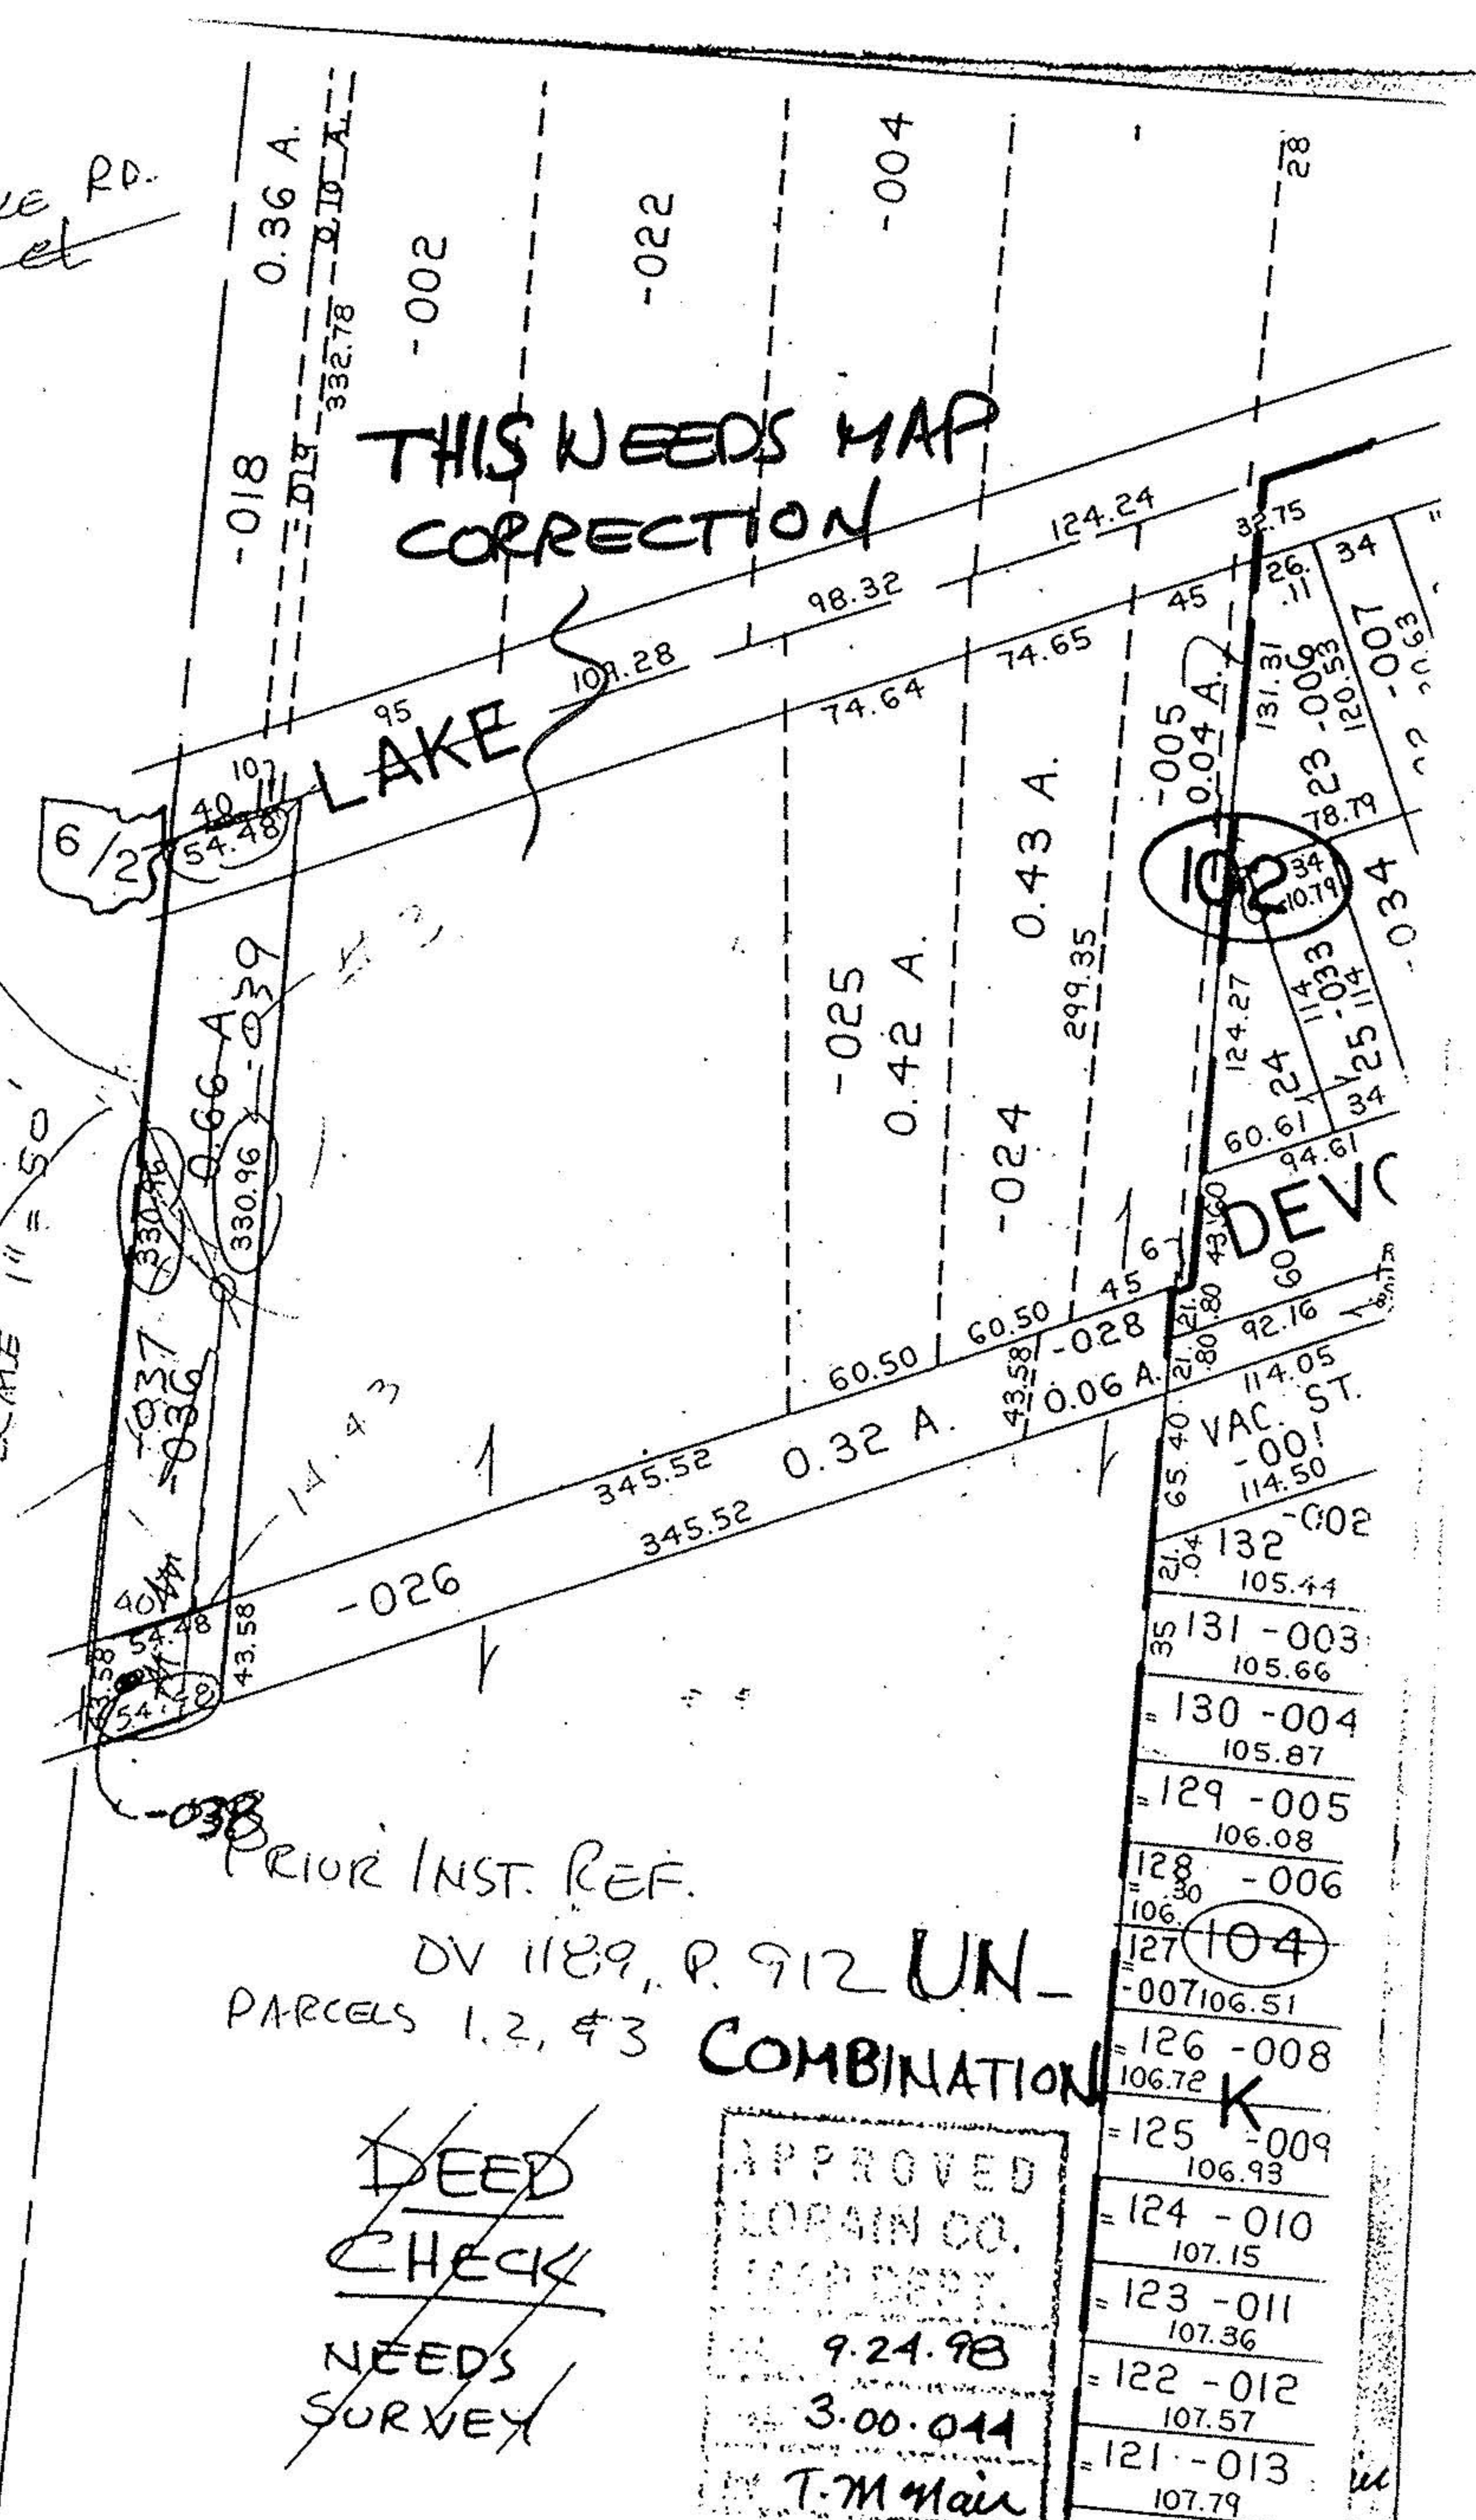

PRIOR INST. REF.
DV 1189, P. 912 UN-
PARCELS 1, 2, & 3 COMBINATION

~~DEED CHECK~~
NEEDS SURVEY

APPROVED
LORAIN CO.
MAP DEPT.
9-24-98
3-00-044
T.M. MAIR

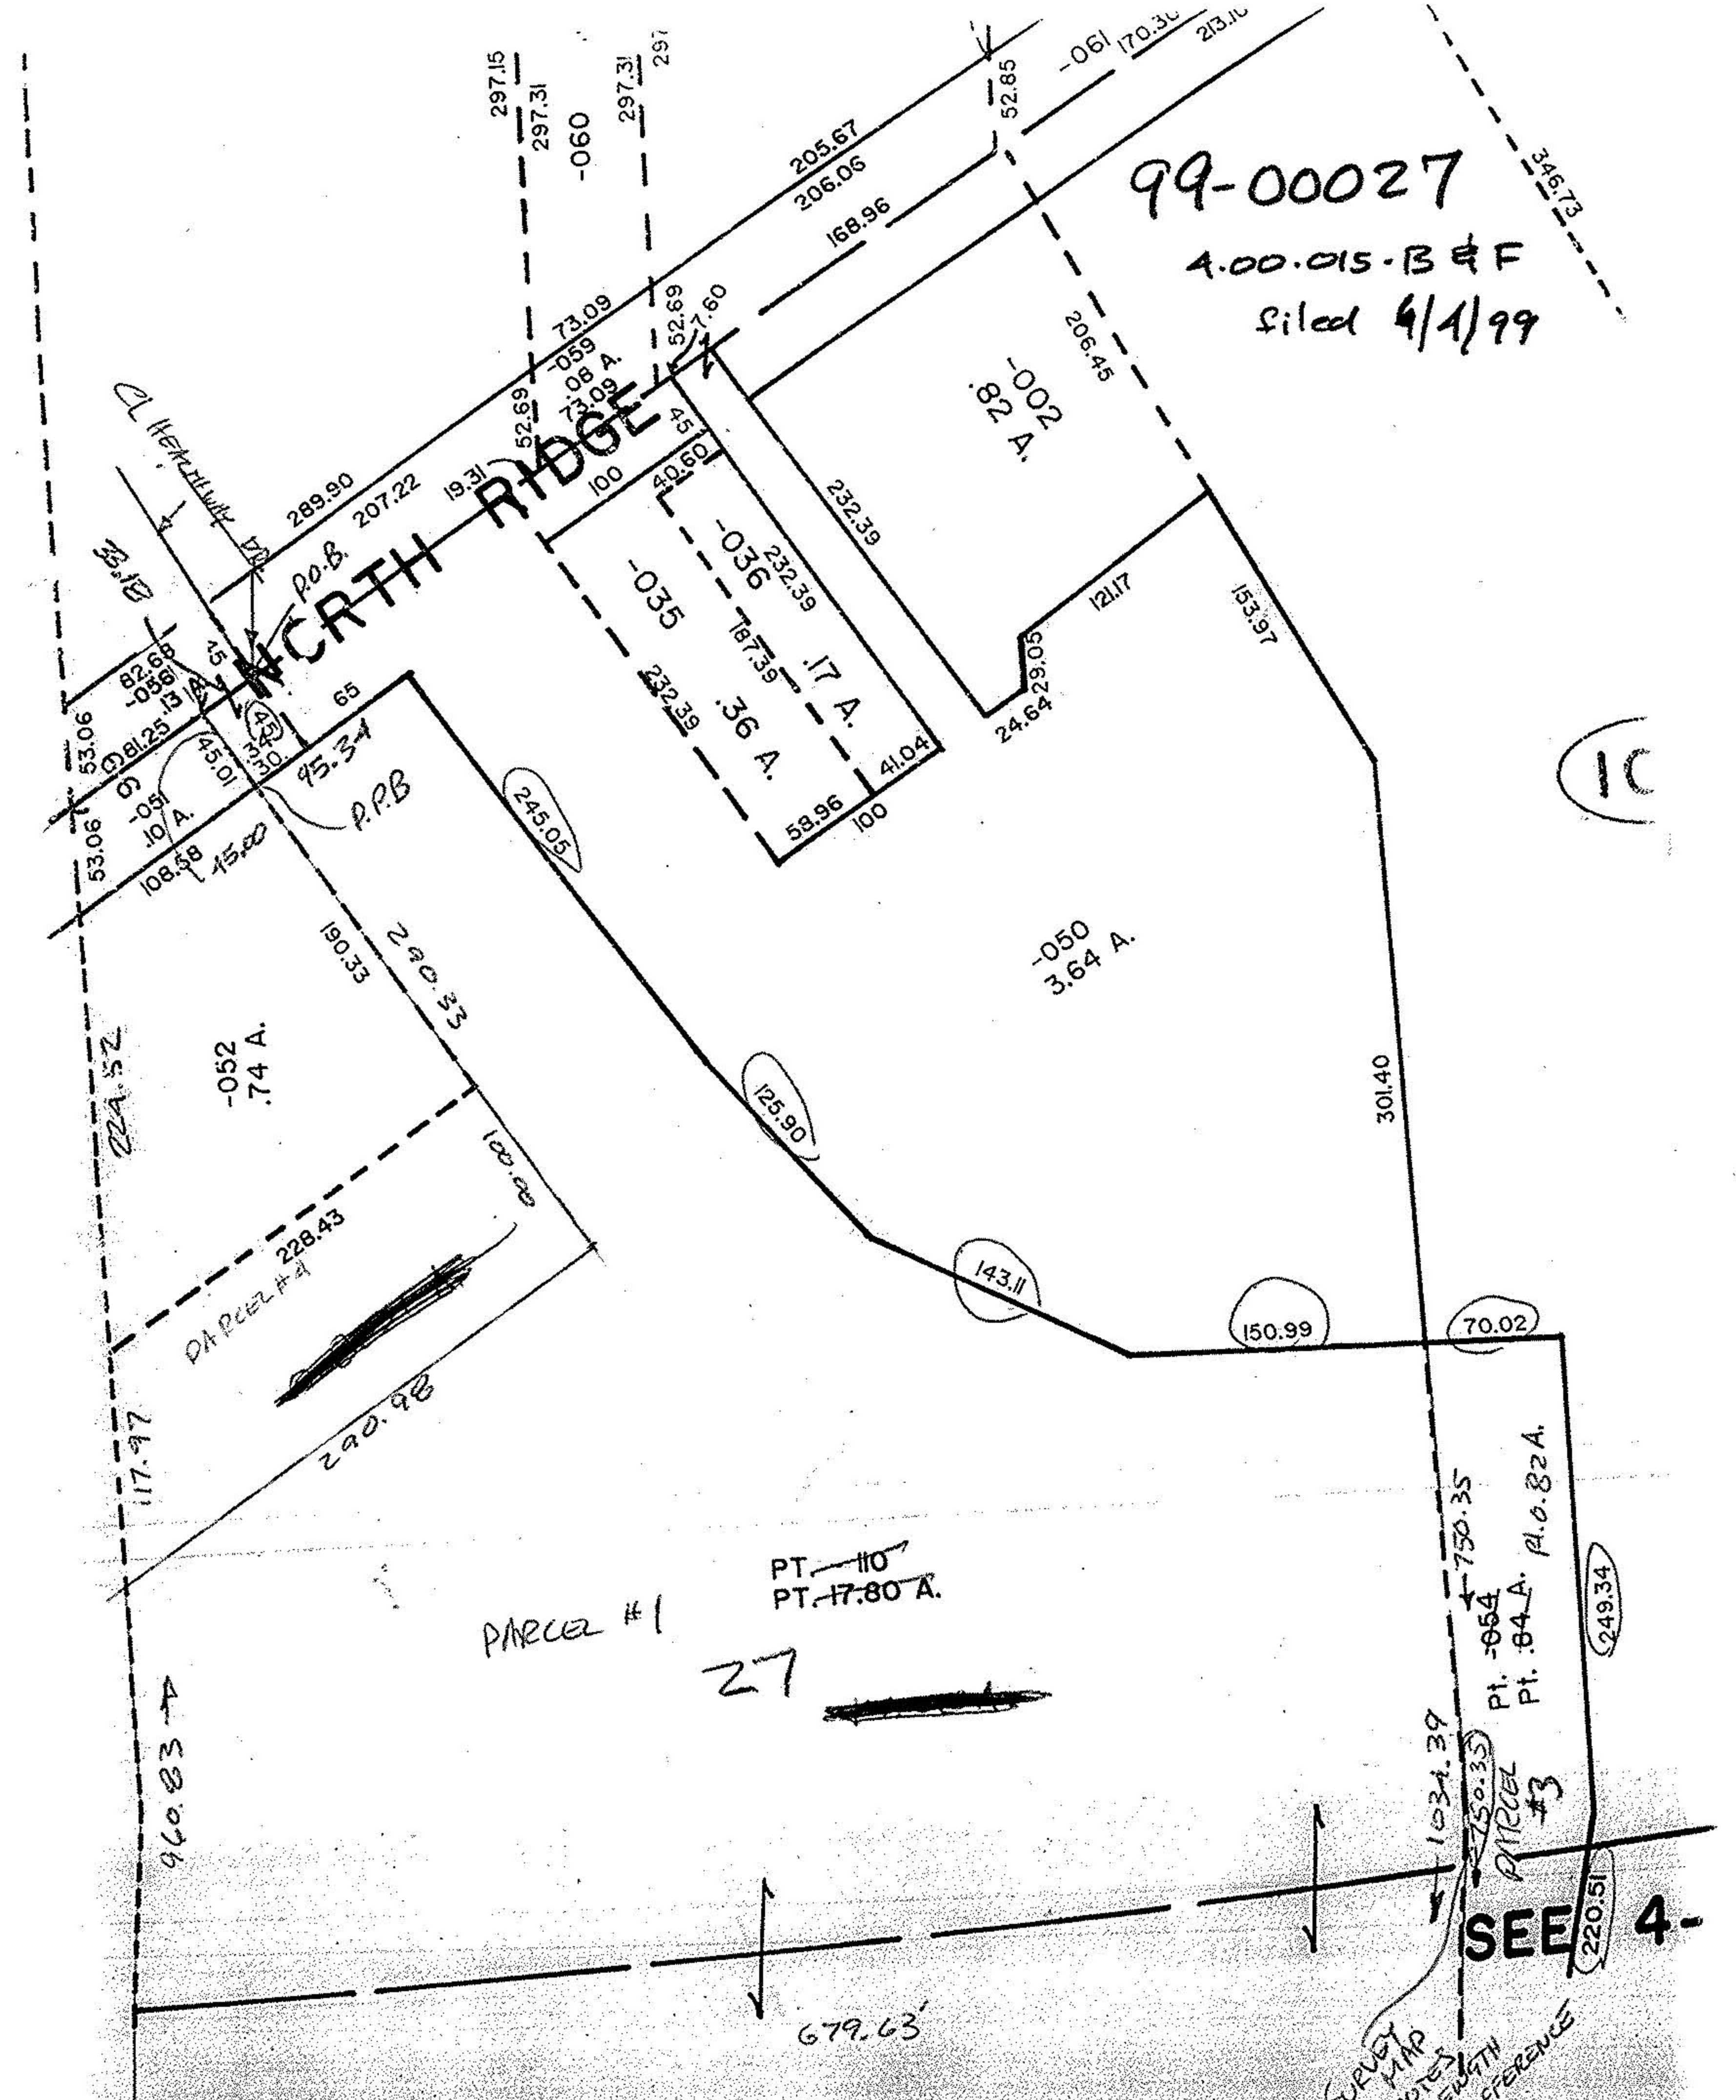

99-00027
A-00-015-B & F
filed 4/1/99

PARCEL #1
PT. 110
PT. 17.80 A.

SEE 4-
SURVEY MAP
WORTH
REFERENCE