


1-1/4" Pipe
Fd. 1.0' High
(Mushroomed)
Used For Line
0.14'S.

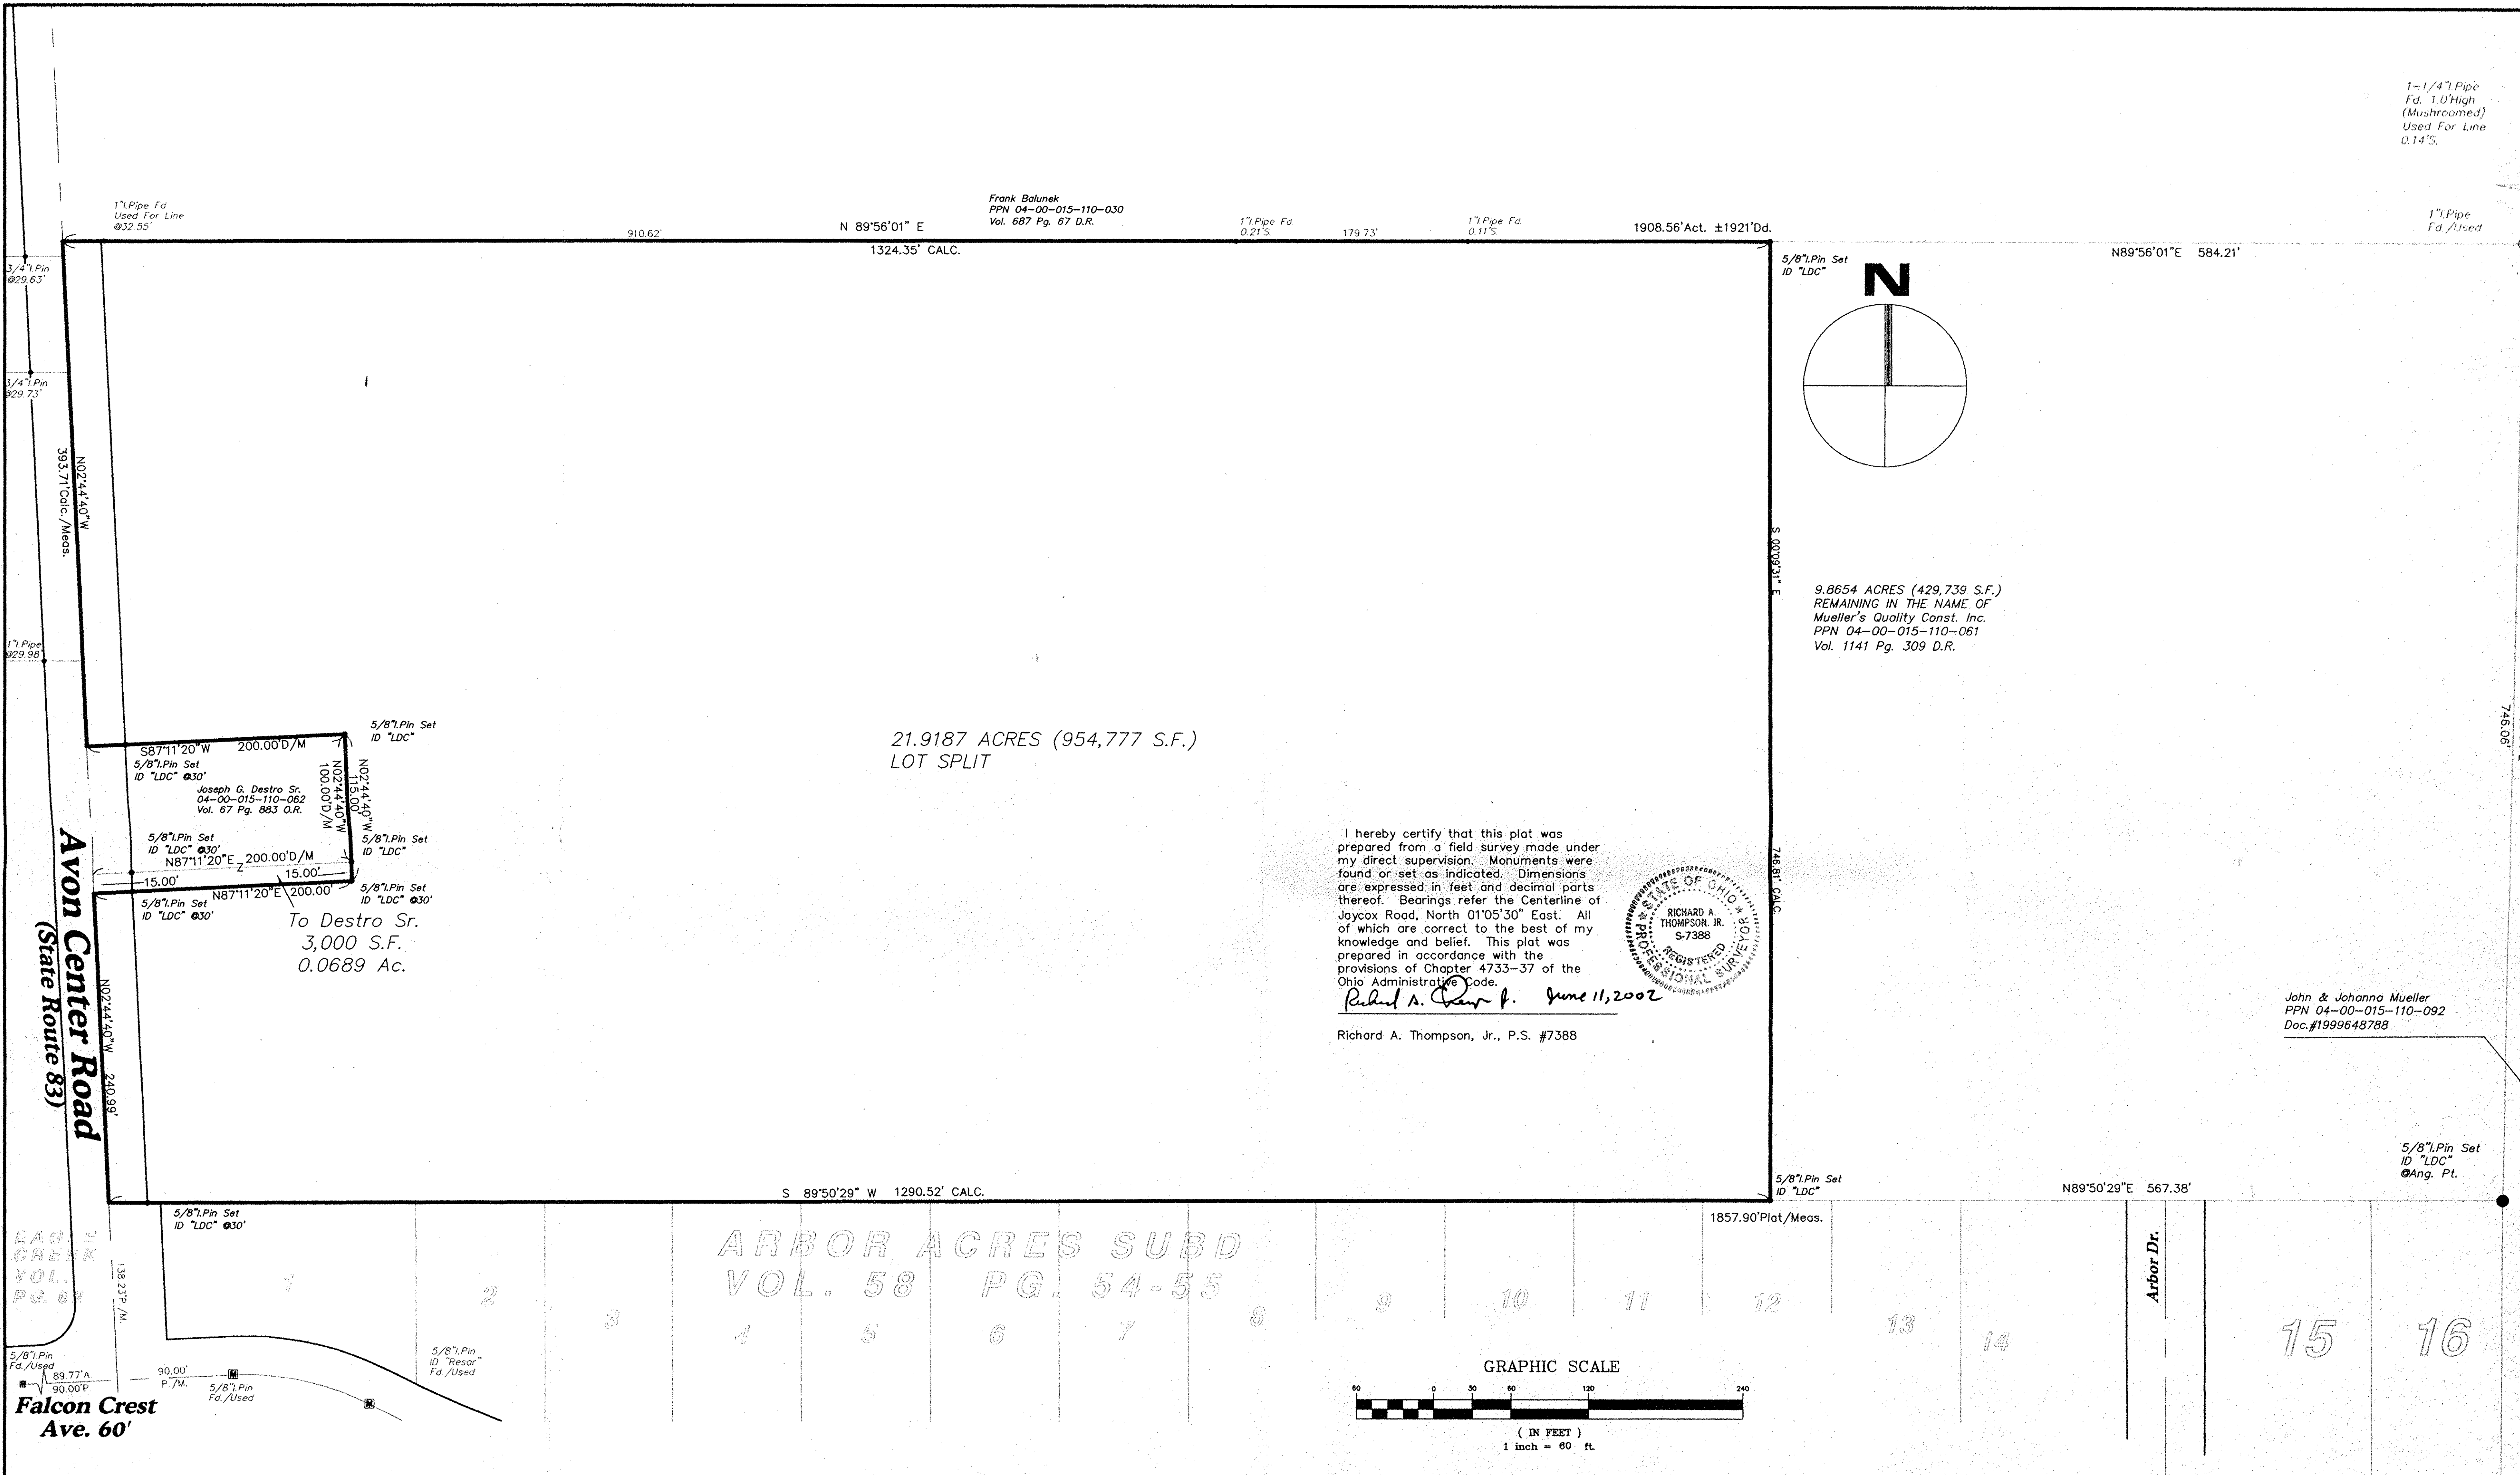

REV. No.	DATE	BY	CHK'D

LAND DESIGN consultants
www.LDCinc.net
ENGINEERS · PLANNERS · SURVEYORS

8335 East Avenue Mentor, Ohio 44060
TEL: (440) 255-8463 (440) 931-LAND
(440) 334-6938 FAX: (440) 255-9575

1471 Lear Industrial Park Avon, Ohio 44011
TEL: (440) 937-5601 (440) 937-5602
FAX: (440) 937-5603

PLAT OF LOT SPLIT
PREPARED FOR PULTE HOMES
CITY OF AVON - LORAIN COUNTY - OHIO

DATE JUNE 10th, 2002
SCALE: HOR. 1" = 60'
VERT. _____
FILENAME 4-24-02LOTSPLIT
COMPUTER MPS
FIELD CREW _____

PART OF ORIGINAL AVON TOWNSHIP
SECTION NO. 15

SHEET 1 OF 1
CONTRACT No. _____
PULTH1-0104