



LAUNDON . SIMON . CAHL & ASSOC. INC.
CONSULTING ENGINEERS & SURVEYORS
219 COURT ST. ELYRIA, OHIO 44035


SURVEY FOR:

DAVID TURNER

Orig. Lot	City of AVON	Date 12-18-'85 Scale 1"=50'
Orig. Sec. 16	Village of	Dwn. by R.G.S. Chkd. by B.P.
Tract	County of LORAIN	Job No. 85-1448 F.B. 216/61
Township of AVON	State of OHIO	Printed

CHESTER RD. 60'

N. 89° 43' 26" W.

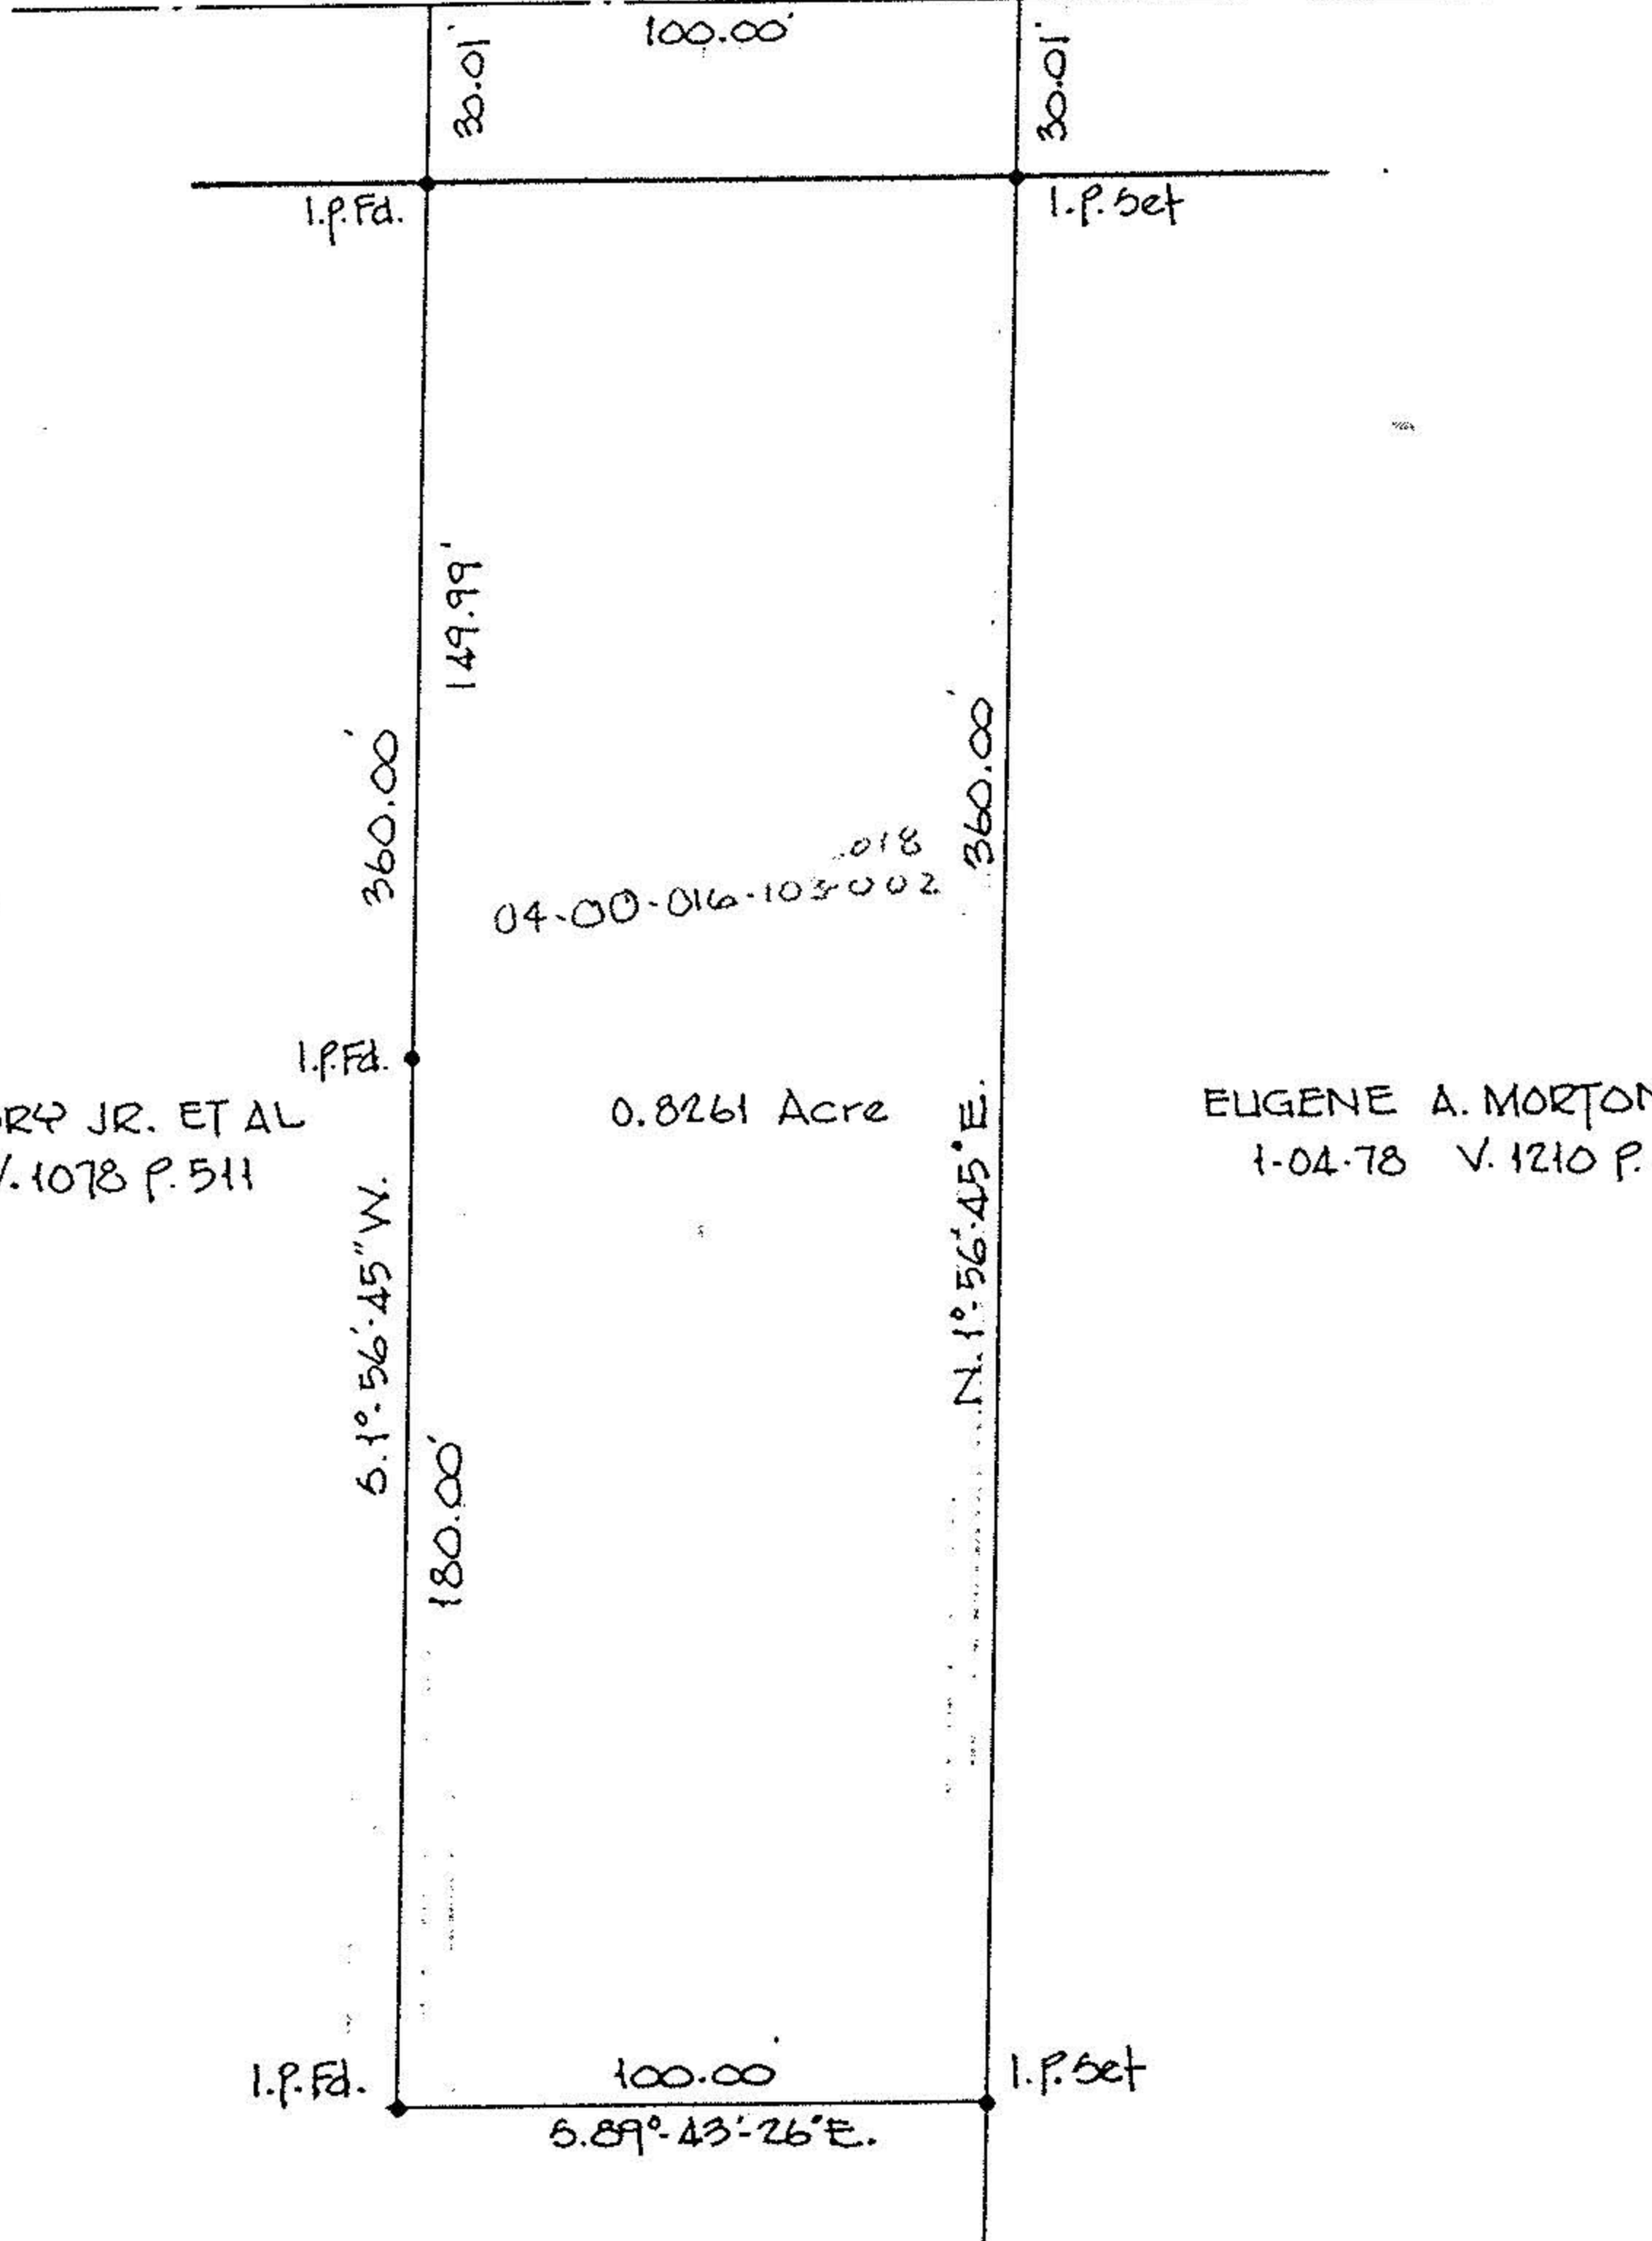

CHAS. P. CORY JR. ET AL
4-23-73 V. 1078 P. 511

0.8261 Acre

EUGENE A. MORTON ET AL
1-04-78 V. 1210 P. 878