



I.P. USED

4-00-016-E

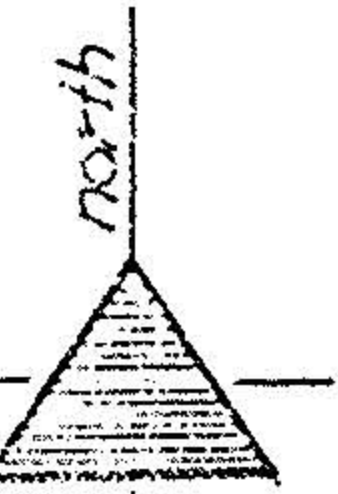

4

Sec. 16
04-00-016-101

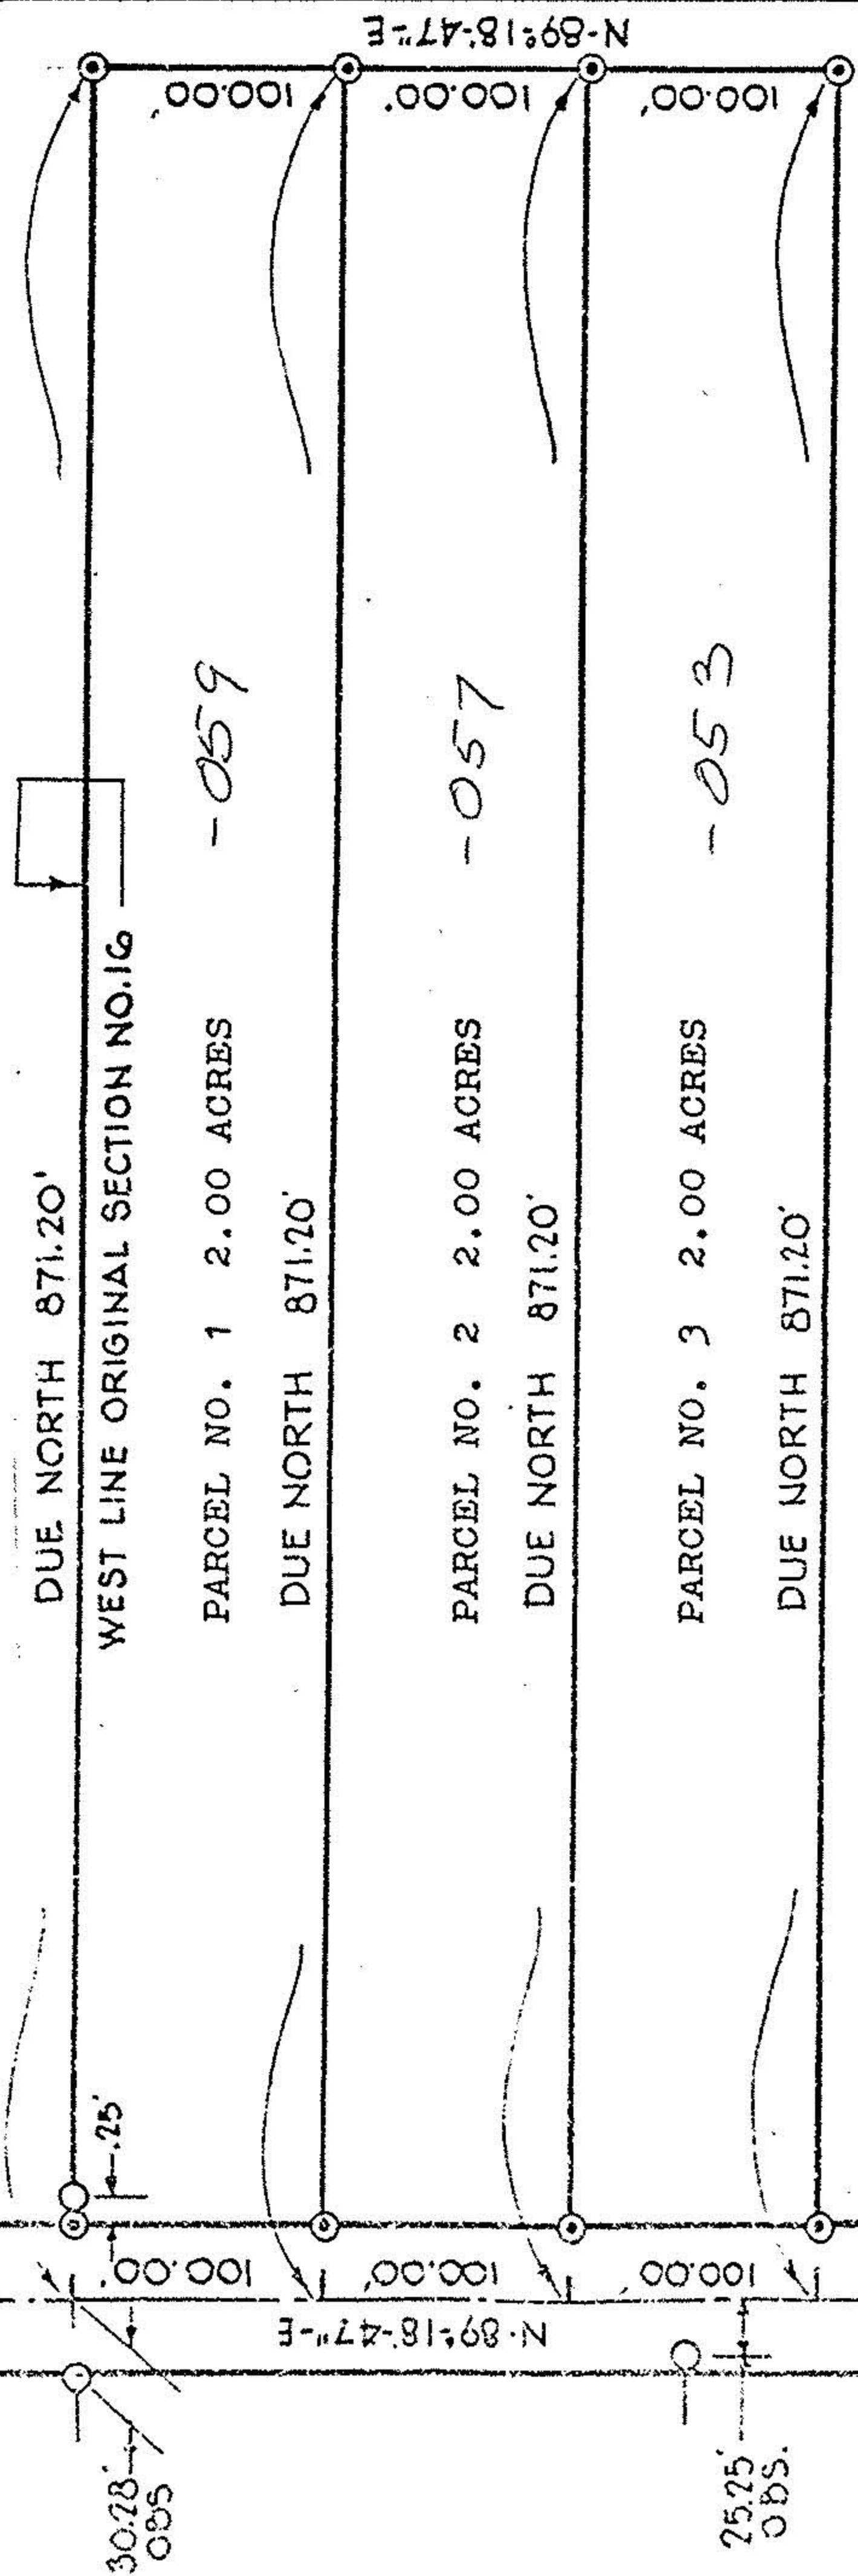

- IRON PIN FOUND
- IRON PIN SET

SURVEY OF PART OF ORIGINAL SECTION NO. 16
 AVON TOWNSHIP, NOW WITHIN THE CORPORATE
 LIMITS OF THE CITY OF AVON
 LORAIN COUNTY, OHIO
 SCALE 1"=100

JULY 10, 1975

NORMAN R. HURA, Registered surveyor

9064

powdermaker Rd,