


KLEINOEDER-SCHMIDT
and **ASSOCIATES**
ENGINEERS — SURVEYORS — CONSULTANTS IN LAND PLANNING
ELYRIA - NORWALK - MEDINA OHIO


SURVEY

Sublot(s) _____
Subd'n _____

Township AVON Tract _____
Orig. Lot(s) _____ Sec. 17
County of LORAIN State of Ohio
Corporation CITY OF AVON LAKE

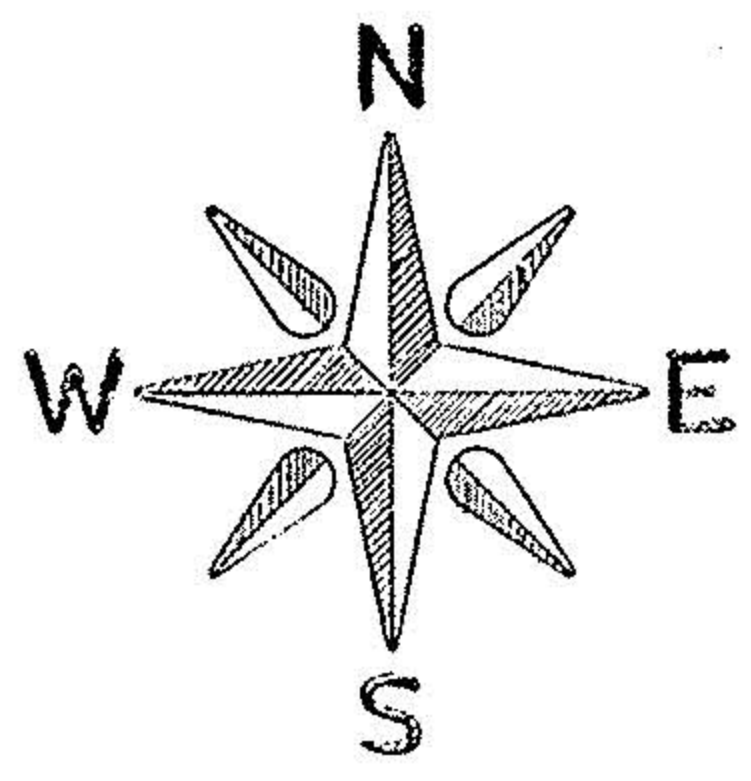


NOTE: BEARINGS SHOWN ARE ASSUMED AND ARE FOR DESCRIBING ANGLES ONLY.

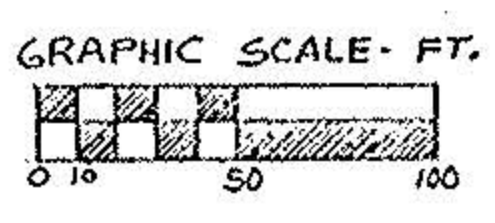

04-00-017-102-
16588
A-00-017-B
A

102

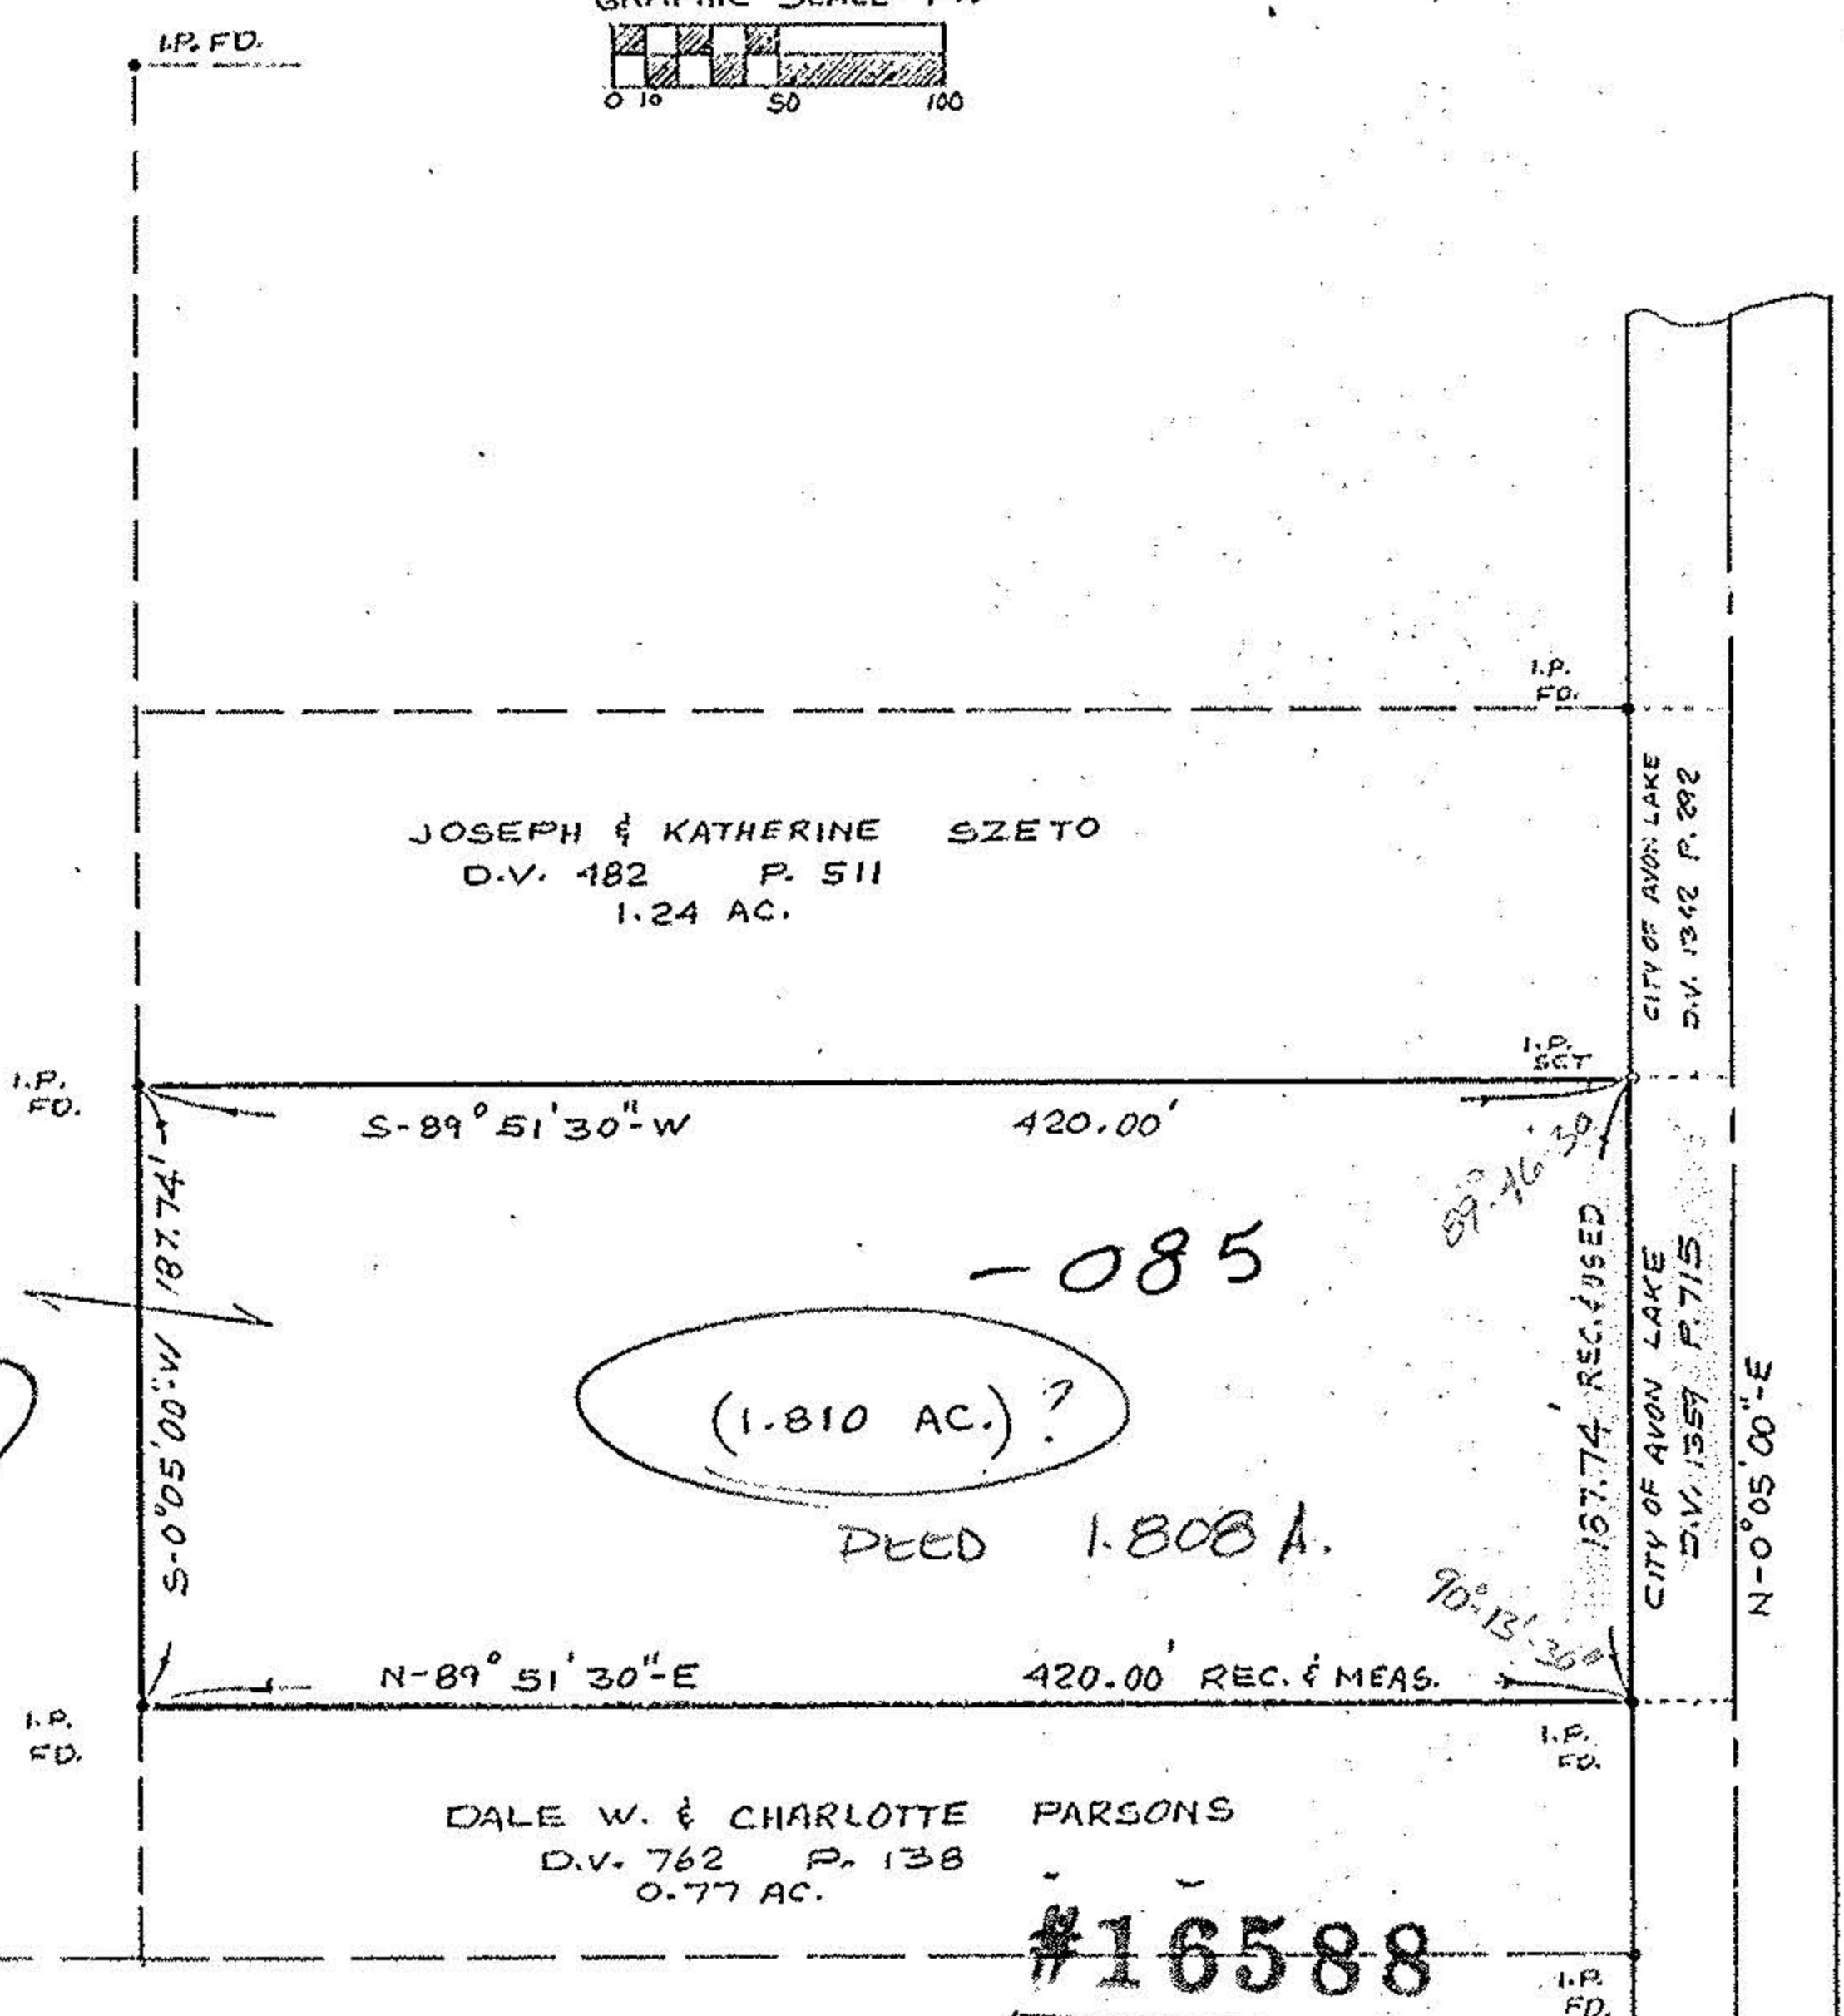

#16588

APPROVED
LORAIN CO.
MAP DEPT.
DATE 2-12-86
PAGE A-00-017-A & B
BY T. McMain
VOID AFTER _____

Prepared for: FOREST CITY ENTERPRISES

MAP REVISED 2-10-86