


04-00-017-102-4

Sec. 17

RECORD DRAWING OF
PART OF SECTION 17
AVON TOWNSHIP

LORAIN COUNTY STATE OF OHIO

SCALE: 1" = 100'

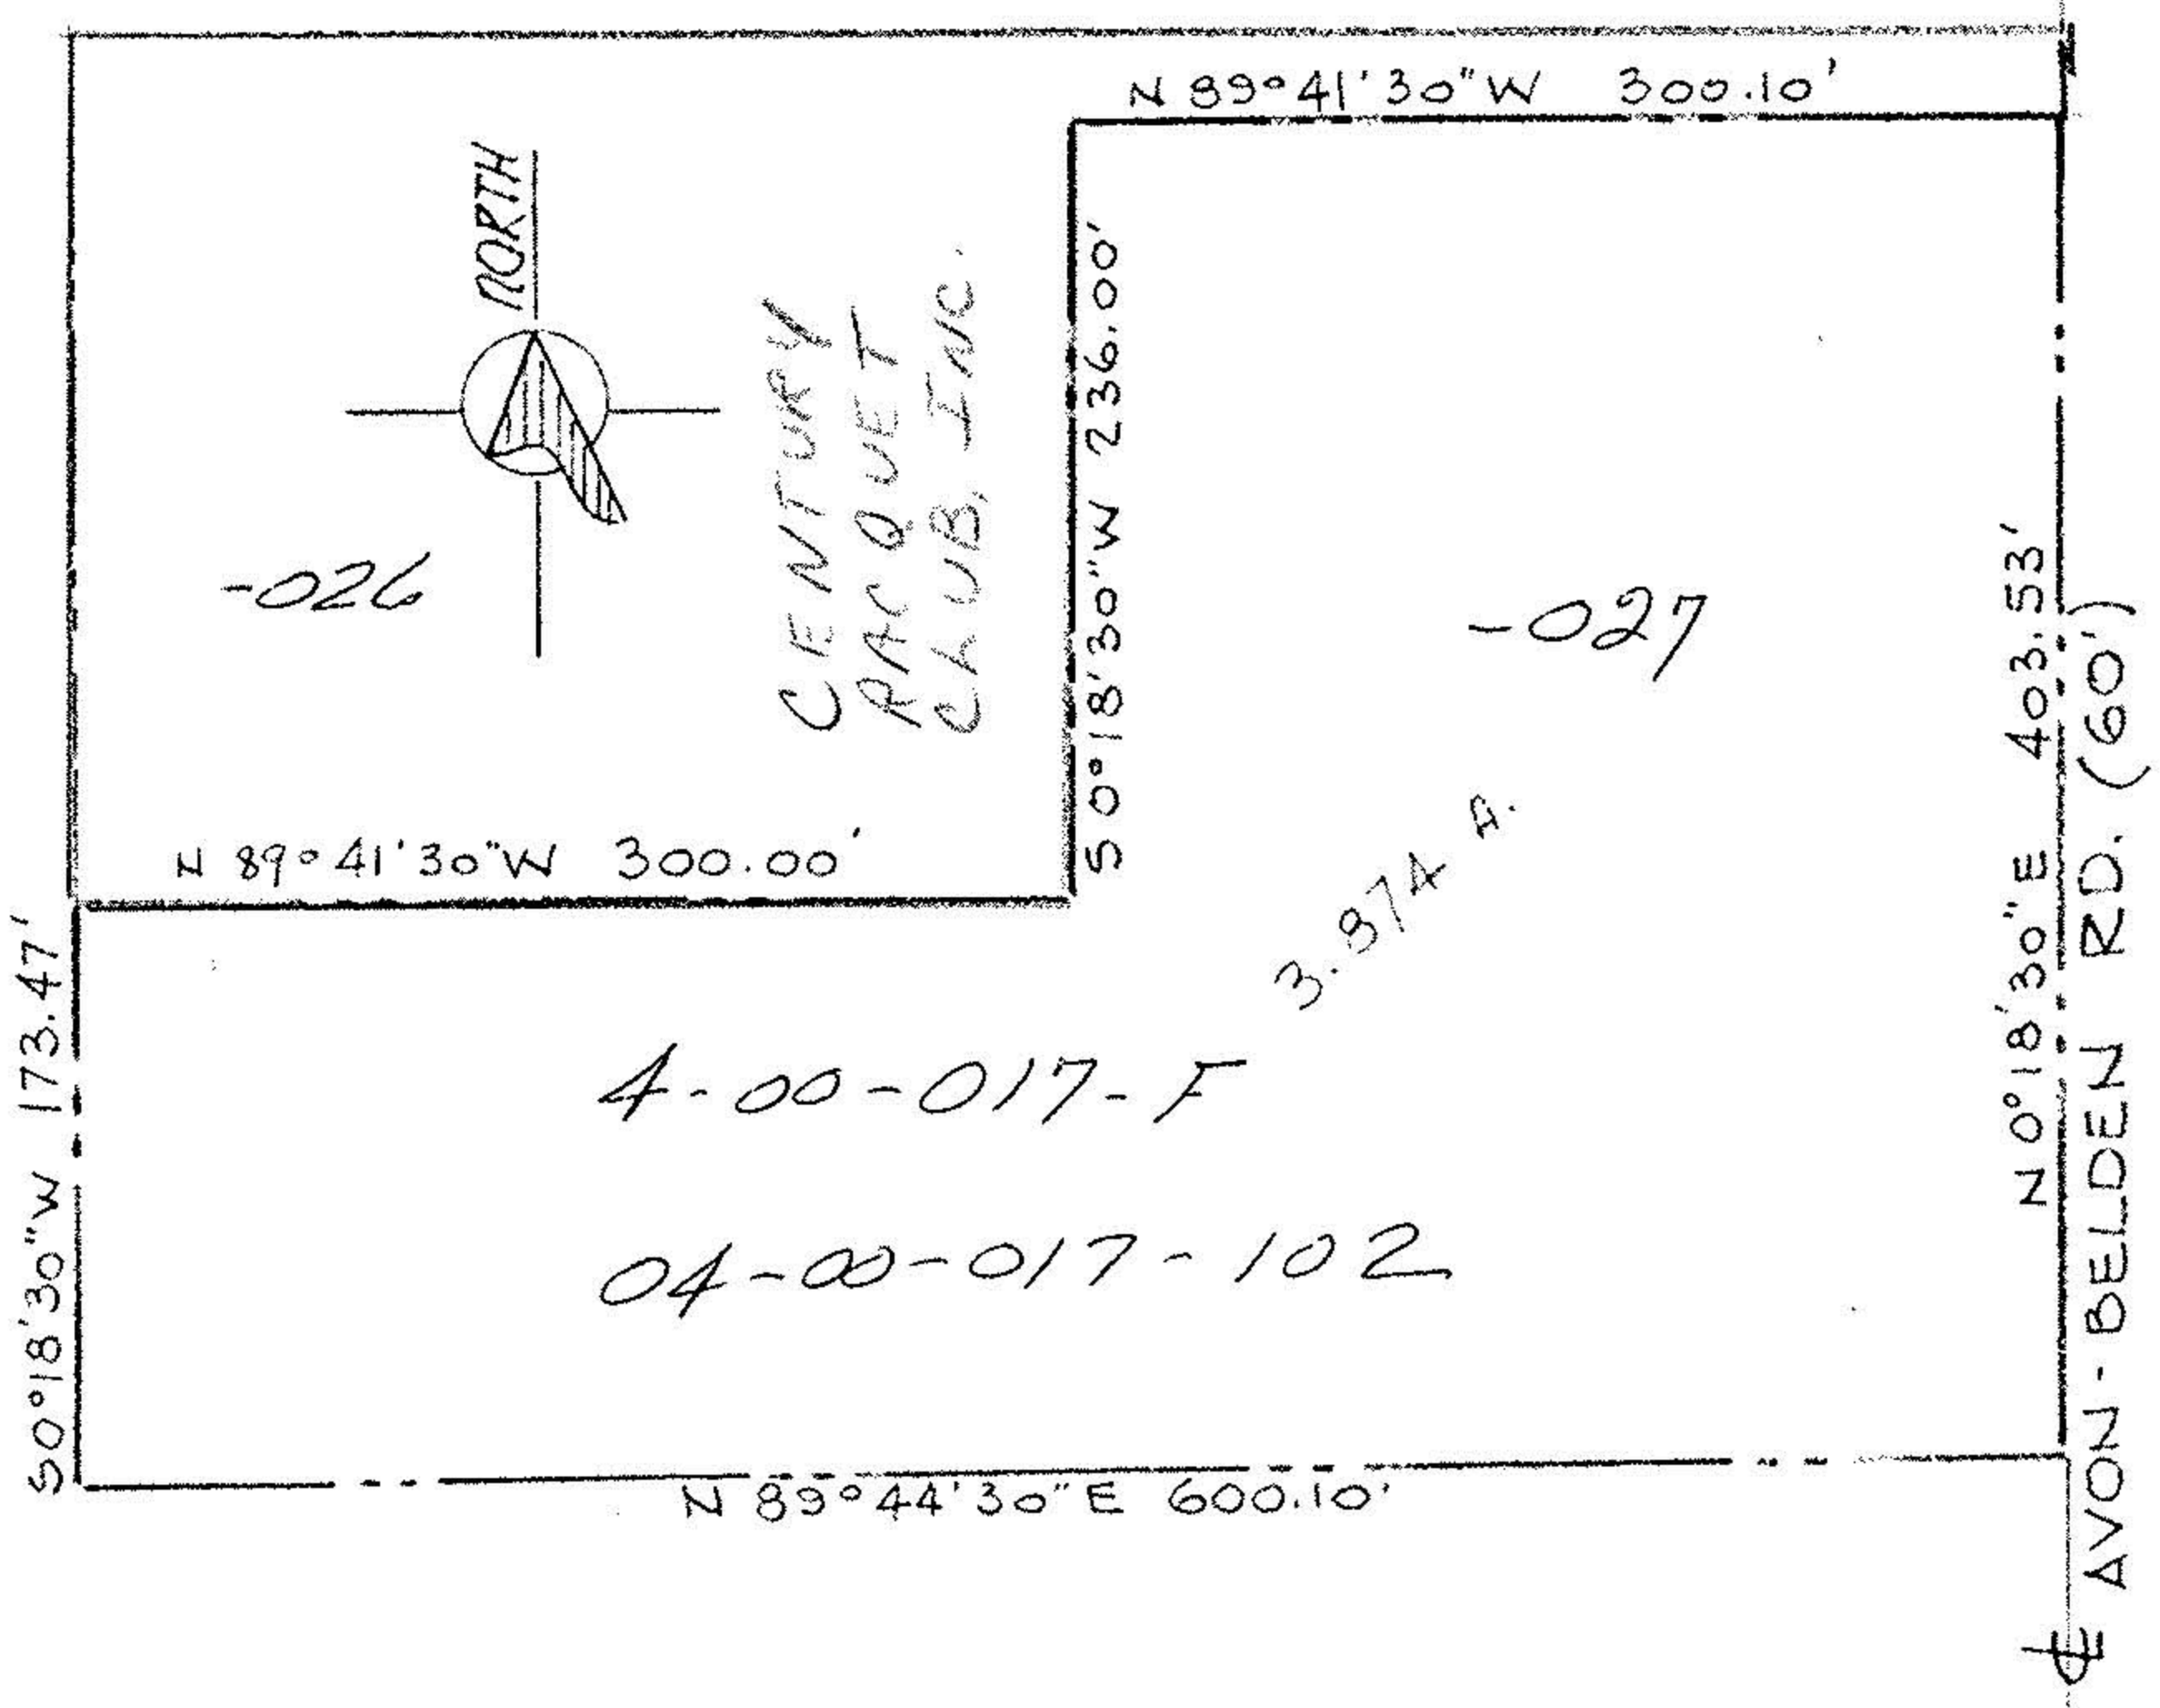

4-00-017-F
04-00-017-102

Section 17 Avon Twp.
4-00-017-F

CRC-SK2