

KLEINOEDER-SCHMIDT and ASSOCIATES

ENGINEERS - SURVEYORS - CONSULTANTS IN LAND PLANNING
ELYRIA - NORWALK - MEDINA OHIO

SURVEY

Sublot(s)

Subd'n

Township AVON

Orig. Lot(s)

County of LORAIN

Corporation CITY OF AVON LAKE

Tract


Sec. 18

State of Ohio

4-00-018-I, J

#17517

04-00-018-128-151

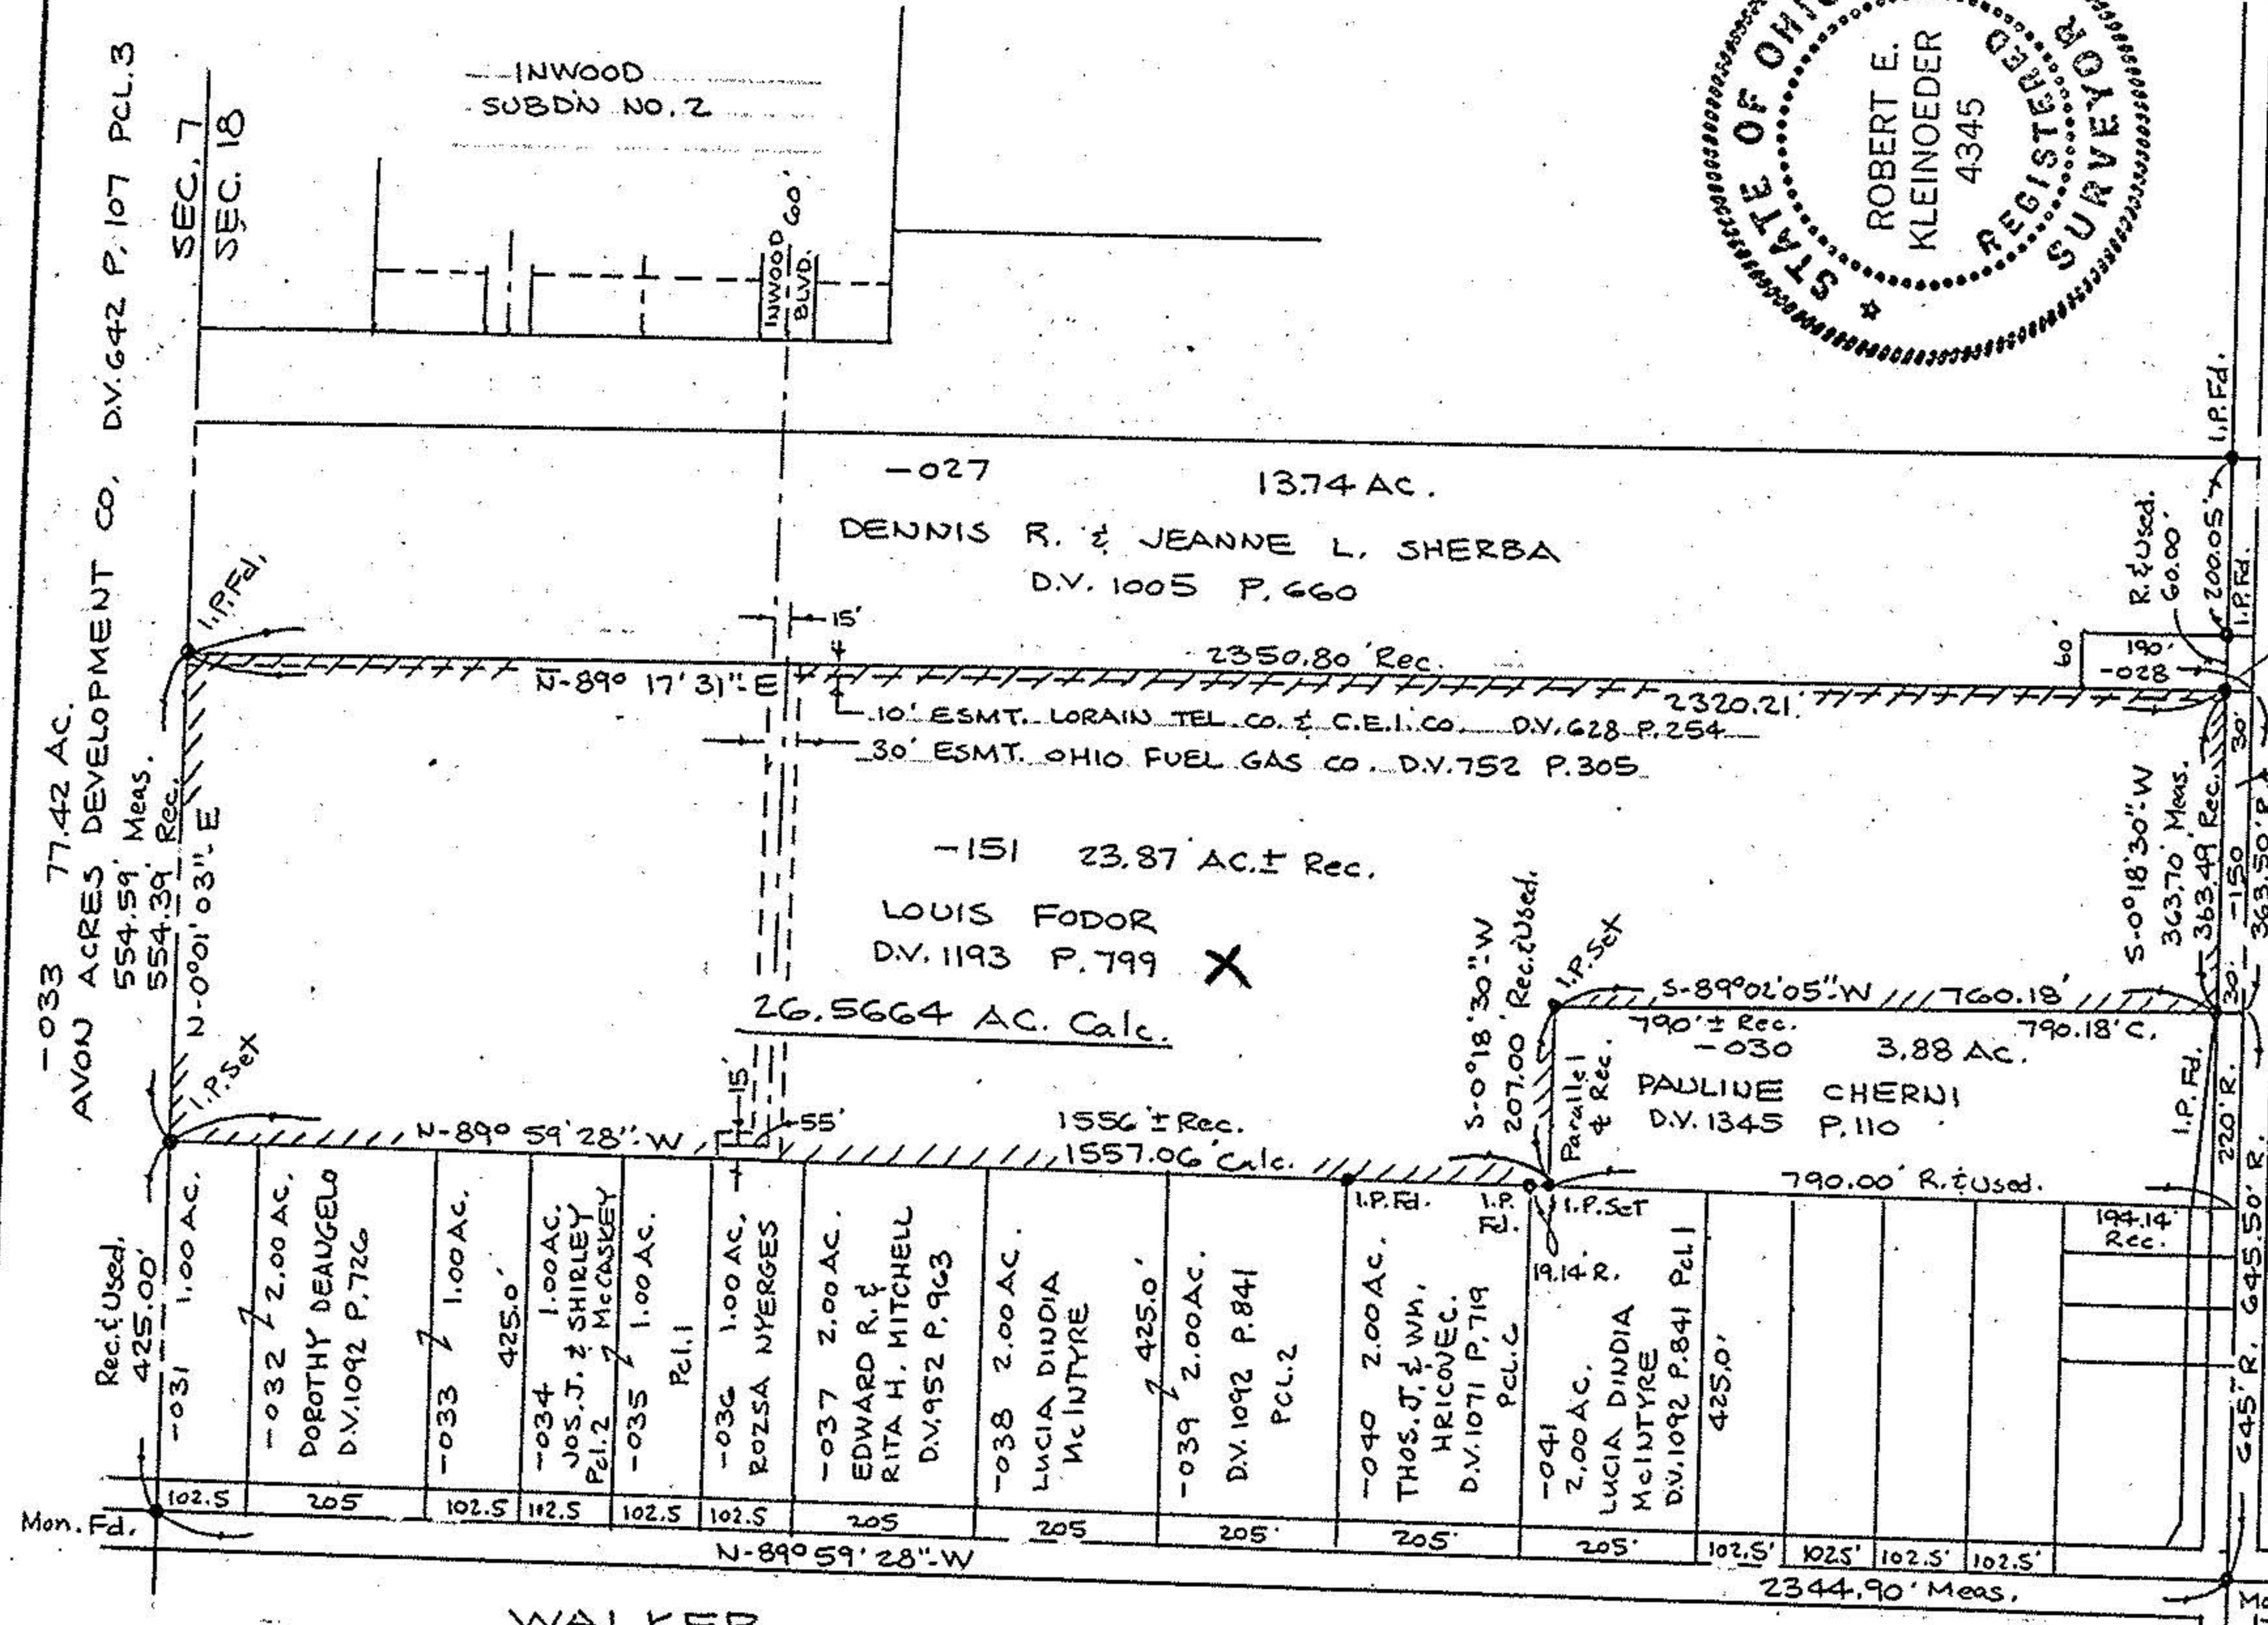

#17517
APPROVED
LORAIN CO.
MAP DEPT.
DATE 7-2-87
PAGE 4-00-018
BY C. FRANCIS
VOID AFTER 17517

Prepared for: J

KOPF CONST.

Scale: 1" = 300'

Date: 6-8-87

Dr. by: D.E.

Job No 87-164