


LAND SURVEY FOR CHRIS & LORI FOULTZ
 CITY OF AVON LAKE - LORAIN CO. OHIO
 AVON TOWNSHIP SECTION NO. 19 AND PART
 OF SUBLLOT 31 IN THE SUNSET PARK
 SUBDIVISION RECORDED IN VOL. 13 PAGE
 13 OF LORAIN CO. MAP RECORDS.

P.P.N 04-00-019-112-045

JAYCOX RD 60


S 3° 38' 10" W

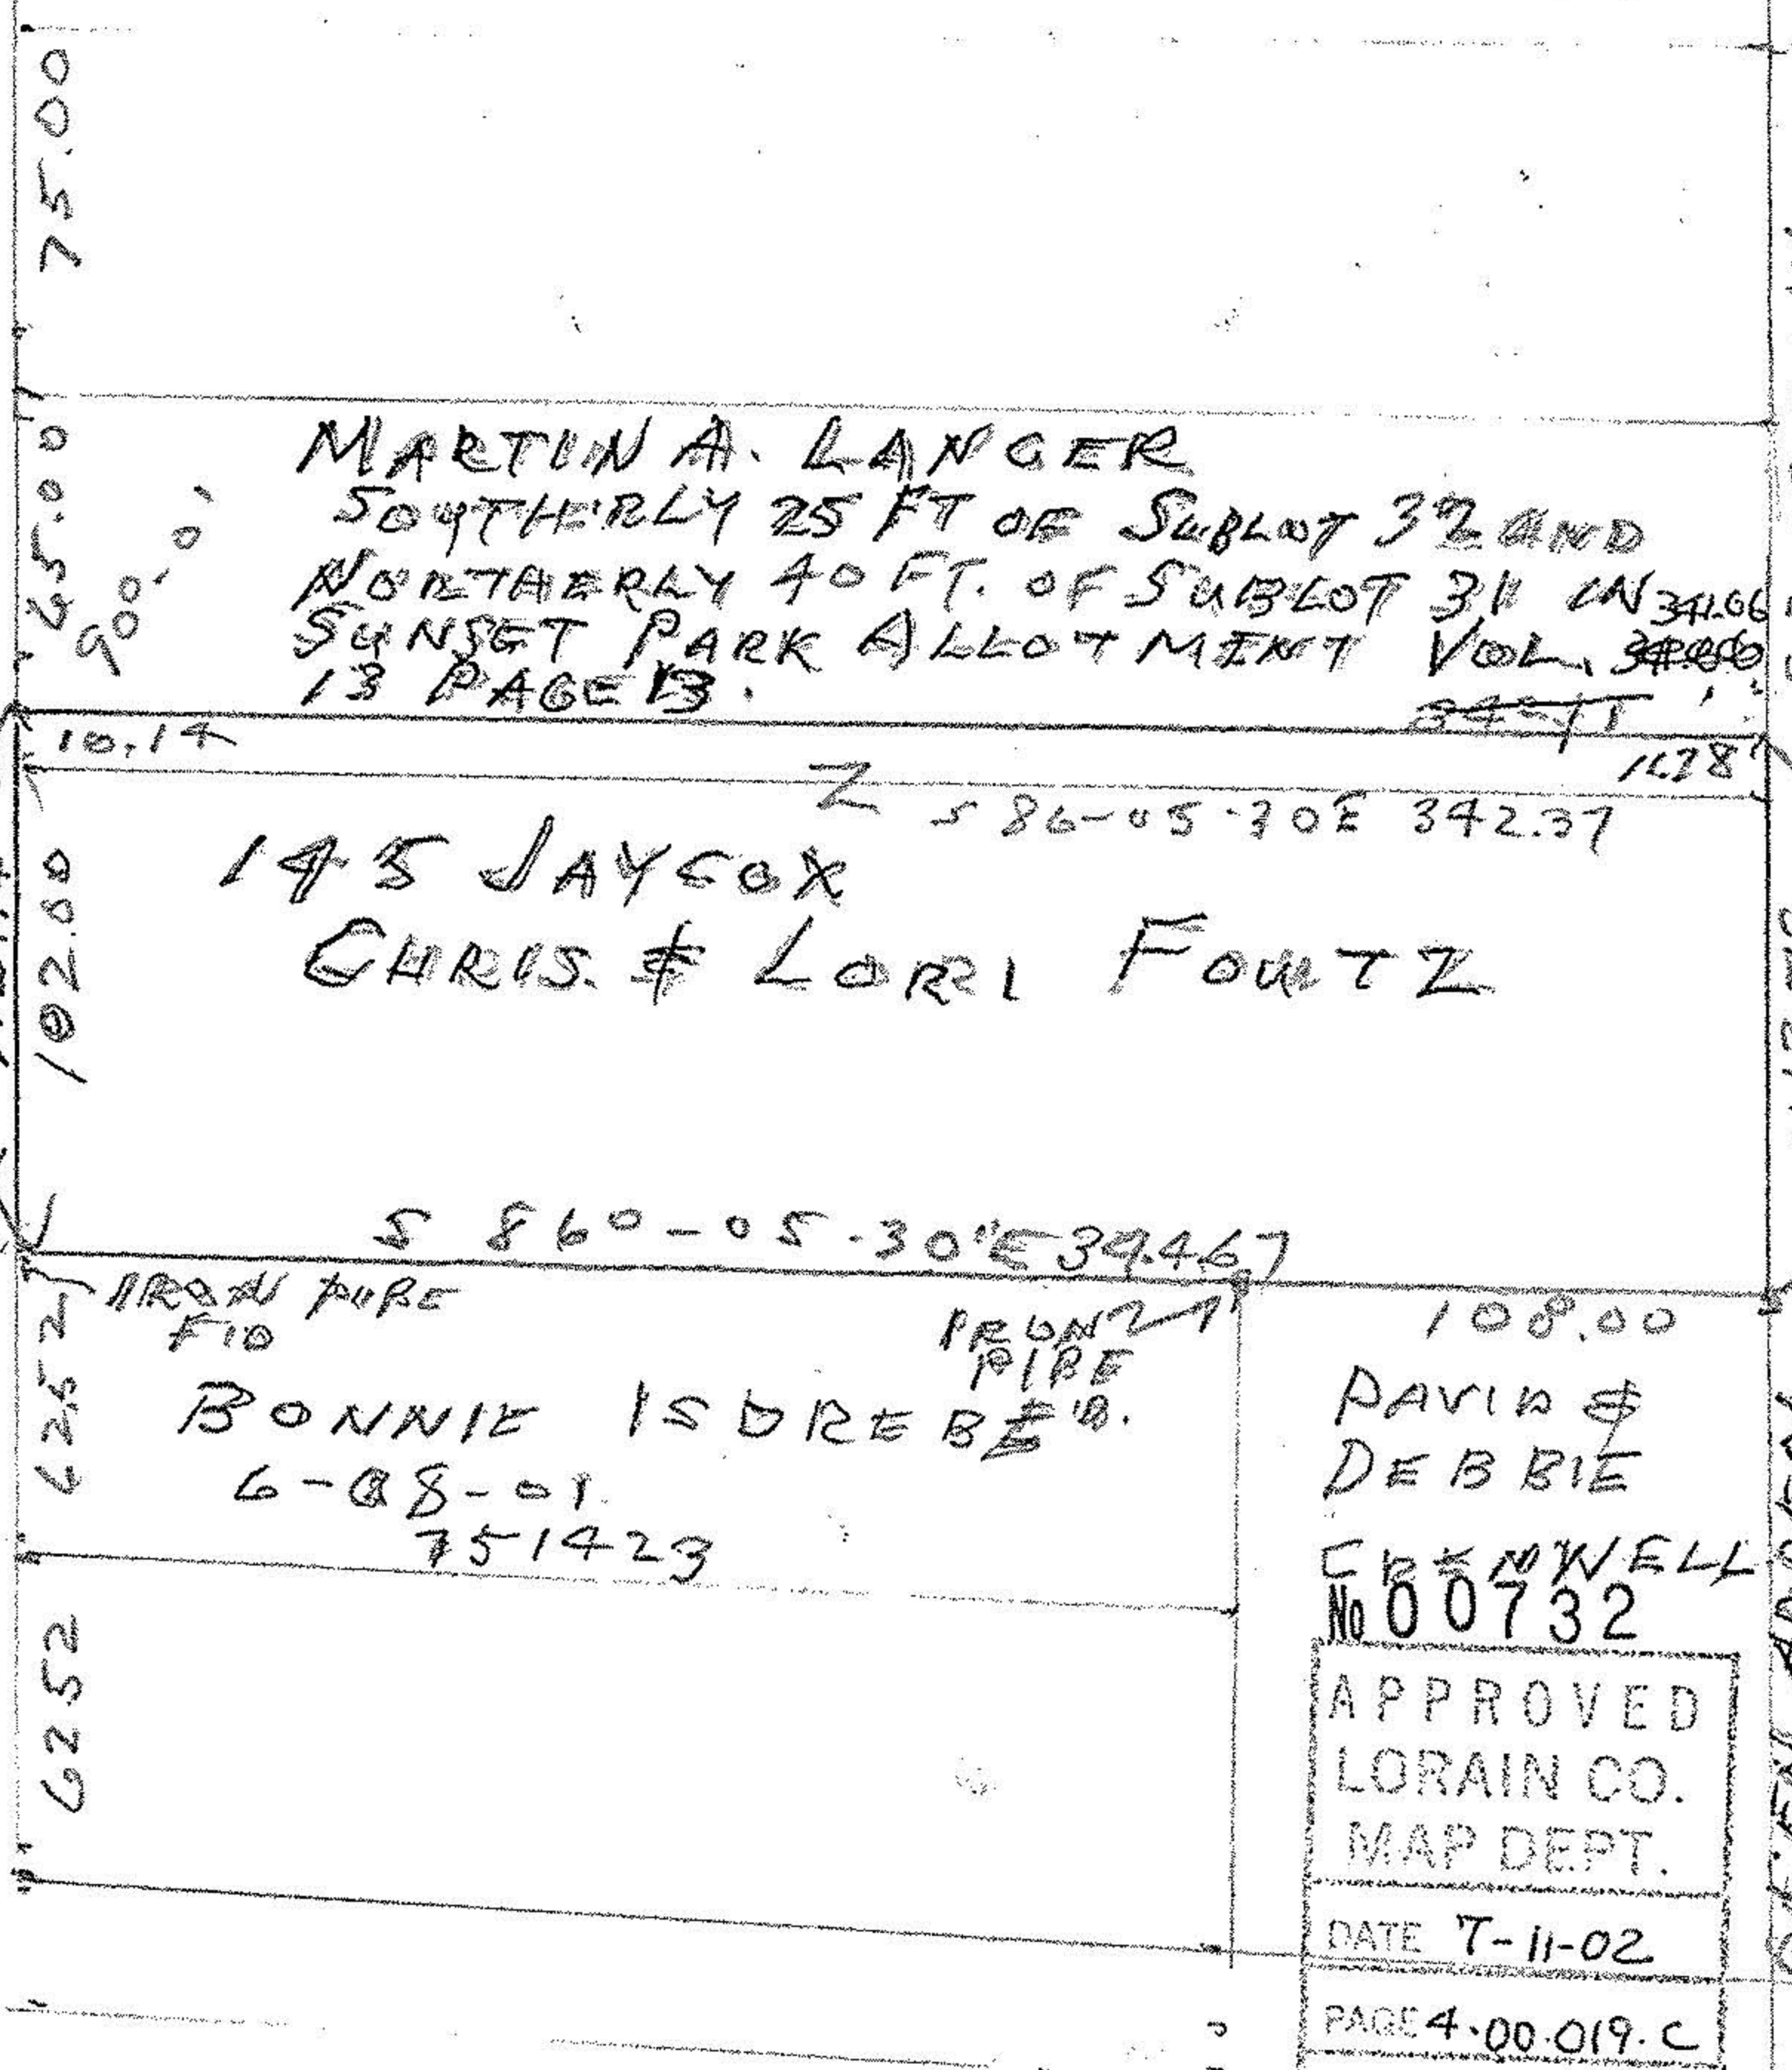

S 2° 07' 30\"/>

APPROVED
 LORAIN CO.
 MAP DEPT.
 DATE 7-11-02
 PAGE 4-00-019-C
 BY R. MAINES
 AND APPROVED 02-00732-A

ELECTRIC BLVD.

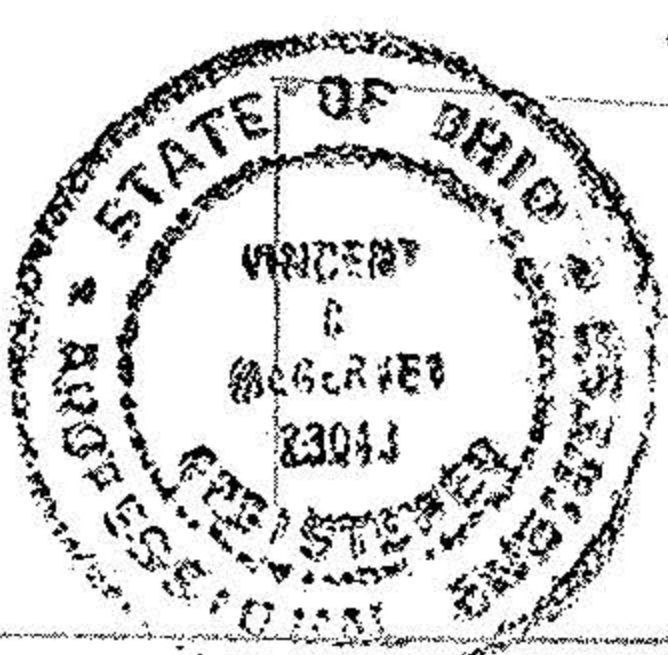

6-25-02 DISTANCES ARE IN FEET
 SCALE; AND DECIMAL PARTS, ALL
 1" = 60' OF WHICH TO BE CORRECT
 Neil C. McQuay A289
 CIVIL ENGINEER & SURVEYOR