


KS ASSOCIATES, INC.
 424 Middle Ave. P.O. Box 89
 ELYRIA, OHIO 44036
 (216) 322-6317

JOB FALKENSTEIN PARCELS 95-184
 SHEET NO. _____ OF _____
 CALCULATED BY _____ DATE _____
 CHECKED BY _____ DATE 05-11-95
 SCALE 1" = 30'

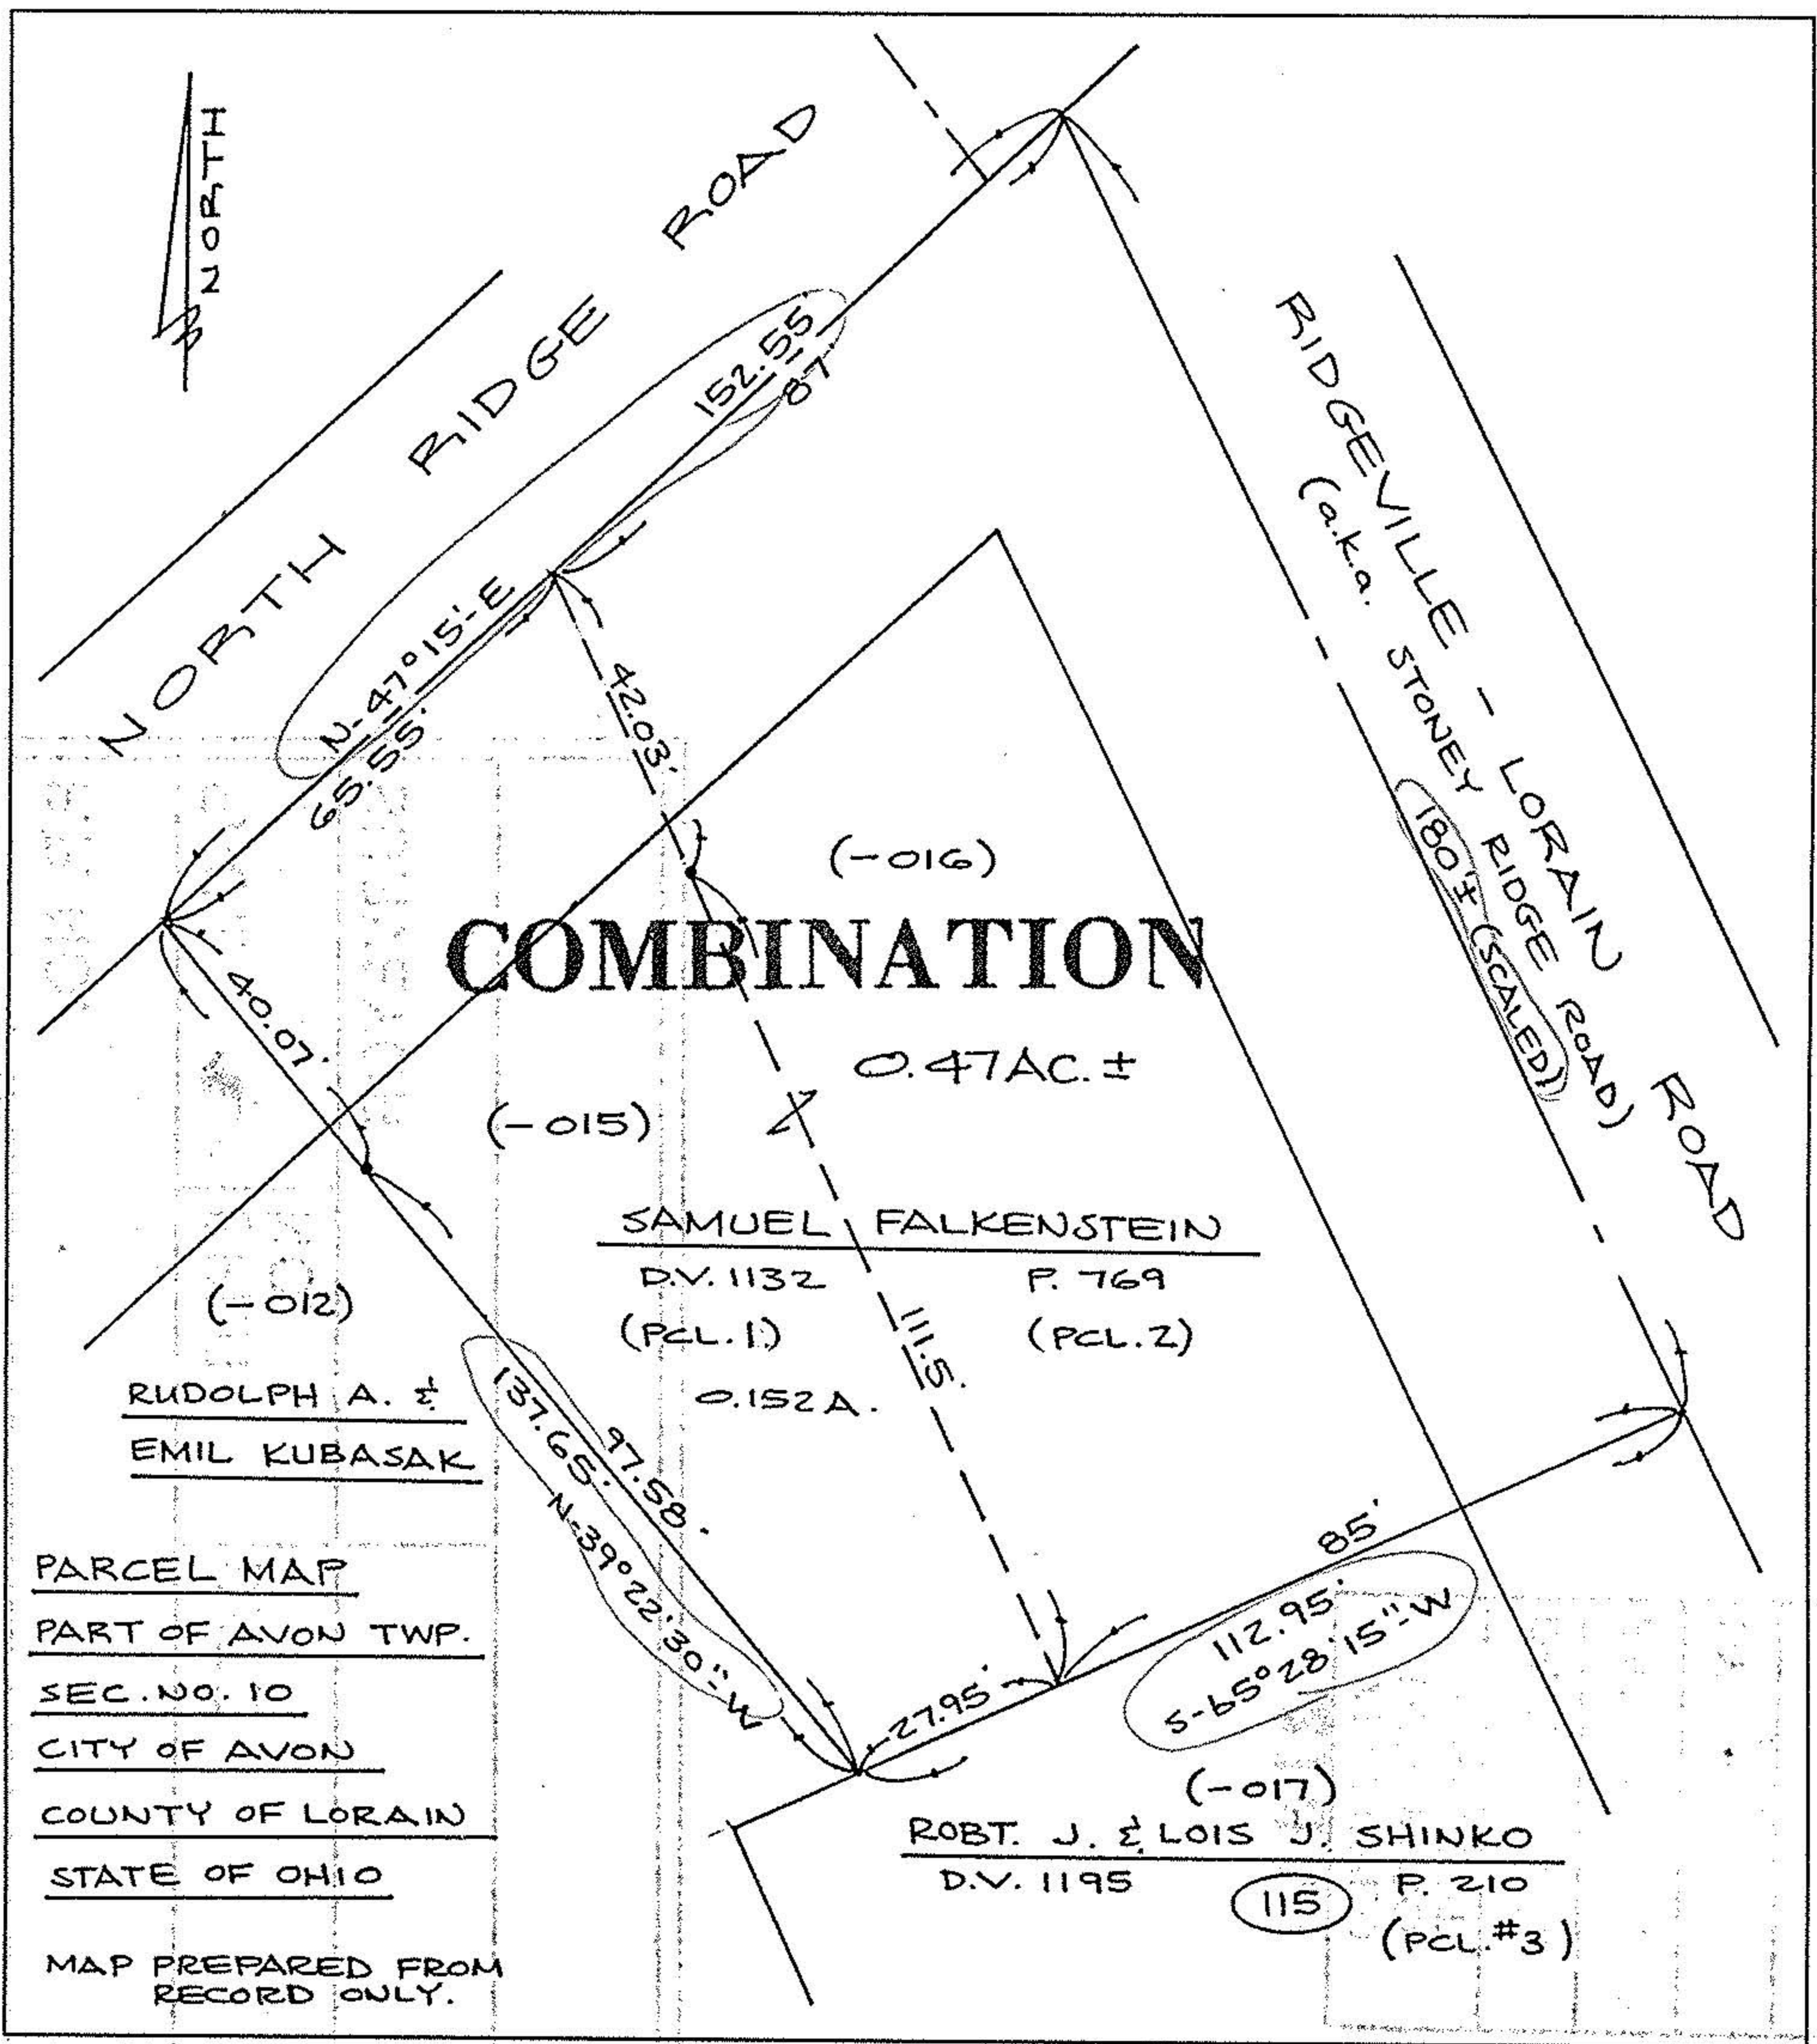

COMBINATION

(-016)
 0.47 AC. ±
 (-015)

SAMUEL FALKENSTEIN

D.V. 1132 P. 769
 (PCL. 1) (PCL. 2)

0.152 A.

(-012)
RUDOLPH A. &
 EMIL KUBASAK

(-017)
ROBT. J. & LOIS J. SHINKO

D.V. 1195 P. 210
 (PCL. #3)

PARCEL MAP
PART OF AVON TWP.
SEC. NO. 10
CITY OF AVON
COUNTY OF LORAIN
STATE OF OHIO

MAP PREPARED FROM
 RECORD ONLY.