

#10000

#15560

Approved by [Signature]

APPROVED
LORAIN CO.
MAP DEPT.

DATE 5-10-84

PAGE 4-00-011-D

BY T. McNamee

VOID



N

6-2-79

SURVEY FOR
HAYDEN MILLER OF
PART SECTION 11 CITY OF
MARIETTA, LORAIN COUNTY, OHIO
BY WILLIAM B. BARTON
REG. SURVEYOR NO. 4438
SCALE 1"=50'

I, here by certify this to be
a survey made by me

William B. Barton
Reg. Surveyor

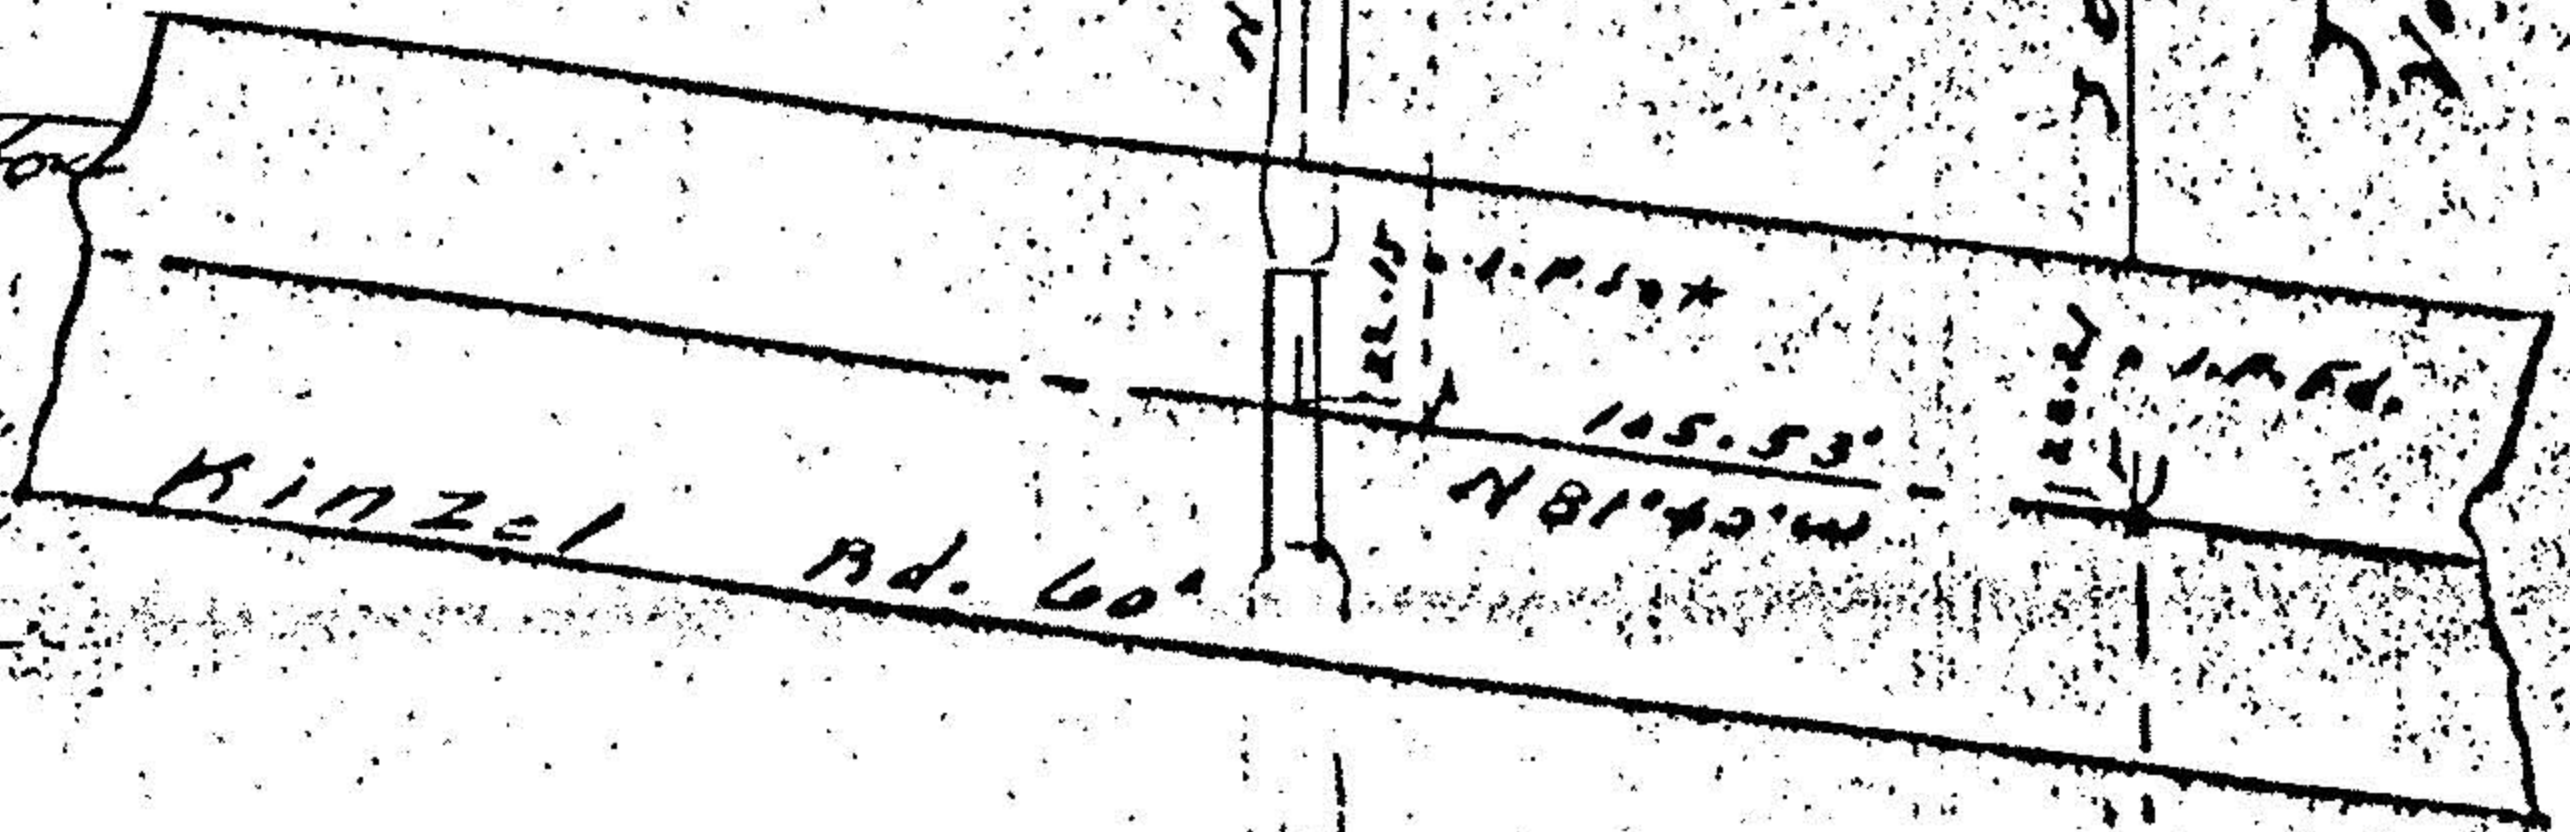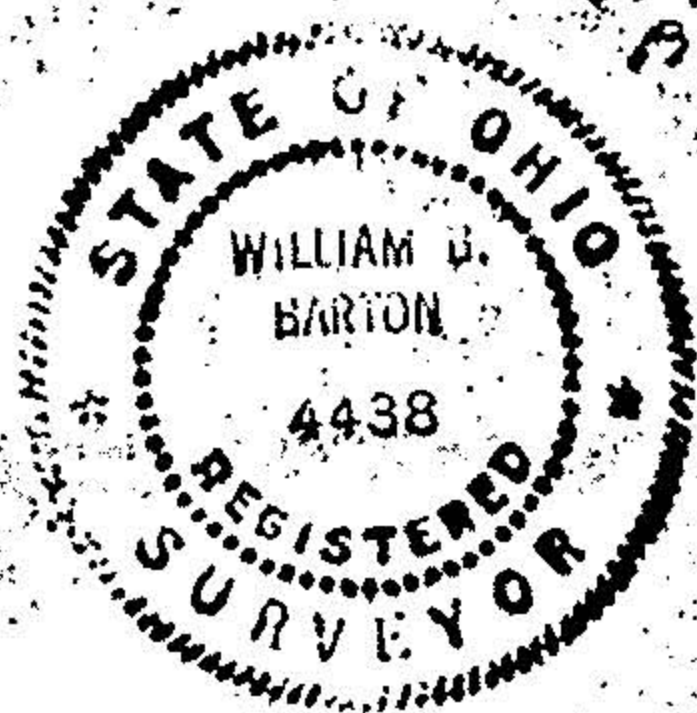

FLORIAN STREET

Section 11
Section 12

Julius Minzel
Vol. 298 P. 249

0.587 AC.

105.53'
N 81° 45' W

Minzel Rd. 60'