


4-00-012-B
16461
04-00-012-101-016

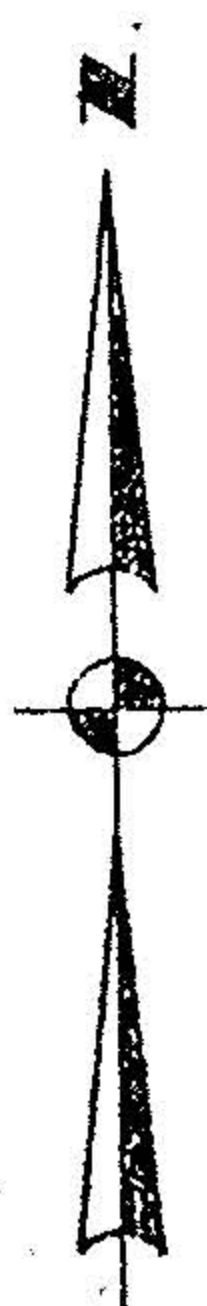

SURVEY FOR AL SCHERLER

SEC. 12 AVON TWP.
LORAIN COUNTY - OHIO

SCALE 1"=100' OCT. 1978

LAUNDON • SIMON • CAHL & ASSOC.


ENGINEERS SURVEYORS

JOB 78-804 F.B. 71-42

REVISED FOR:

GREGORY M. ALLEN
10-9-85 Job N° 85-1431

IDA S. KOLYNO
7-06-71 V. 1027 P. 300

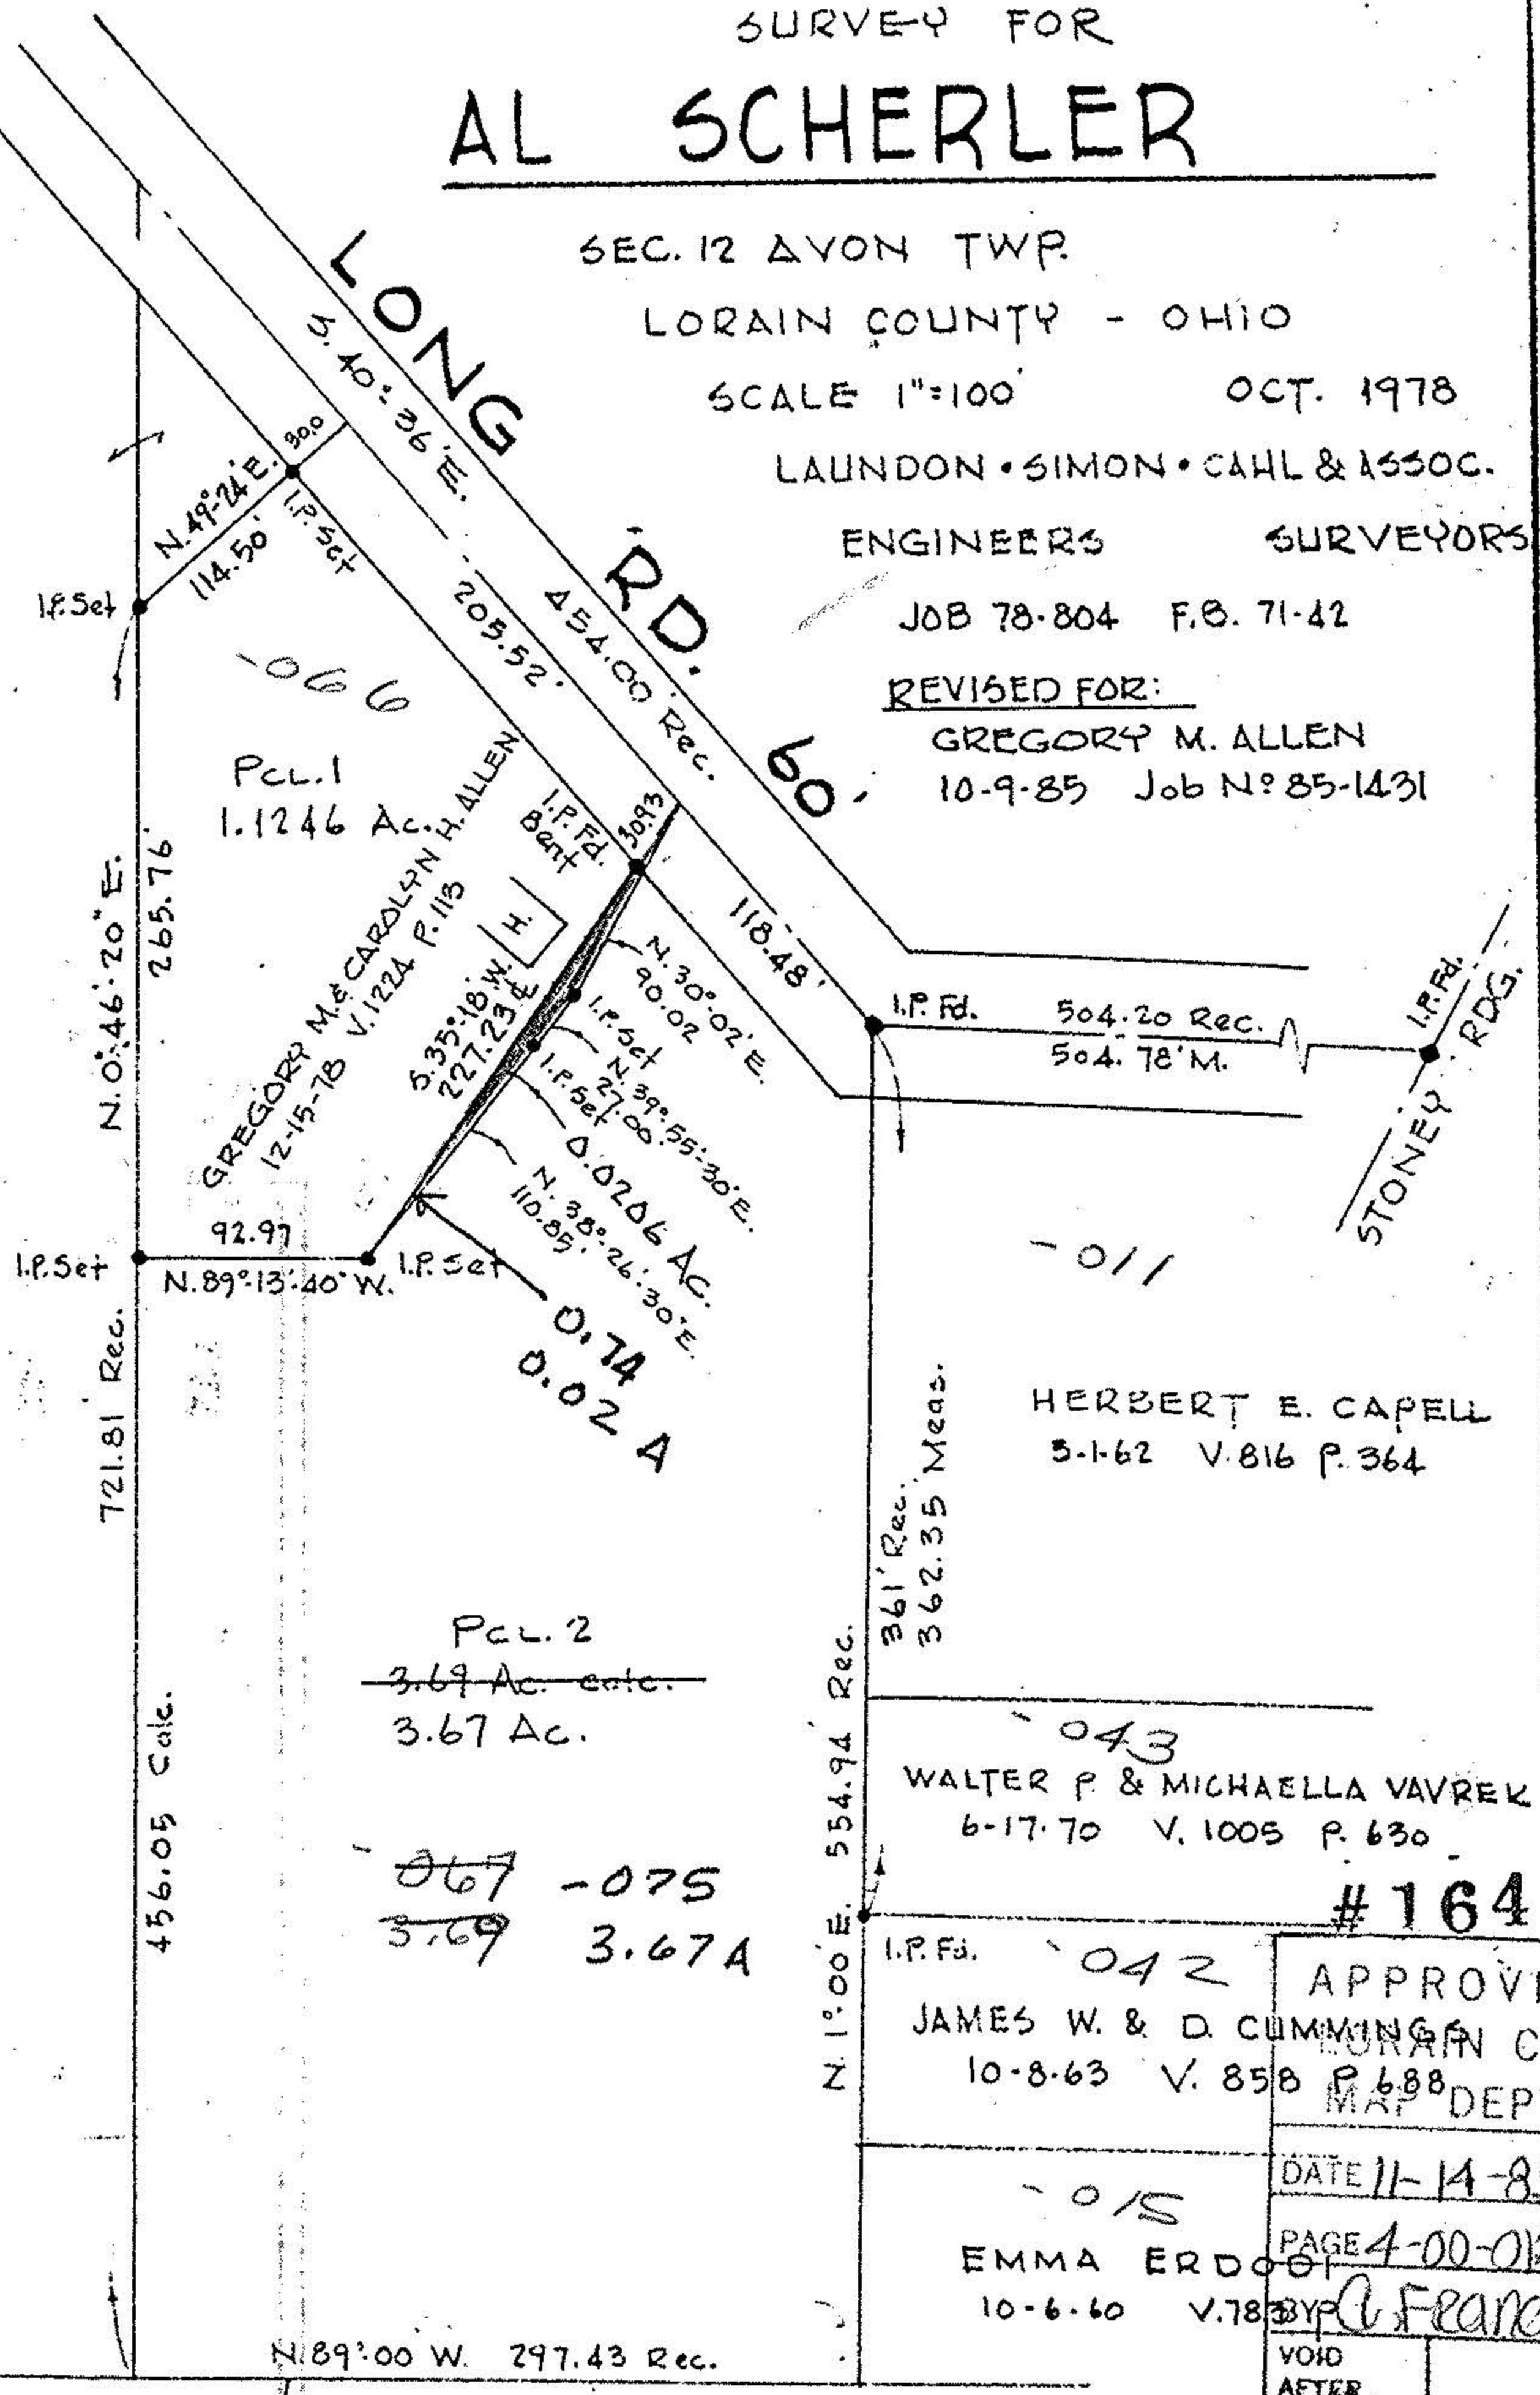

JAMES G. & RUTH M. HEALY
5-05-67 V. 943 P. 782

GENE E. & E. J. BLAKE
9-10-57 V. 703 P. 635

OCT 08 1985

APPROVED	
JAMES W. & D. CUMMINGS CO.	
10-8-63 V. 858 P. 688	
MAY DEPT.	
DATE 11-14-85	
PAGE 4-00-012-B	
BY C. FEARENS	
VOID	
AFTER	