


03-00-105-104-

#18623

20-105-A

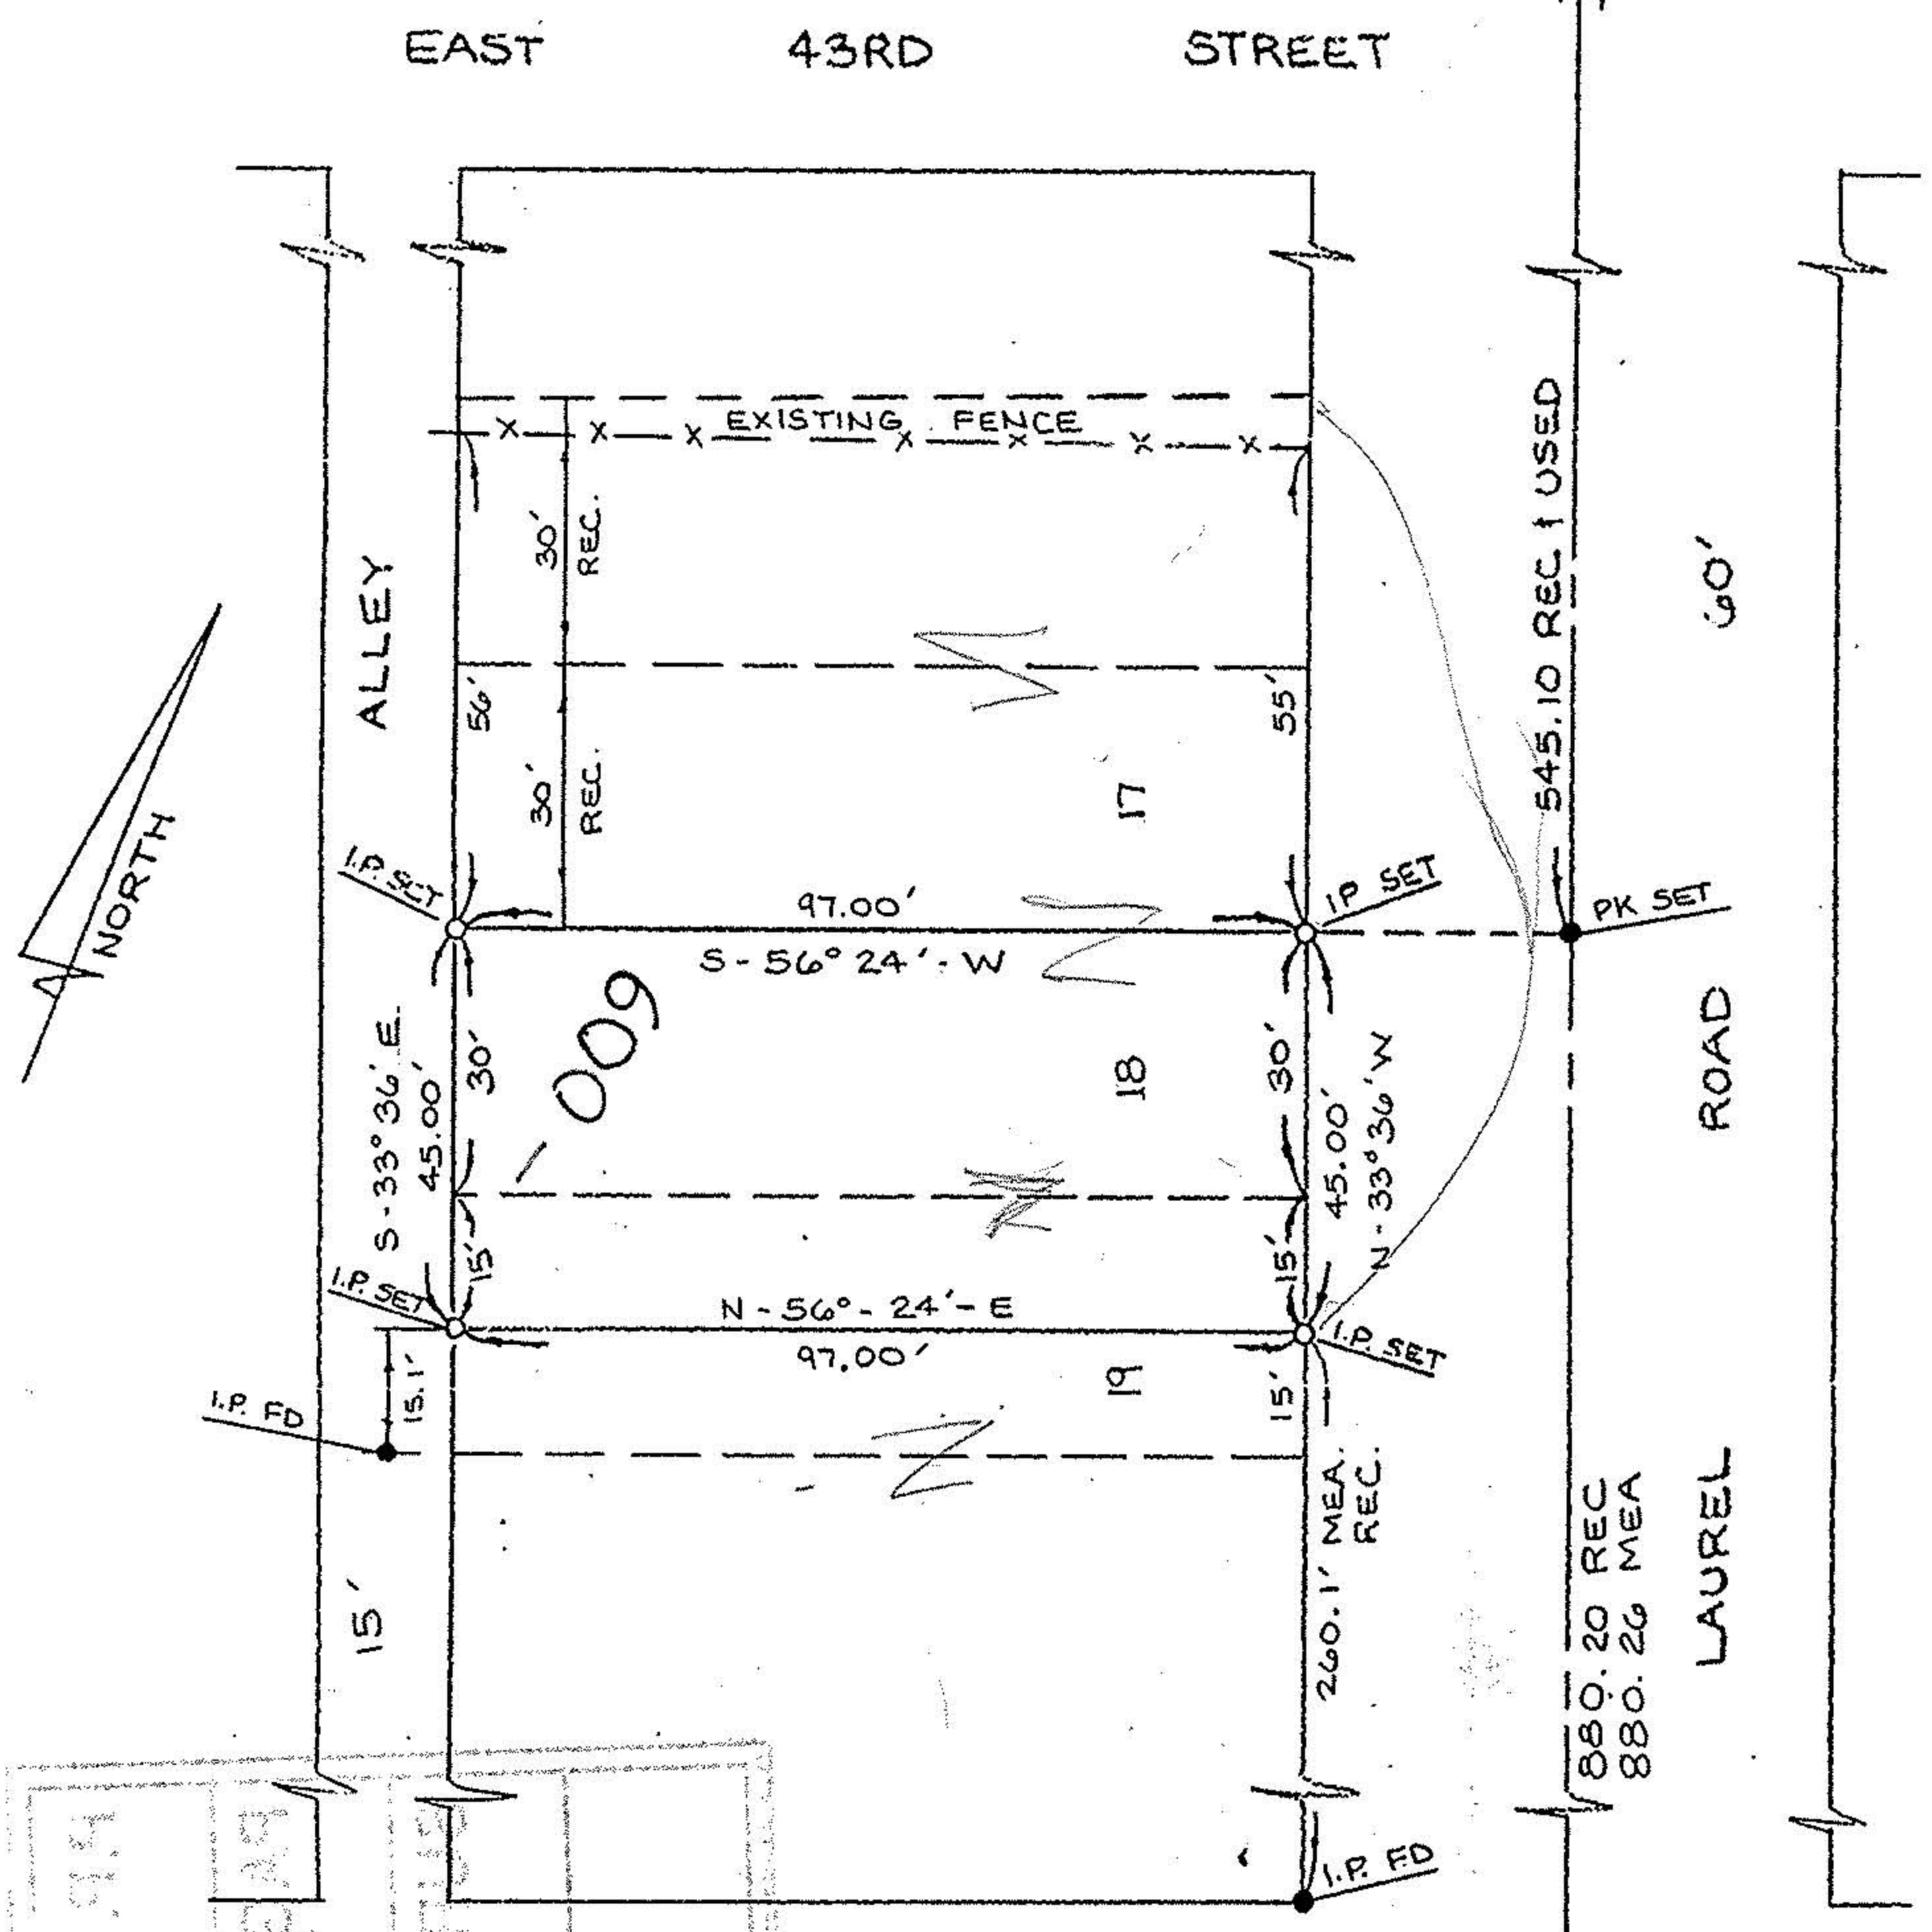

#18623

APPROVED
LORAIN CO.
MAP DEPT.

DATE 9-12-89

PAGE 3-00-105-A

BY T-McNair

VOID AFTER 18623

SURVEY MAP

SUBLOT NO. 18 AND
PART OF SUBLOT NO. 19
IN BLOCK 24
THE CENTRAL DIVISION
P.V. 9 P. 5

CITY OF LORAIN
COUNTY OF LORAIN

STATE OF OHIO

APPROVED
DESCRIPTION ONLY
3-August-1989
City of Lorain
Patrick M. Shannon
Engineering Dept.

SCALE: 1" = 30' MAY 25, 1989

Prepared By
KS ASSOCIATES INC.
ENGINEERS SURVEYERS

APPROVED BY THE LORAIN CITY PLANNING
COMMISSION. NO PLAT REQUIRED



David Elwell
REG. SURVEYOR No. 6333

18623