


3-110-107-B

1975-07-06

Revised Map Part of C.L. 107 Sheffield Twp. Lorain Co. Ohio Scale 1" = 100'  
July 6, 1975 By Arnold F. Koepp Registered Surveyor

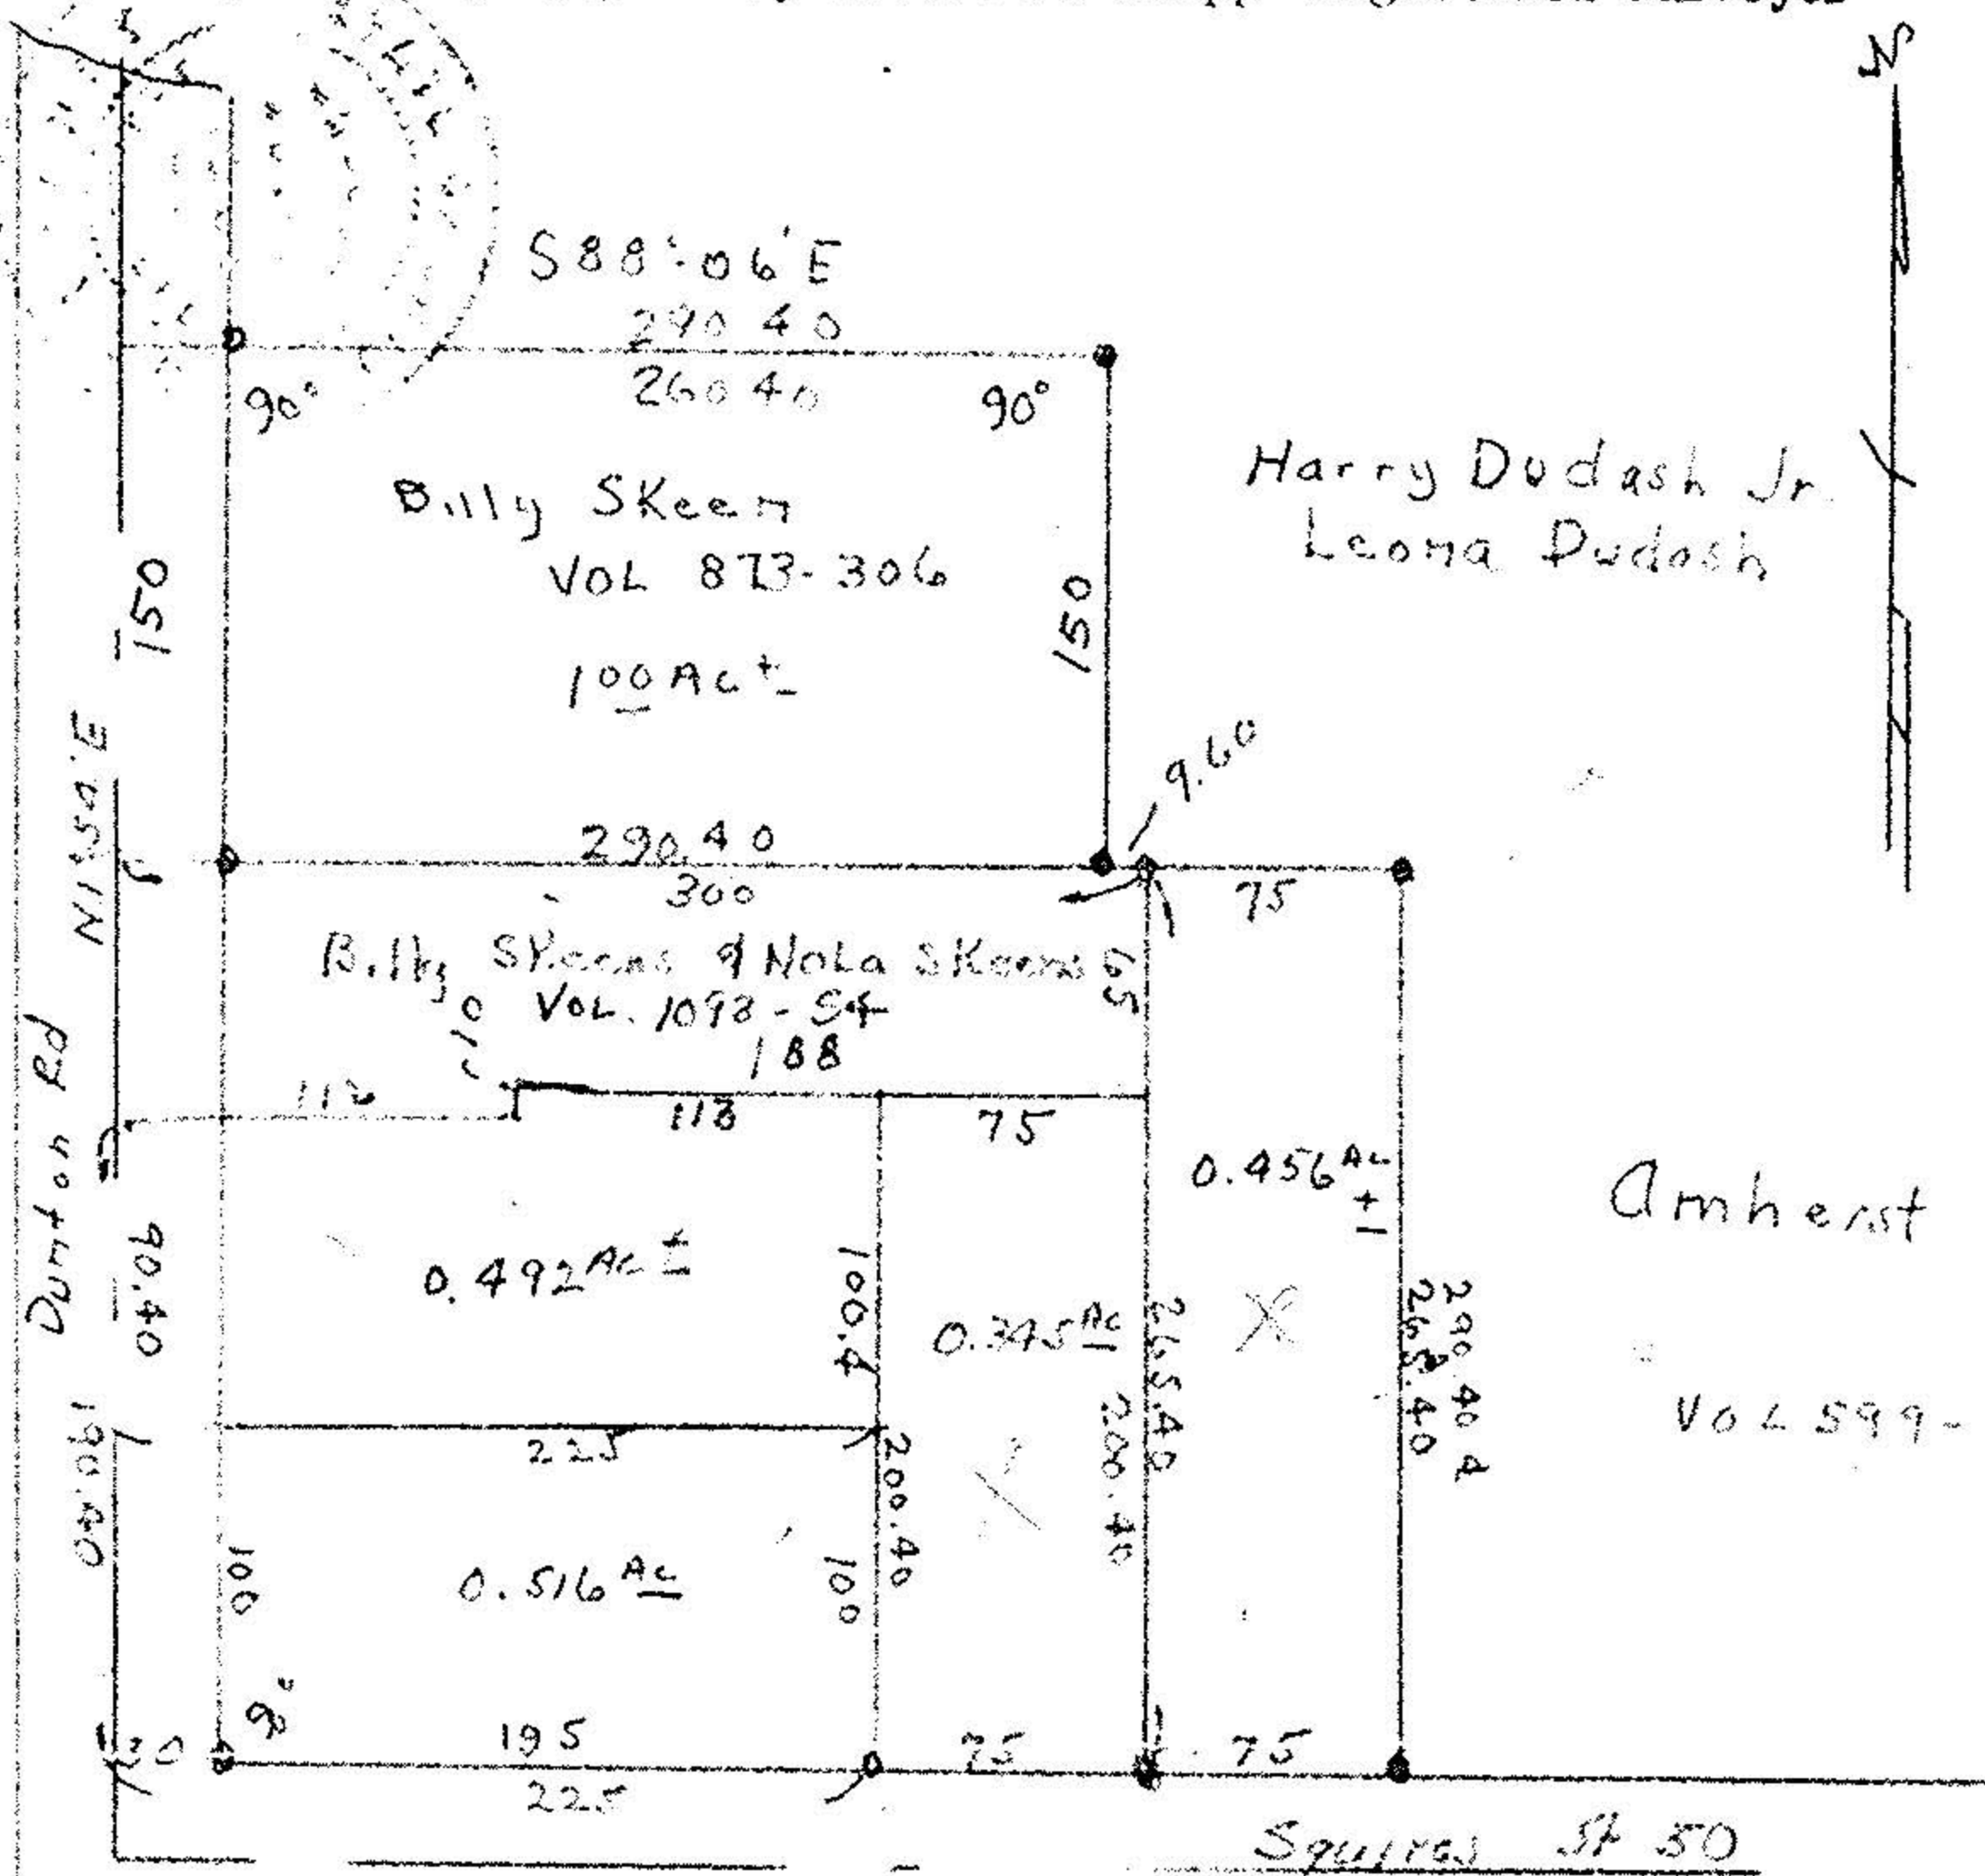

Amherst Hwco Co  
VOL 599-143

**APPROVED**

AS TO DESCRIPTION ONLY

DUNTON ALLOT 4 - Aug - 1981

City of Lorain

Per Patrick Mc-Dannan

Engineering Dept.

VOL II P. 35

HALL

288337.0

APPROVED BY THE LORAIN CITY PLANNING COMMISSION..... NO PLAT REQUIRED

Louise Rodgers  
SECRETARY LORAIN CITY PLANNING COMMISSION